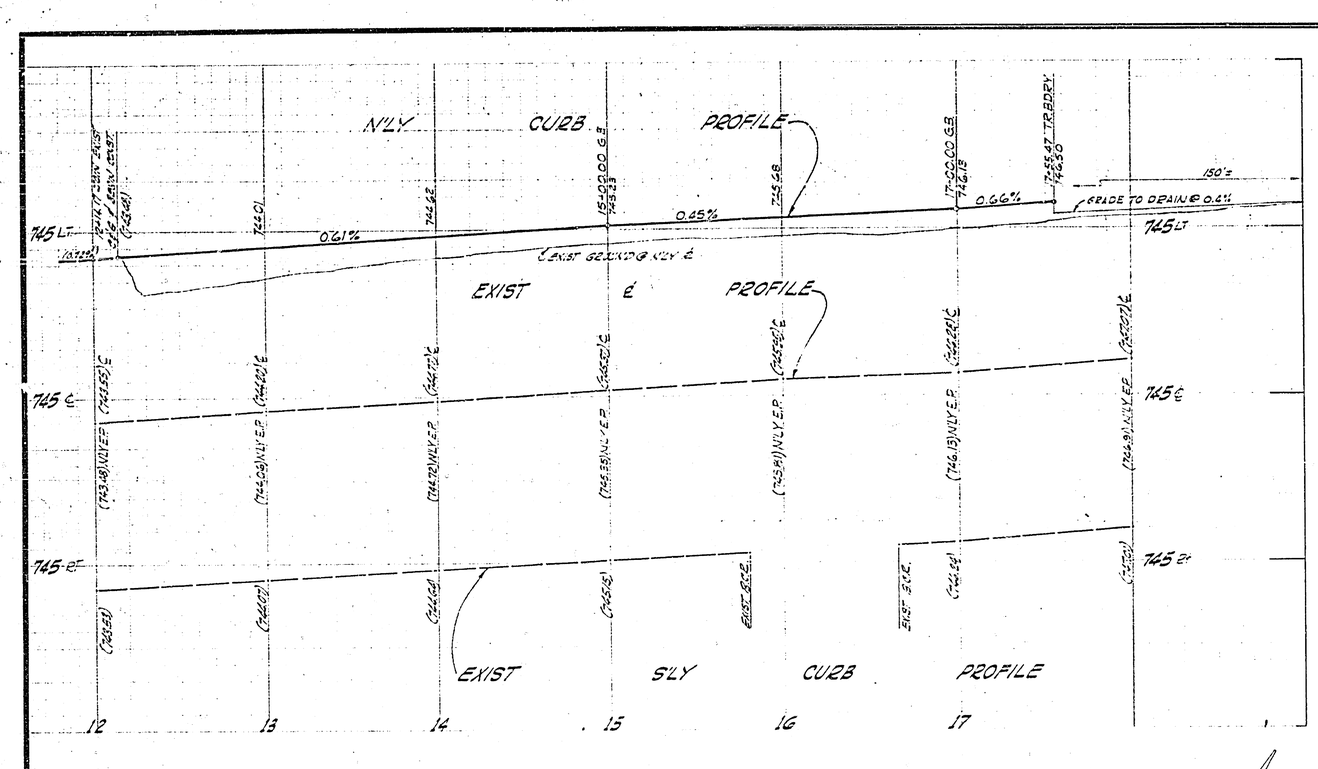

BENCH MARK: F.B. 706/52
PK. NAIL IN S.E. CB. RETURN
FILLMORE ST. & DORSET DR.
ELEV. 755.750

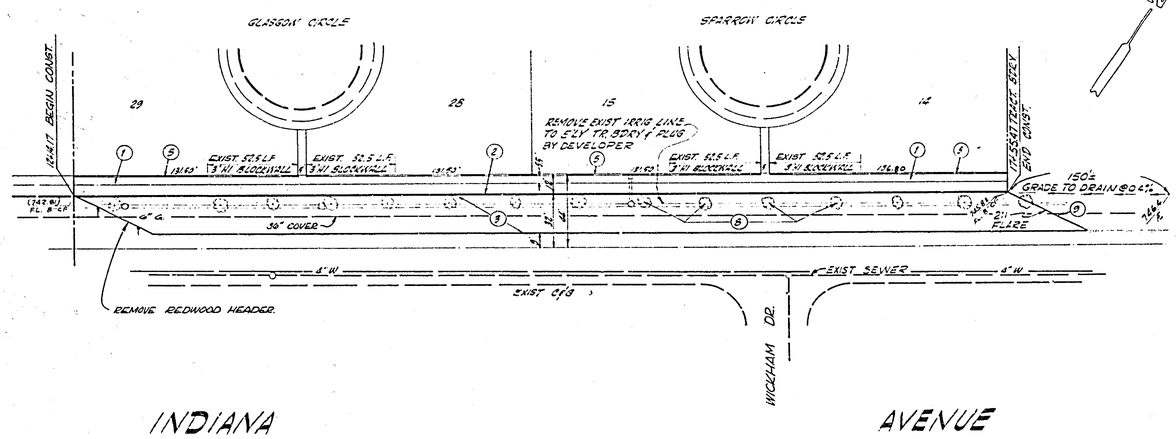

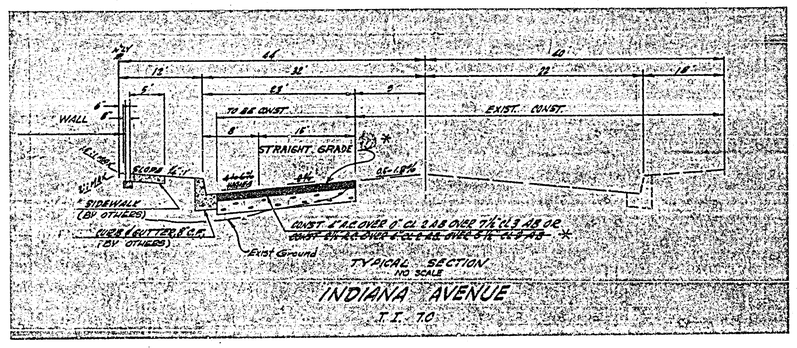

CONSTRUCTION NOTES

1. SIDEWALK (BY OTHERS).
2. CURB & GUTTER, 8" C.F. (BY OTHERS)
3. A.C. OVER A.B. TO BE CONST (SEE TYP. CROSS SECTION).
5. EXIST. 6" HI BLOCKWALL.
8. FORMER TREE SITES WHICH SHALL BE COMPACTED TO A DEPTH OF 3'.
9. INSTALL 2"x4" REDWOOD HEADER.

* AS BUILT JHW 10-4-71

ADAPTED FROM PLAN R-1490

IRRIGATION DIVISION
APPROVED BY: [signature] 6-2-71 DATE

PREPARED IN THE OFFICES OF
VOORHEIS-TRINDLE-NELSON
2301 CAMPUS DRIVE
IRVINE, CALIFORNIA
APPROVED BY: [signature] 7-2-71
JACK MAHONEY R.C.E. 14325 DATE

MARK	REVISIONS	APPR.	DATE

DESIGNED BY [signature] DRAWN BY R.M. CHECKED BY [signature]

CITY OF RIVERSIDE, CALIFORNIA
DEPARTMENT OF PUBLIC WORKS

APPROVED BY	BY	DATE
OFFICE ENGINEER	[signature]	7/27
PARK DEPARTMENT	—	—
TRAFFIC DIVISION	[signature]	7/27
ASSISTANT CITY ENG.		

APPROVED BY [signature]
DIRECTOR OF PUBLIC WORKS
DATE 7/28/71

INDIANA AVENUE
FROM FENSMUIR ST. TO WICKHAM DR.
TRACT 3651
CITY PARTICIPATION

HORIZ. SCALE: 1" = 40' VERT. SCALE: 1" = 4'

PROJECT NO. R-1495
SHEET 1 OF 1
FILE NO.