CONSTRUCTION NOTES

1. EXISTING SIDEWALK AND CURB & GUTTER MAY BE LEFT IN PLACE WHERE THEY WILL NOT CONFLICT WITH PROPOSED CONSTRUCTION.
2. TRANSITION NEW CONSTRUCTION TO MEET EXISTING AS DIRECTED BY THE INSPECTOR.
3. STORM DRAIN PIPE SHALL BE INSTALLED PER STD. DWG. 452, CASE I, UNLESS OTHERWISE SPECIFIED ON THE PLANS.
4. ALL TREES SHALL REMAIN EXCEPT WHERE SHOWN ON THE PLAN TO BE TRANSPLANTED.
5. ADJUSTMENT OF TRAFFIC PULLBOXES TO NEW SIDEWALK GRADE – REMOVE EXISTING PULLBOXES, FURNISH & INSTALL NEW #5 PULLBOXES AND EXTENSIONS (TWO REQUIRED AT MOST LOCATIONS) PER STD. DWG. 606. PROVIDE RECESS TYPE STEEL PULLBOX COVERS AT DRIVEWAY LOCATIONS.
6. REMOVE AND SALVAGE EXIST. P.I.B. AND POST. INSTALL NEW TYPE I STANDARD FOUNDATION (ANCHOR BOLTS – CITY FURNISHED), AND PROVIDE APPROX. 8' OF 1½" CONDUIT FROM FOUNDATION TO PULLBOX.
7. STREET LIGHT RECONSTRUCTION SHALL CONFORM TO PART III, SECTION 307-2 OF THE SPECIAL PROVISIONS AND THE CITY OF RIVERSIDE PUBLIC UTILITIES DEPARTMENT, SPEC. NO. 119 FOR STREET LIGHT CONSTRUCTION.

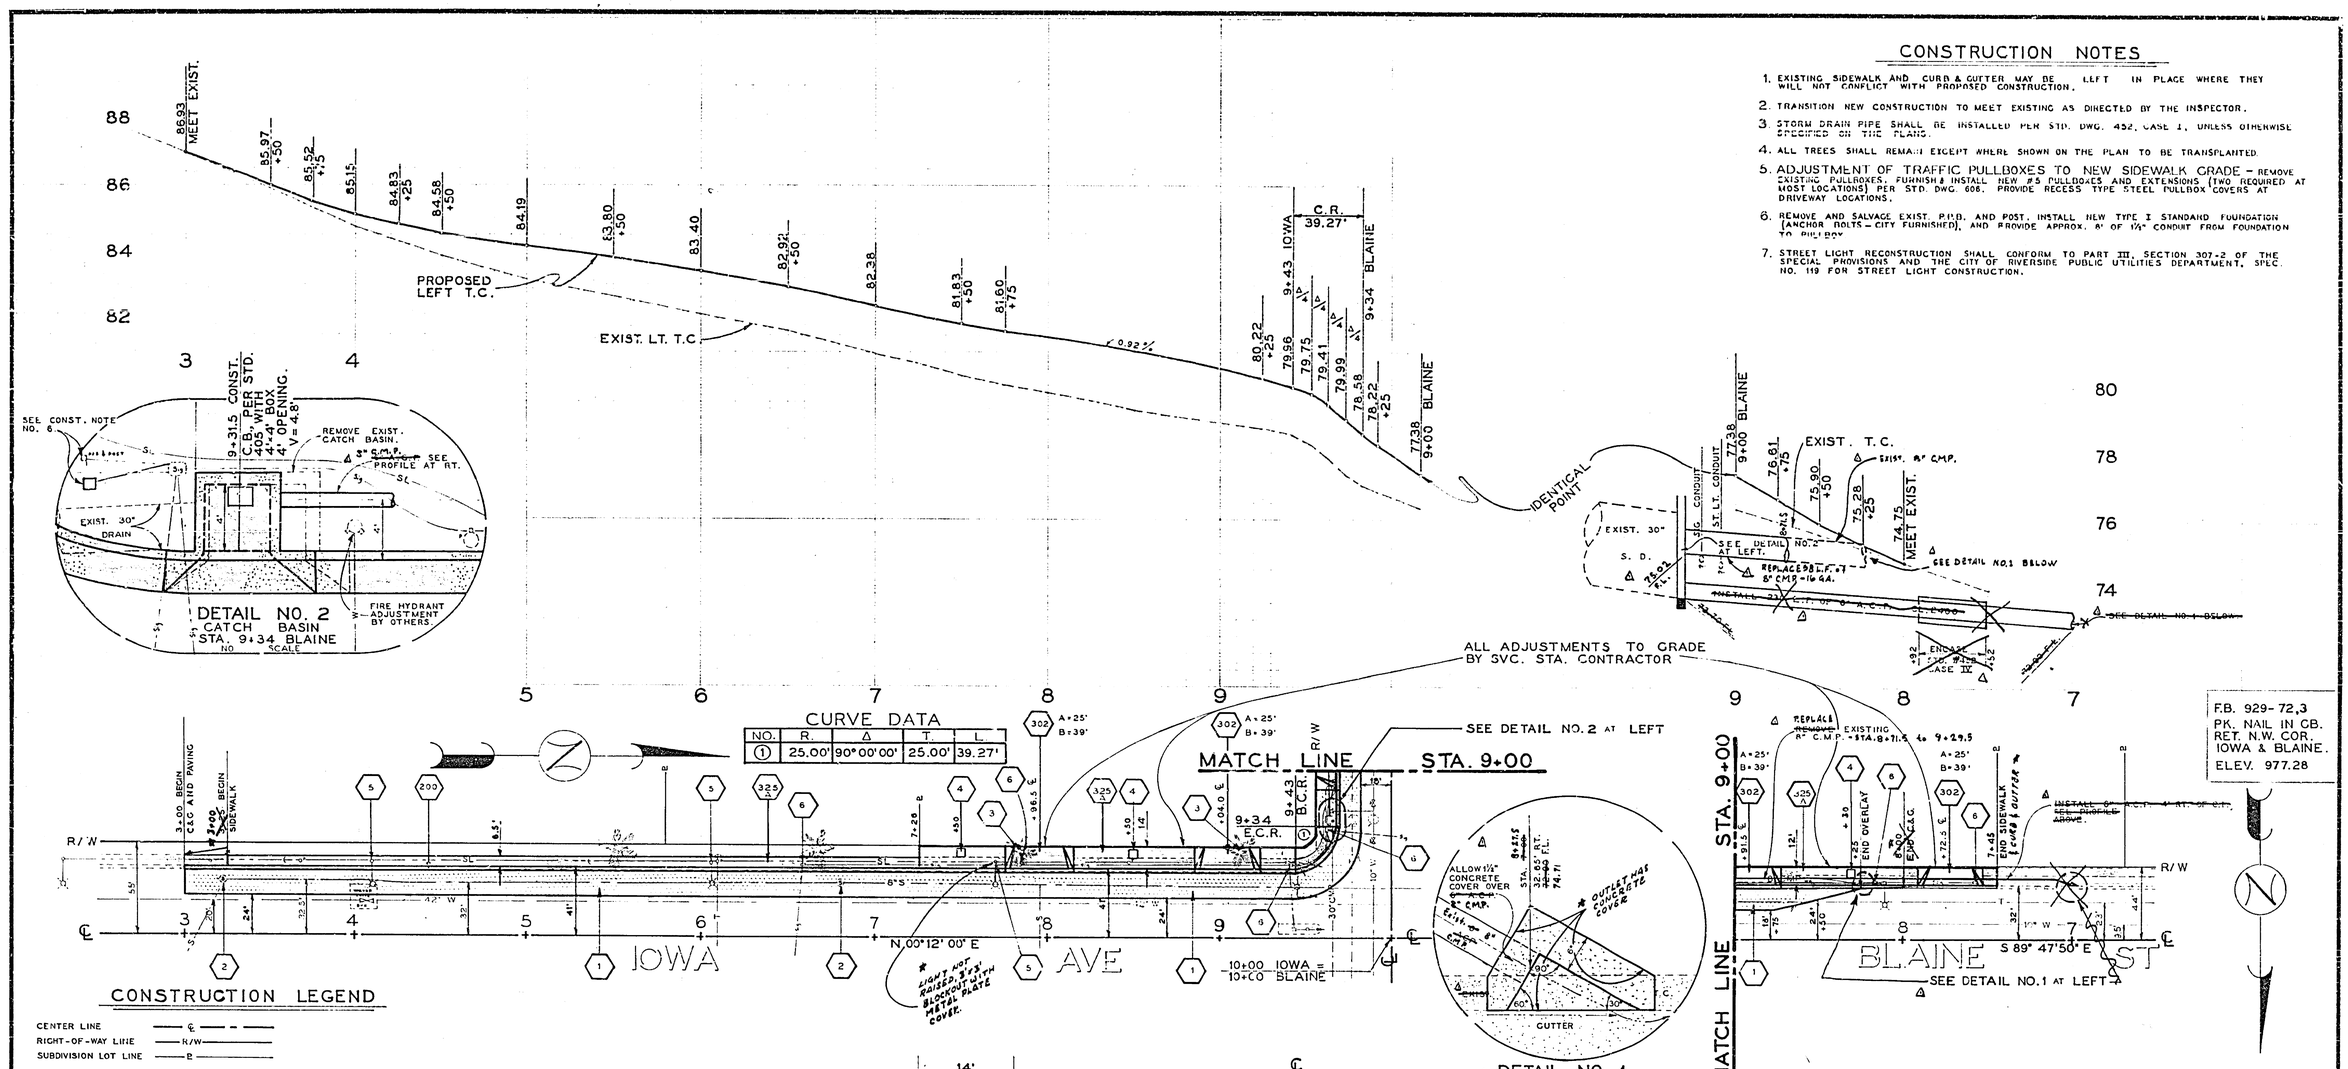

F.B. 929-72,3
PK. NAIL IN CB. RET. N.W. COR. IOWA & BLAINE.
ELEV. 977.28

Δ Deleted 6" A.C.P., added 69' of 8" C.M.P. Per Addendum No. I.

NAME	REVISIONS	APPR.	DATE

DESIGNED BY FCA DRAWN BY CHECKED BY GC

CITY OF RIVERSIDE, CALIFORNIA
DEPARTMENT OF PUBLIC WORKS

APPROVED BY	BY	DATE
PRINCIPAL ENGINEER		
TRAFFIC DIVISION		
CHIEF ENGINEER		

APPROVED BY William D. Anderson
DIRECTOR OF PUBLIC WORKS
DATE 3/29/71

IOWA AT BLAINE

700' S. IOWA TO 250' W. BLAINE

HORIZ. SCALE: 1" = 40' VERT. SCALE: 1" = 2'

PROJECT NO. 225

R-1516

SHEET 1 OF 1

FILE NO.