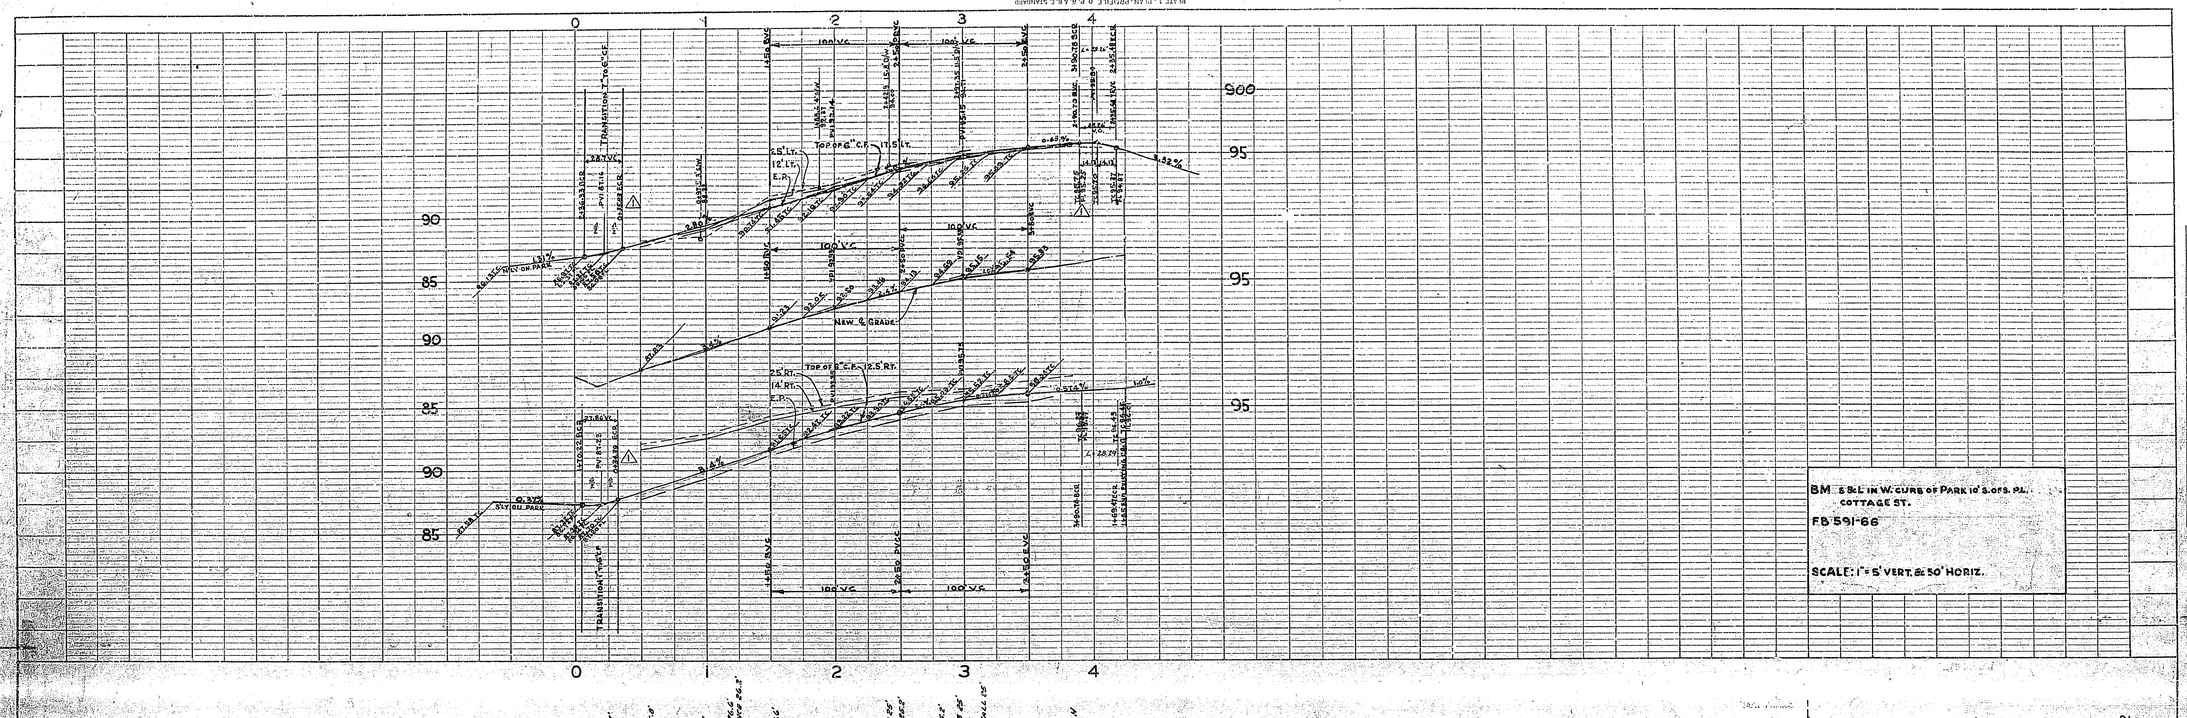


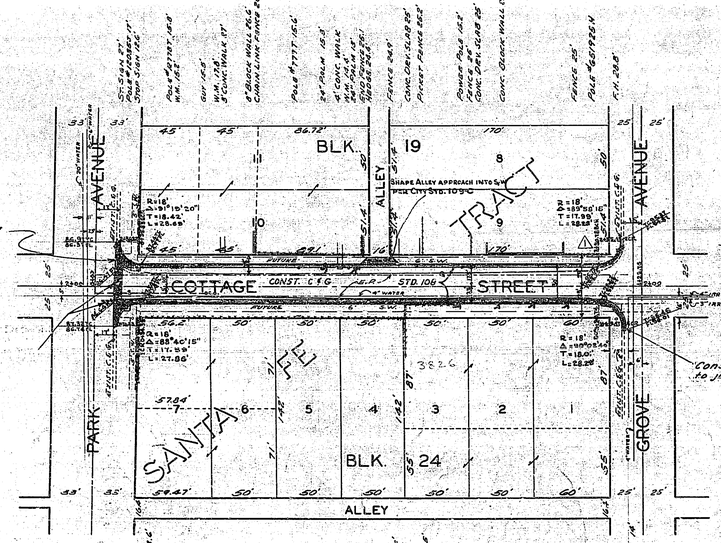


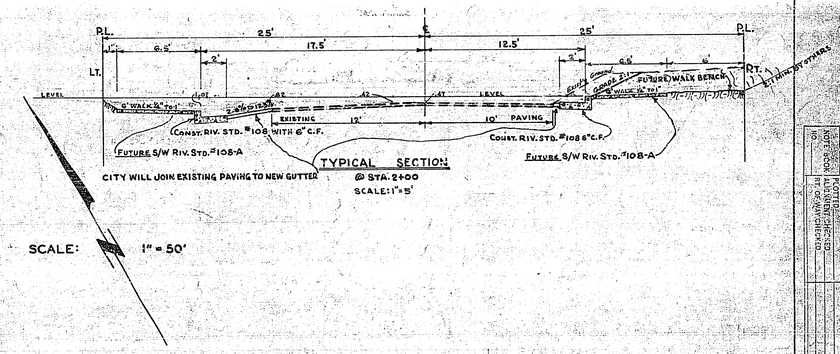


CONSTRUCTION NOTES:

1. The cost of the following items shall be included in the unit cost for curb & gutter.
2. Remove existing curb returns & construct new returns as shown.
3. Remove walk at station 1+88 to clear construction & replace to match new curb grade.
4. Remove bank wire fence to clear construction.
5. Remove & replace existing sidewalk as required to match new curb returns.
6. Remove 12" C.M.P. @ 11.6' right to clear construction & plug.

NOTE:

1. City will join existing paving to new gutter.
2. City will remove trees.
3. The utility company or department involved will relocate utilities.

| REVISIONS | | |
|---|---|---|
| MARK | DATE | DESCRIPTION |
| 1 | 11-26-58 | Elevation correction 3+50 N.I.P. Deleted O.H. Stub & O.H. S.P.B.I.C. - Job-11 |

CITY OF RIVERSIDE CALIFORNIA
DEPARTMENT OF PUBLIC WORKS

COTTAGE STREET IMPROVEMENT DISTRICT
BETWEEN PARK AVE. AND GROVE AVE.

DESIGNED BY A.K.J.
DRAWN BY DRB, CH, A.K.J.
CHECKED BY J.L.B.
RECOMMENDED BY [signature] ASSISTANT CITY ENGINEER
APPROVED BY [signature] DIRECTOR OF PUBLIC WORKS
DATE July 11, 1958

R-155

SHEET 1 OF 1

PROFILE: PLOTTED, NOTE BOOK, CALCS CHECKED, ALL UTILITIES CHECKED, NO., STRUCTURE NOTES (IF ANY) CHECKED, DATE

PLAN: PLOTTED, NOTE BOOK, ALL UTILITIES CHECKED, NO., DATE