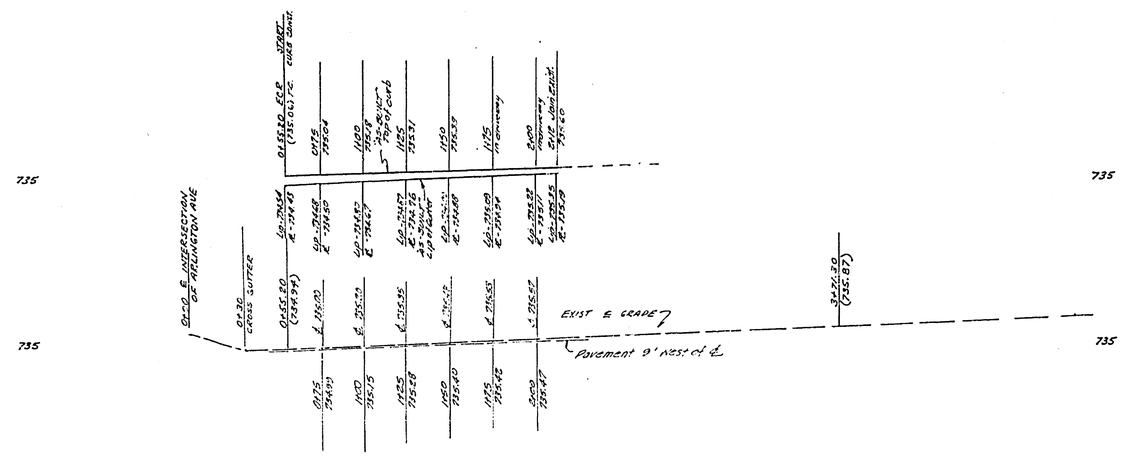

BENCH MARK - G-3-E
FOUND PK NAIL IN N.E. CURB RETURN
ARLINGTON & RUF LAND F.B 739/58
ELEV. 746.24

PROFILE SCALE:
1" = 40' HORIZ.
1" = 4' VERT.

0+00 1+00 2+00 3+00 4+00 5+00 6+00

GENERAL NOTES

1. CONSTRUCTION SHALL BE IN ACCORDANCE WITH STANDARD SPECIFICATIONS FOR PUBLIC WORKS CONSTRUCTION, 1970 EDITION, AND CITY OF RIVERSIDE STANDARD DRAWINGS.

THE CONTRACTOR SHALL DETERMINE THE TRUE LOCATION OF ANY UNDERGROUND UTILITIES PRIOR TO LAYING ANY LINES WHICH ARE TO CONNECT TO EXISTING SEWERS OR WATER LINES. THESE LINES SHALL BE EXPOSED AND THEIR POSITIONS VERIFIED. THE CONTRACTOR SHALL PROTECT ALL UNDERGROUND UTILITIES.

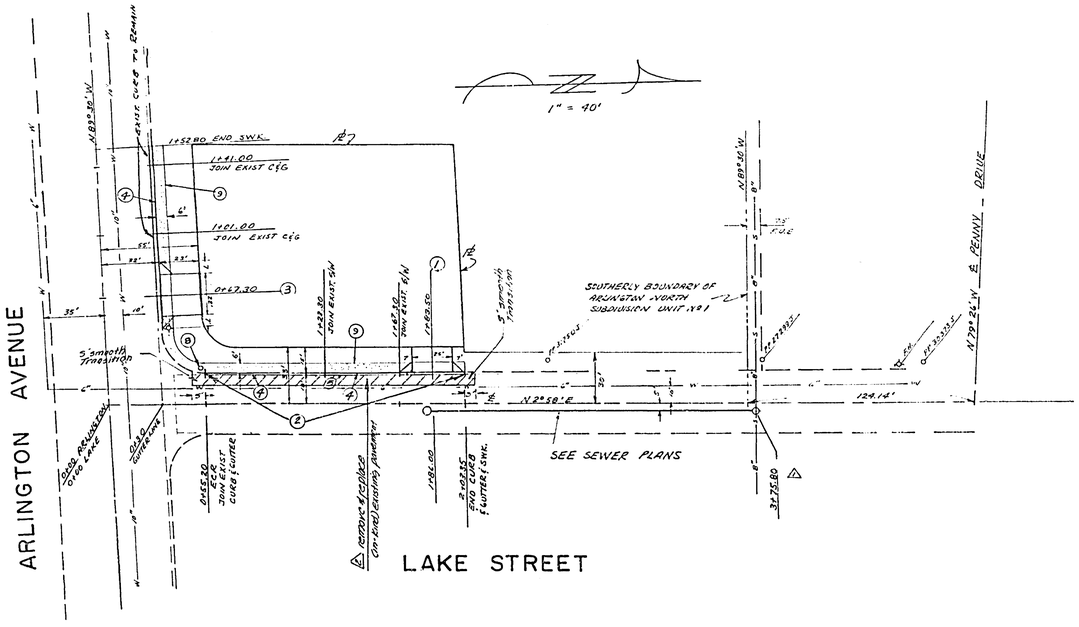

CONSTRUCTION NOTES

1. CONSTRUCT 25'x39' COMMERCIAL DRIVEWAY PER CITY STD 302
2. REMOVE EXIST CURB & GUTTER
3. CONSTRUCT 23'x 36' COMMERCIAL DRIVEWAY PER STD 302
4. CONSTRUCT STD 6" CURB & GUTTER PER CITY STANDARD 200
5. REPLACE 1' OF A.C. PAVING TO DEPTH OF 6" WHERE REMAINING EXIST. C&G.
6. OMITTED.
7. "
8. STOP SIGN & STREET NAME SIGN TO BE MAINTAINED IN PLACE.
9. CONSTRUCT CURB SIDEWALK PER CITY STD 325'

△ REMOVE & REPLACE "IN-KIND" (OR AT THE DIRECTION OF THE CITY ENGINEER) EXISTING PAVEMENT

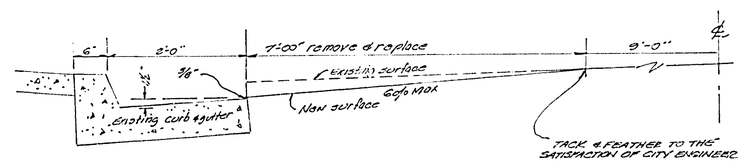

△ TYPICAL SECTION PAVEMENT REMOVAL

Samuel Salkin
SAMUEL SALKIN RCE 13420
DATE

MARK	REVISIONS	APPR	DATE
△	REVISED SEWER M.H. STA.	FD	1/6/72
△	remove & replace Pav't		6-15-72

DESIGNED BY FD DRAWN BY FD CHECKED BY LL

CITY OF RIVERSIDE, CALIFORNIA
DEPARTMENT OF PUBLIC WORKS

APPROVED BY	BY	DATE
OFFICE ENGINEER		
PARK DEPARTMENT		
TRAFFIC DIVISION		
ASSISTANT CITY ENG.		

APPROVED BY
DIRECTOR OF PUBLIC WORKS
DATE 3/30/72

STREET IMPROVEMENTS
NW. CORNER OF LAKE ST. & ARLINGTON AVE.
R-70-645.

HORIZ. SCALE: 1" = 40' VERT. SCALE: 1" = 4'

PROJECT NO. R-1564
SHEET 1 OF 1
FILE NO.

F.B. 39 Job 1525