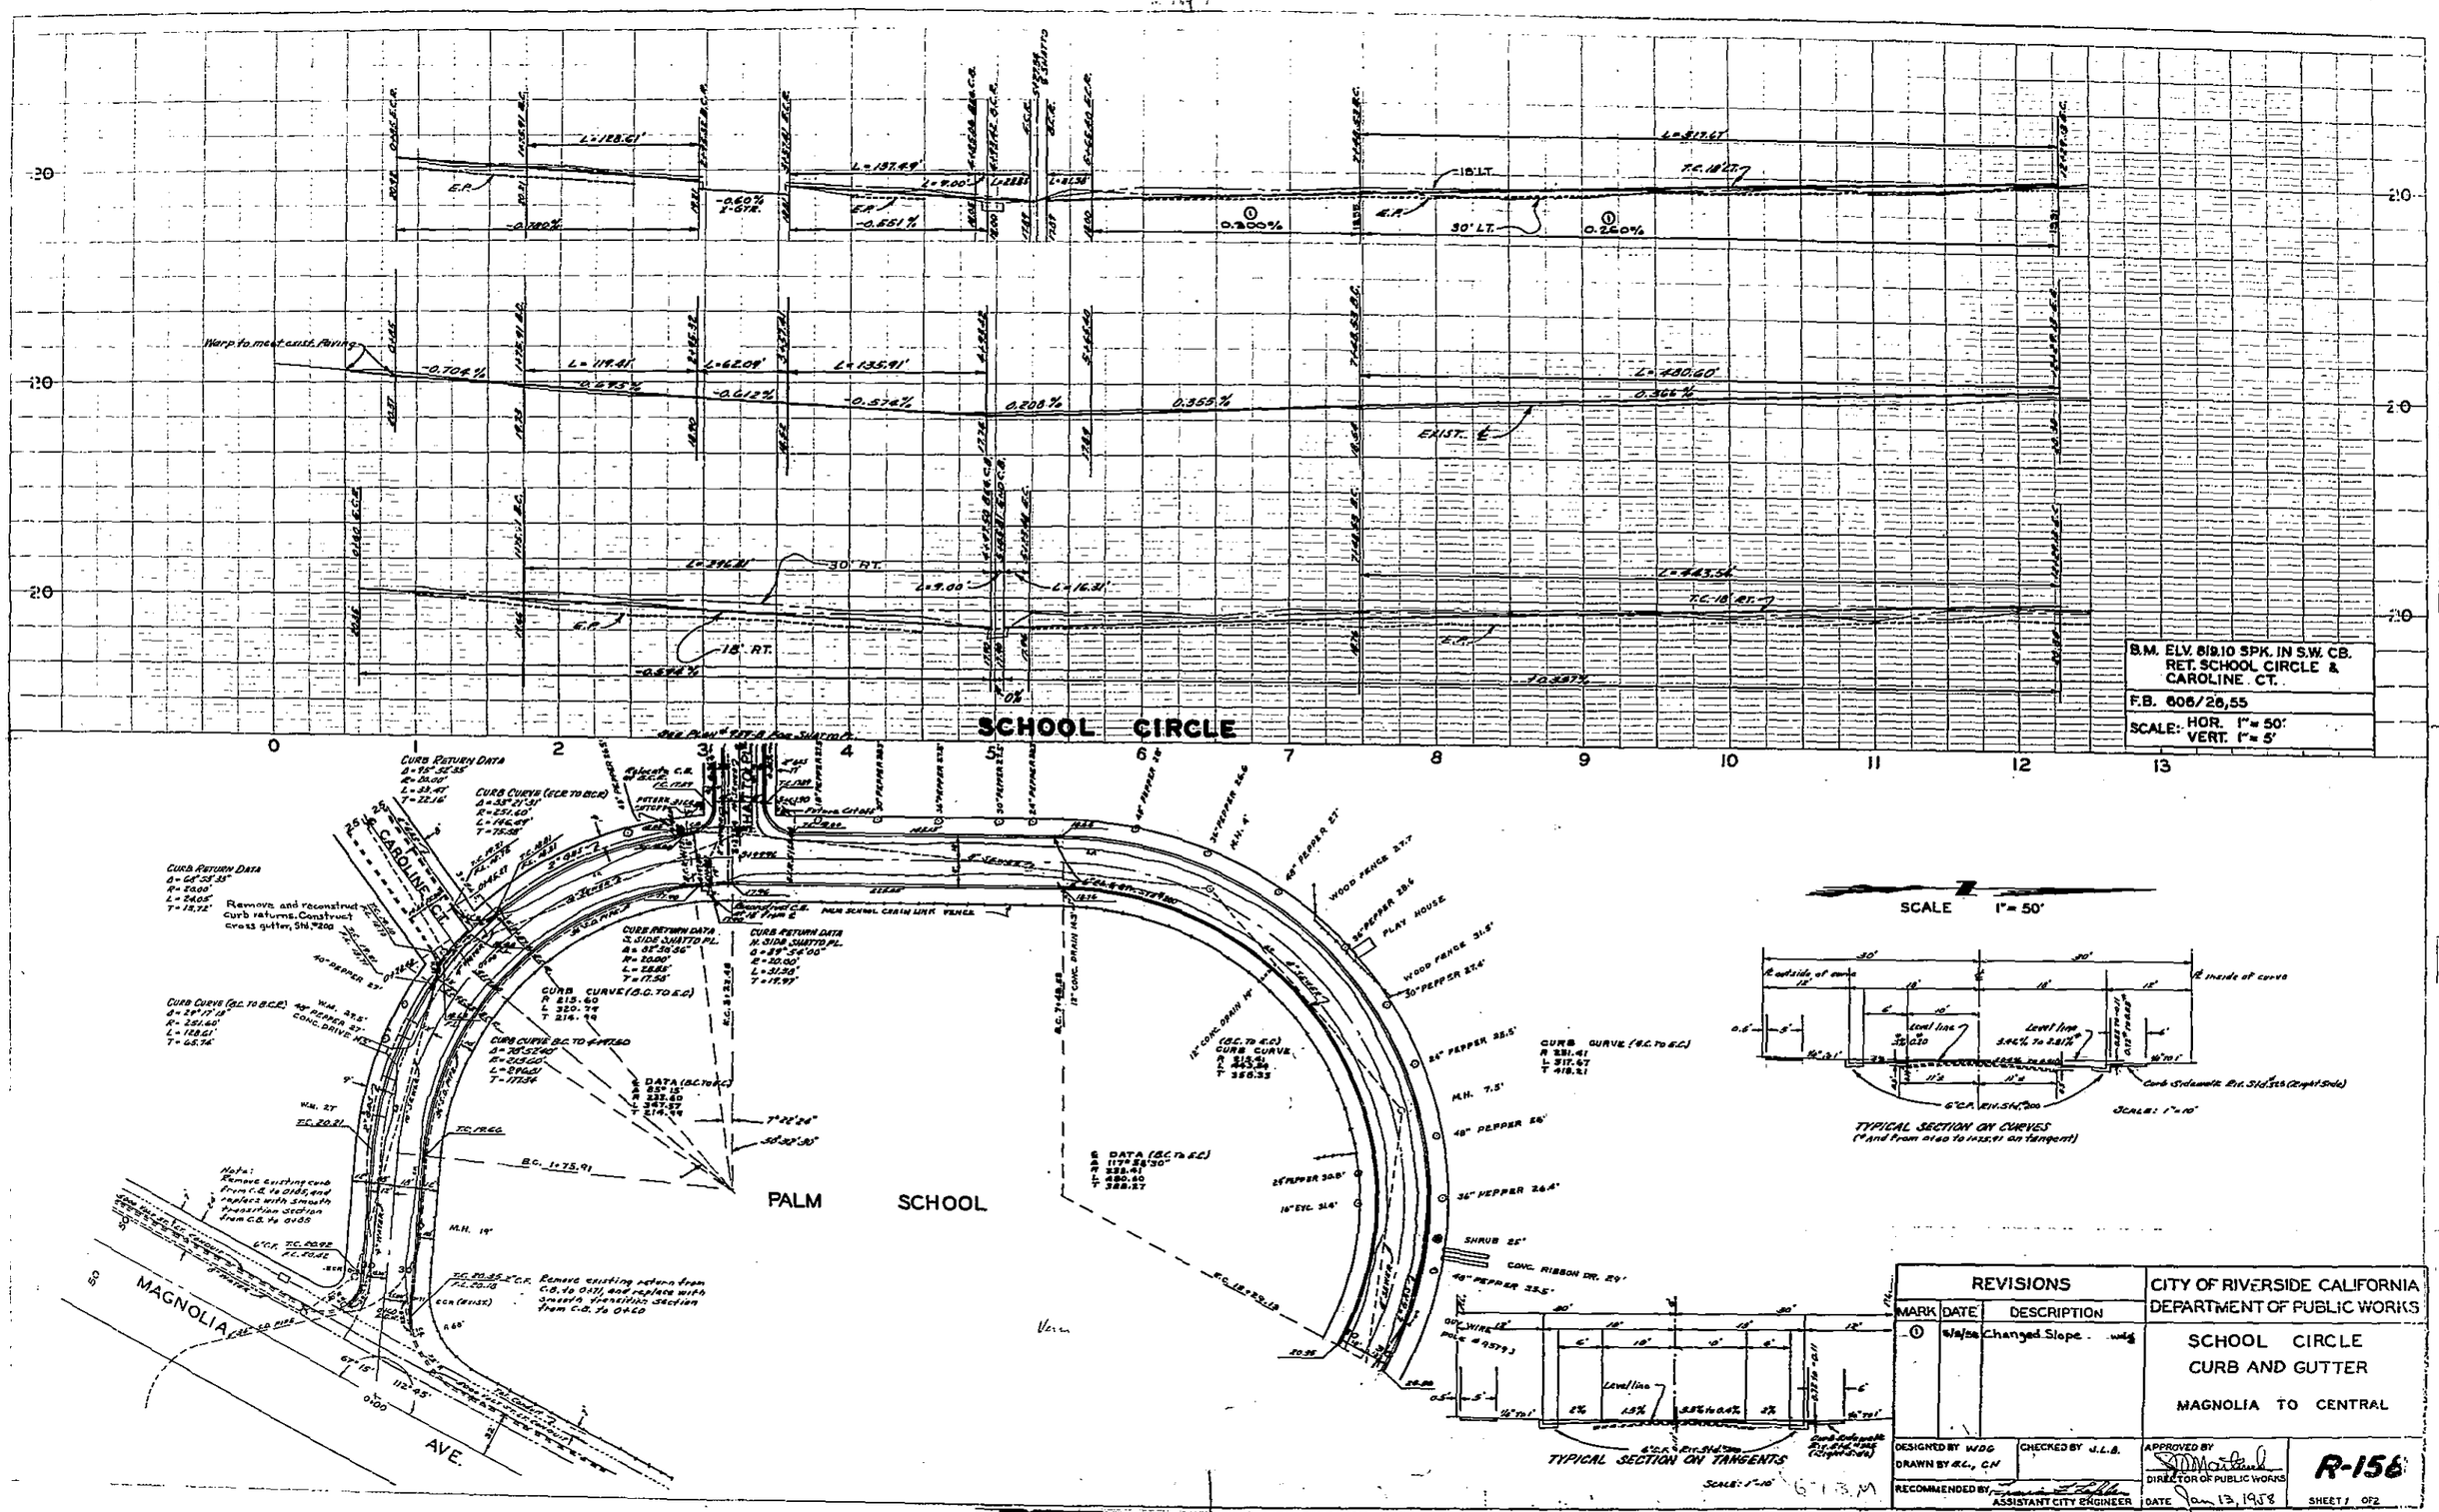
SCHOOL CIRCLE
PALM SCHOOL
MAGNOLIA AVE.
CAROLINE CT.
B.M. ELV. 819.10 SPK. IN S.W. CB. RET. SCHOOL CIRCLE & CAROLINE CT.
F.B. 606/26,55
SCALE: HOR. 1"= 50' VERT. 1"= 5'
SCALE 1"= 50'
TYPICAL SECTION ON CURVES
TYPICAL SECTION ON TANGENTS
REVISIONS
MARK DATE DESCRIPTION
1 6/2/58 Changed Slope
CITY OF RIVERSIDE CALIFORNIA
DEPARTMENT OF PUBLIC WORKS
SCHOOL CIRCLE
CURB AND GUTTER
MAGNOLIA TO CENTRAL
DESIGNED BY WDG
DRAWN BY R.C., C.H.
CHECKED BY J.L.B.
APPROVED BY
DIRECTOR OF PUBLIC WORKS
RECOMMENDED BY
ASSISTANT CITY ENGINEER
DATE Jan. 13, 1958
R-156
SHEET 1 OF 2

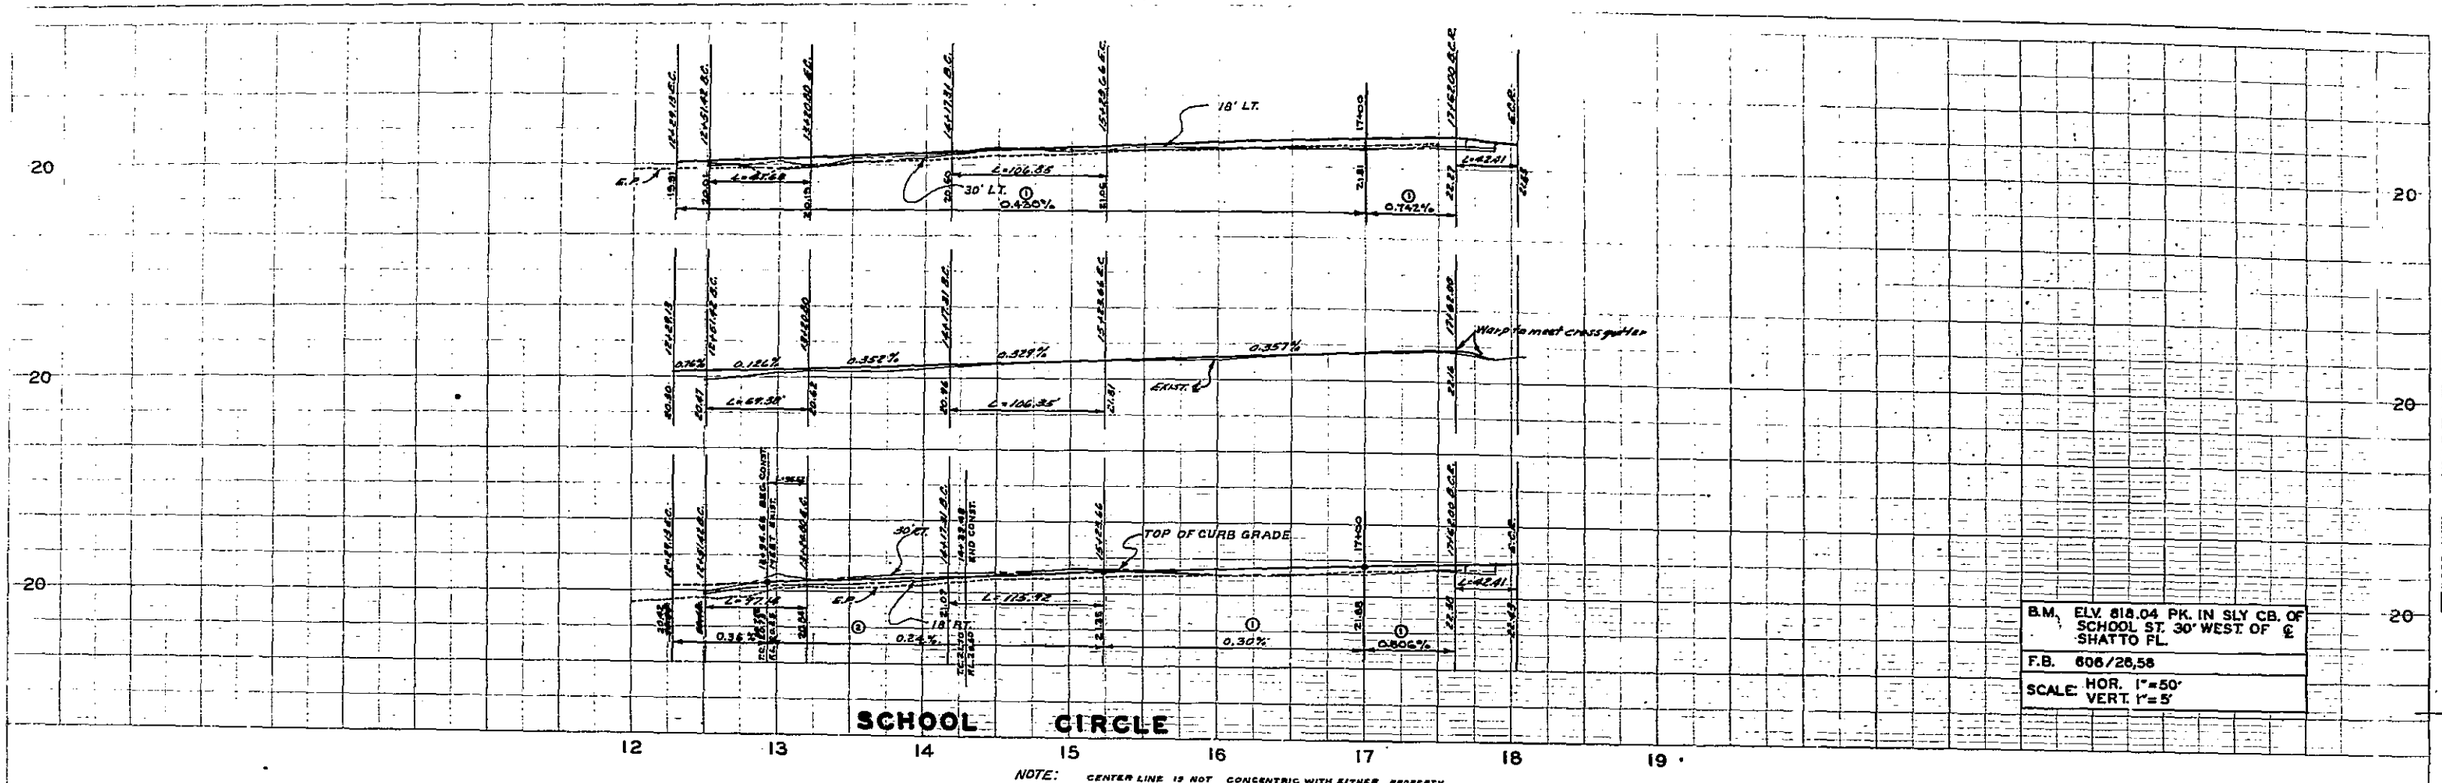

B.M.	ELV. 818.04 PK. IN SLY CB. OF SCHOOL ST. 30' WEST OF ℄ SHAFT TO FL.
F.B.	606/26,58
SCALE:	HOR. 1"=50' VERT. 1"=5'

SCALE: 1"=50'

NOTE: CENTER LINE IS NOT CONCENTRIC WITH EITHER PROPERTY LINE, AND PROPERTY LINES ARE NOT CONCENTRIC WITH EACH OTHER. CURBS ARE CONCENTRIC WITH CENTER LINE.

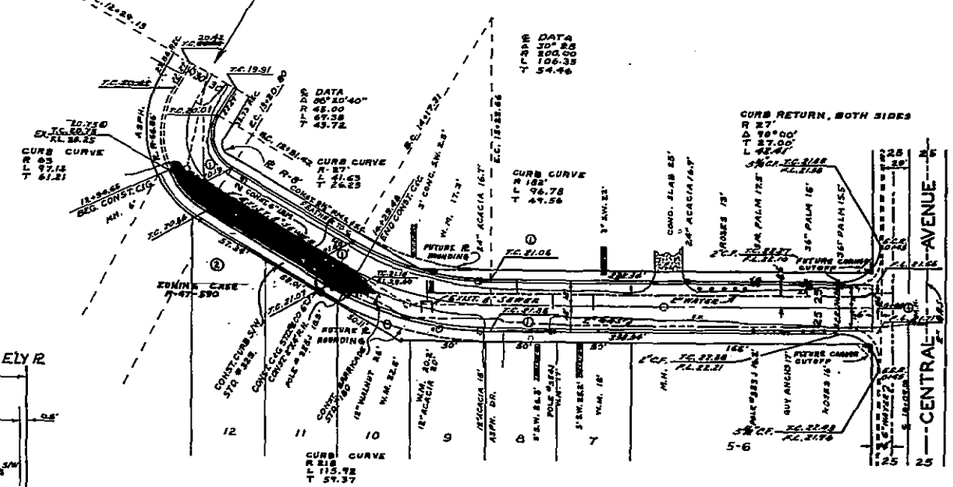

Remove and reconstruct curb returns and cross gutter, Std. #200.

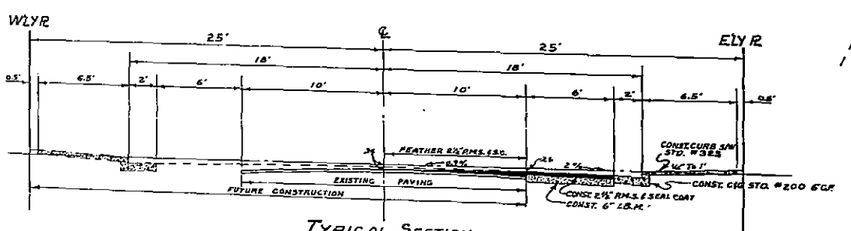

TYPICAL SECTION
STA. 14+00
SCALE: 1"=5'

NOTE: It shall be the responsibility of the Contractor to clear the right of way in accordance with the provisions of the law as it affects each utility including irrigation lines and appurtenances and at no cost to the City.

REVISIONS		
	DATE	DESCRIPTION
1	7/8/58	Change Slope wdg
2	2/12/60	ADDED CONST. NOTES & TYPICAL SECTION B.L. wdg

CITY OF RIVERSIDE CALIFORNIA
DEPARTMENT OF PUBLIC WORKS

SCHOOL CIRCLE
CURB AND GUTTER

MAGNOLIA TO CENTRAL

DESIGNED BY WG
DRAWN BY B.L., C.N.
CHECKED BY J.L.B.
RECOMMENDED BY [signature] ASSISTANT CITY ENGINEER
APPROVED BY [signature] DIRECTOR OF PUBLIC WORKS
DATE Jan 13, 1958

R-158

SHEET 2 OF 2