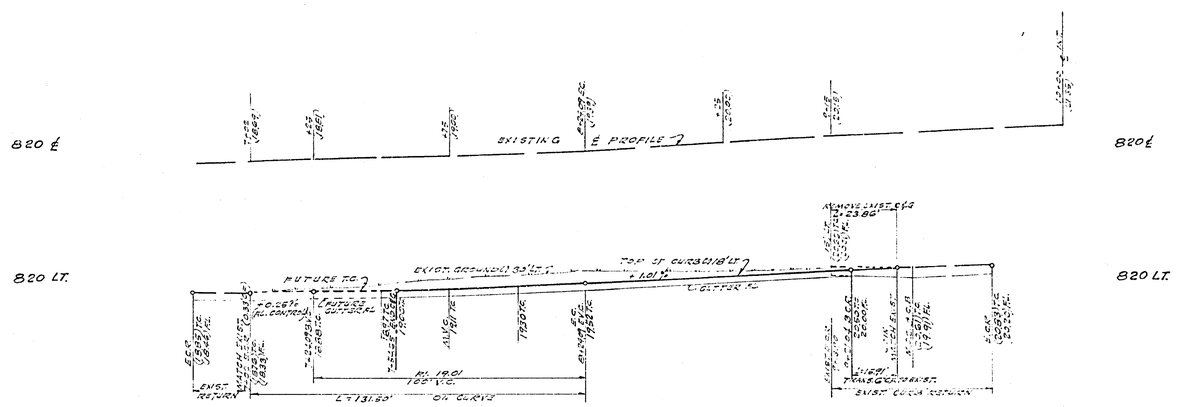

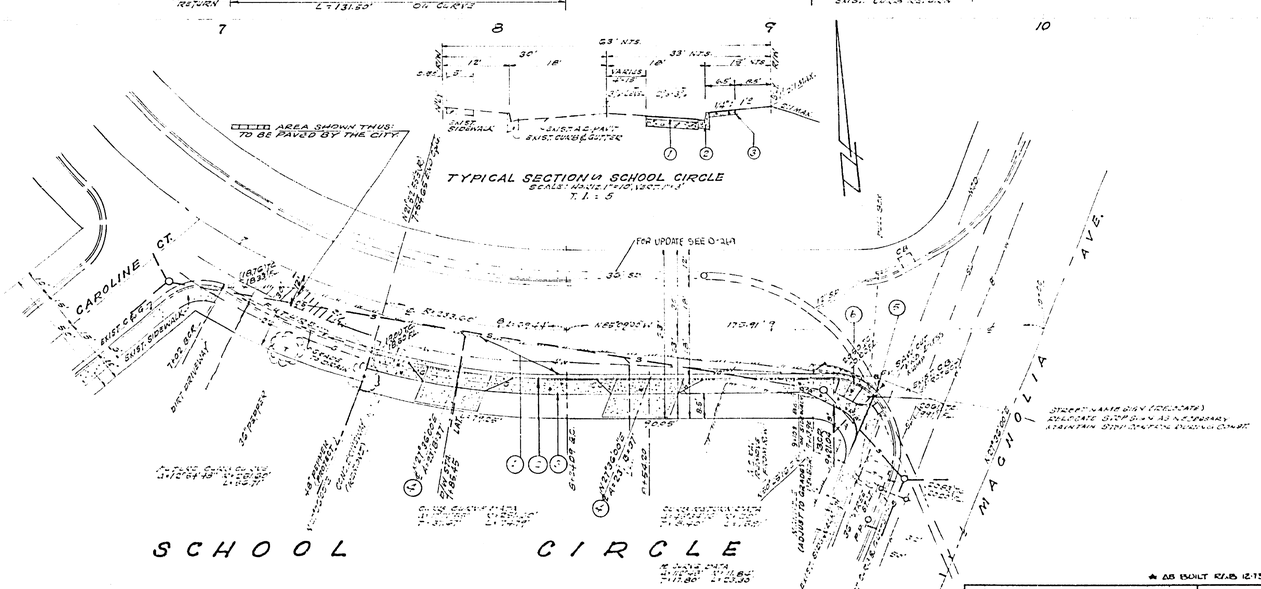

GENERAL NOTES

1. CONSTRUCTION SHALL BE IN ACCORDANCE WITH STANDARD SPECIFICATIONS FOR PUBLIC WORKS CONSTRUCTION, 1970 EDITION AND STANDARD DRAWINGS.
2. IT SHALL BE THE RESPONSIBILITY OF THE CONTRACTOR TO CLEAR THE CONSTRUCTION ACCESS AND WORK AREA, REMOVE OR PROTECT ANY OBSTRUCTIONS, INCLUDING LOCATION OF LINES AND REPAIR OF DAMAGES AND CLEAN UP.
3. [illegible]
4. THIS PLAN SHOWS PRESENT KNOWN UNDERGROUND UTILITIES. THE CONTRACTOR SHALL CONTACT THE APPROPRIATE UTILITY COMPANY FOR PRECISE LOCATION OF UTILITIES PRIOR TO CONSTRUCTION. IF UTILITIES CONFLICT WITH PROPOSED IMPROVEMENTS, THE CONTRACTOR SHALL NOTIFY THE ENGINEER IMMEDIATELY FOR DETERMINATION OF THE ORDER OF WORK AND/OR ALTERATIONS.
5. THE DEVELOPER SHALL ARRANGE FOR A BOND TO BE ISSUED BY A BONDS & GUARANTEE INSURANCE OF AMERICA, INC. FOR OF ADEQUATE AMOUNT SHALL BE PROVIDED BY THE DEVELOPER AND SUBMITTED TO THE CITY FOR ITS APPROVAL PRIOR TO CONSTRUCTION.
6. THE CONTRACTOR SHALL CONTACT THE CITY ENGINEER TWO WEEKS PRIOR TO CONSTRUCTION TO NEGOTIATE THE CITY'S SHARE OF PAVING COSTS CONSTRUCTED ON SCHOOL CIRCLE.

PRIVATE ENGINEER'S NOTE TO CONTRACTOR:

THE CONTRACTOR SHALL BE RESPONSIBLE FOR VERIFYING AND COMPARING THE DIMENSIONS AND CONDITIONS SHOWN ON THE PLANS WITH ACTUAL FIELD CONDITIONS PRIOR TO ANY WORK. ANY DISCREPANCIES FOUND SHALL BE REPORTED TO THE ENGINEER IMMEDIATELY. FAILURE TO DO SO WILL MAKE THE CONTRACTOR RESPONSIBLE FOR ANY AND ALL CORRECTIVE WORK.

CONSTRUCTION NOTES

1. CONSTRUCT 6" CURB PER STD. PLAN 160 WITH 12" APRON, 15' CURB & GUTTER & 6" CURB & GUTTER TRANSITION IN 20'.
2. CONST. CURB TYPE "SCHOOL" PER STD. PLAN NO. 333
3. CONST. CURB & GUTTER TRANSITION PER STD. PLAN NO. 160 (SINGLE FRONTAGE, SINGLE PAVING CONFIGURATION)
4. CONST. ACCESS RAMP PER STD. PLAN NO. 934.

B.M. RIVERSIDE COUNTY FLOOD CONTROL DISTRICT
BRASS TAB NAIL & BOLT, 7.6' NW'LY OF
MAGNOLIA & SCHOOL CIRCLE ELEV. 801.452

★ AS BUILT 12-15

HAWKING, ROBERTSON & ASSOC.
ENGINEERS & SURVEYORS
RIVERSIDE, CALIFORNIA
Harold L. Hawkins 12-20-72
R.C.E. 10008 DATE
FOR: RAY MAGNON

DESIGNED BY G.N. DRAWN BY G.N. CHECKED BY G.N.

CITY OF RIVERSIDE, CALIFORNIA
DEPARTMENT OF PUBLIC WORKS

APPROVED BY: CITY ENGINEER, WATER SUPERINTENDENT, TRAFFIC ENGINEER, ASSISTANT CITY ENGINEER — BY — DATE

APPROVED BY: DIRECTOR OF PUBLIC WORKS
DATE 4-25-73

STREET PLAN & PROFILE
SCHOOL CIRCLE
FROM MAGNOLIA AVENUE TO 1400.17' WEST OF MAGNOLIA AVENUE
Orig. Plan - 1-8-73 Plan Ch. 1

HORIZ. SCALE: 1" = 20' VERT. SCALE 1" = 4'

PROJECT NO. R-1585
SHEET 1 OF 1
FILE NO. 72-2220