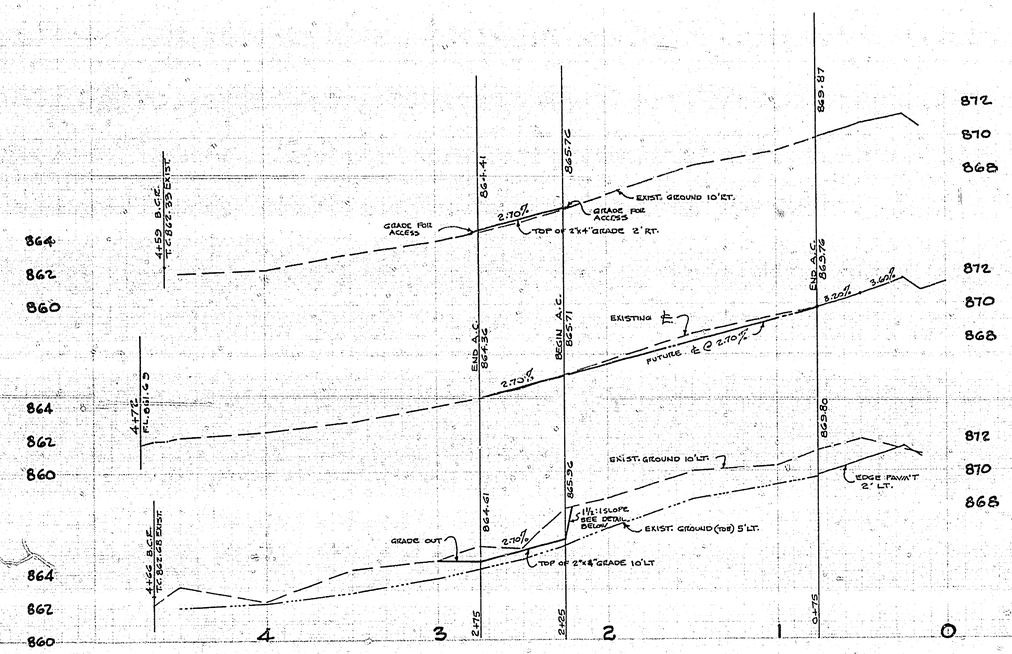

CONSTRUCTION NOTES:

1. ALL CONSTRUCTION SHALL BE IN ACCORDANCE WITH THE STANDARD SPECIFICATIONS FOR PUBLIC WORKS CONSTRUCTION, 1970 EDITION, AND PER CITY OF RIVERSIDE STANDARD DRAWINGS.

BENCH MARK: C/R F.B. 473
ELEV. 867.351 SPIKE AND LEAD IN NO. CURB
SPRING GARDEN STREET 10' W. OF W. ℄ OF LAUREL

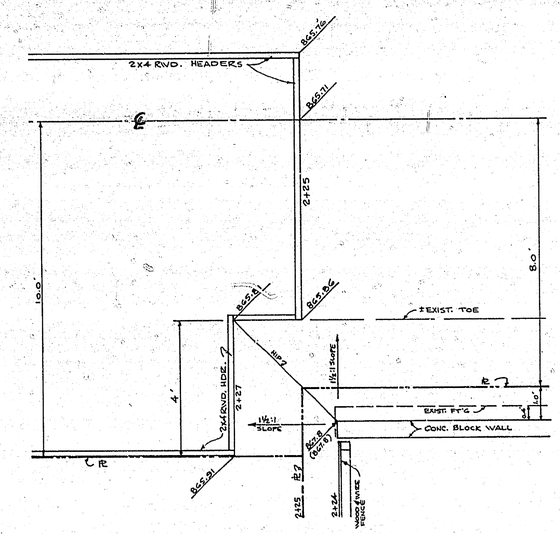

DETAIL "A"
SCALE: 1/2"=1'-0"

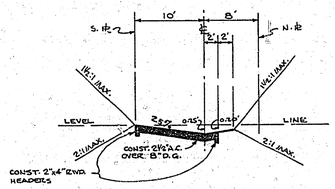

TYPICAL SECTION
ALLEY STD. NO. 110
NO SCALE

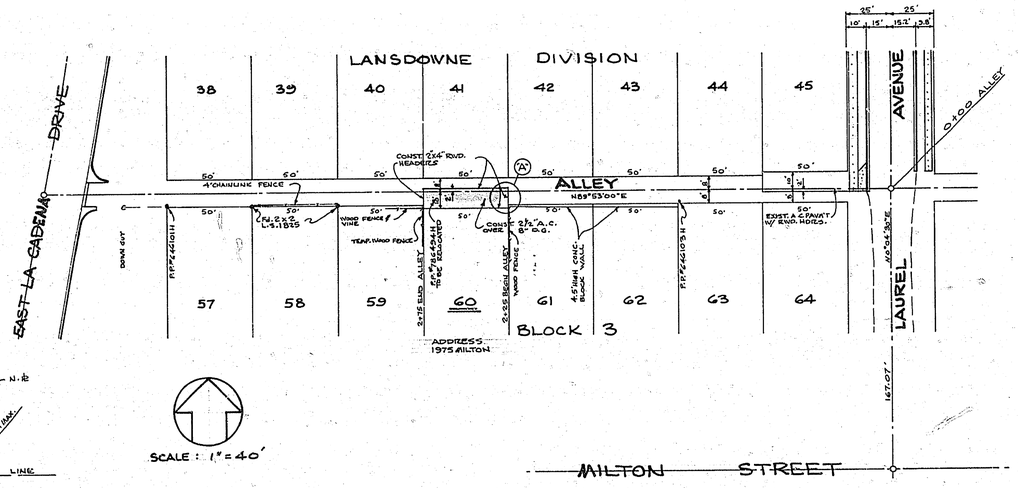

SCALE: 1"=40'

AS BUILT 2-5-73 BDM
(NO CHANGES)

INDEXED

LOCKWOOD ENGINEERING & SURVEYING COMPANY, INC. 380 W. FOOTHILL BLVD. RIALTO, CALIFORNIA — CARLETON W. LOCKWOOD RCE 9181 — 8-21-72	MARK / REVISIONS / APPR. / DATE — DESIGNED BY ___ DRAWN BY ___ CHECKED BY ___	CITY OF RIVERSIDE, CALIFORNIA DEPARTMENT OF PUBLIC WORKS — APPROVED BY / BY / DATE: PRINCIPAL ENGINEER, PARK DEPARTMENT, TRAFFIC DIVISION, CHIEF P. W. ENGR. — APPROVED BY: DIRECTOR OF PUBLIC WORKS — DATE 9-12-72	IMPROVEMENT PLANS — ALLEY BETWEEN LAUREL AND FRONTAGE ROAD BUILDING PERMIT FOR 1975 MILTON ST. — HORIZ. SCALE: 1" = 40' VERT. SCALE: 1" = 4'

PROJECT NO. R-1602
SHEET 1 OF 1
FILE NO.