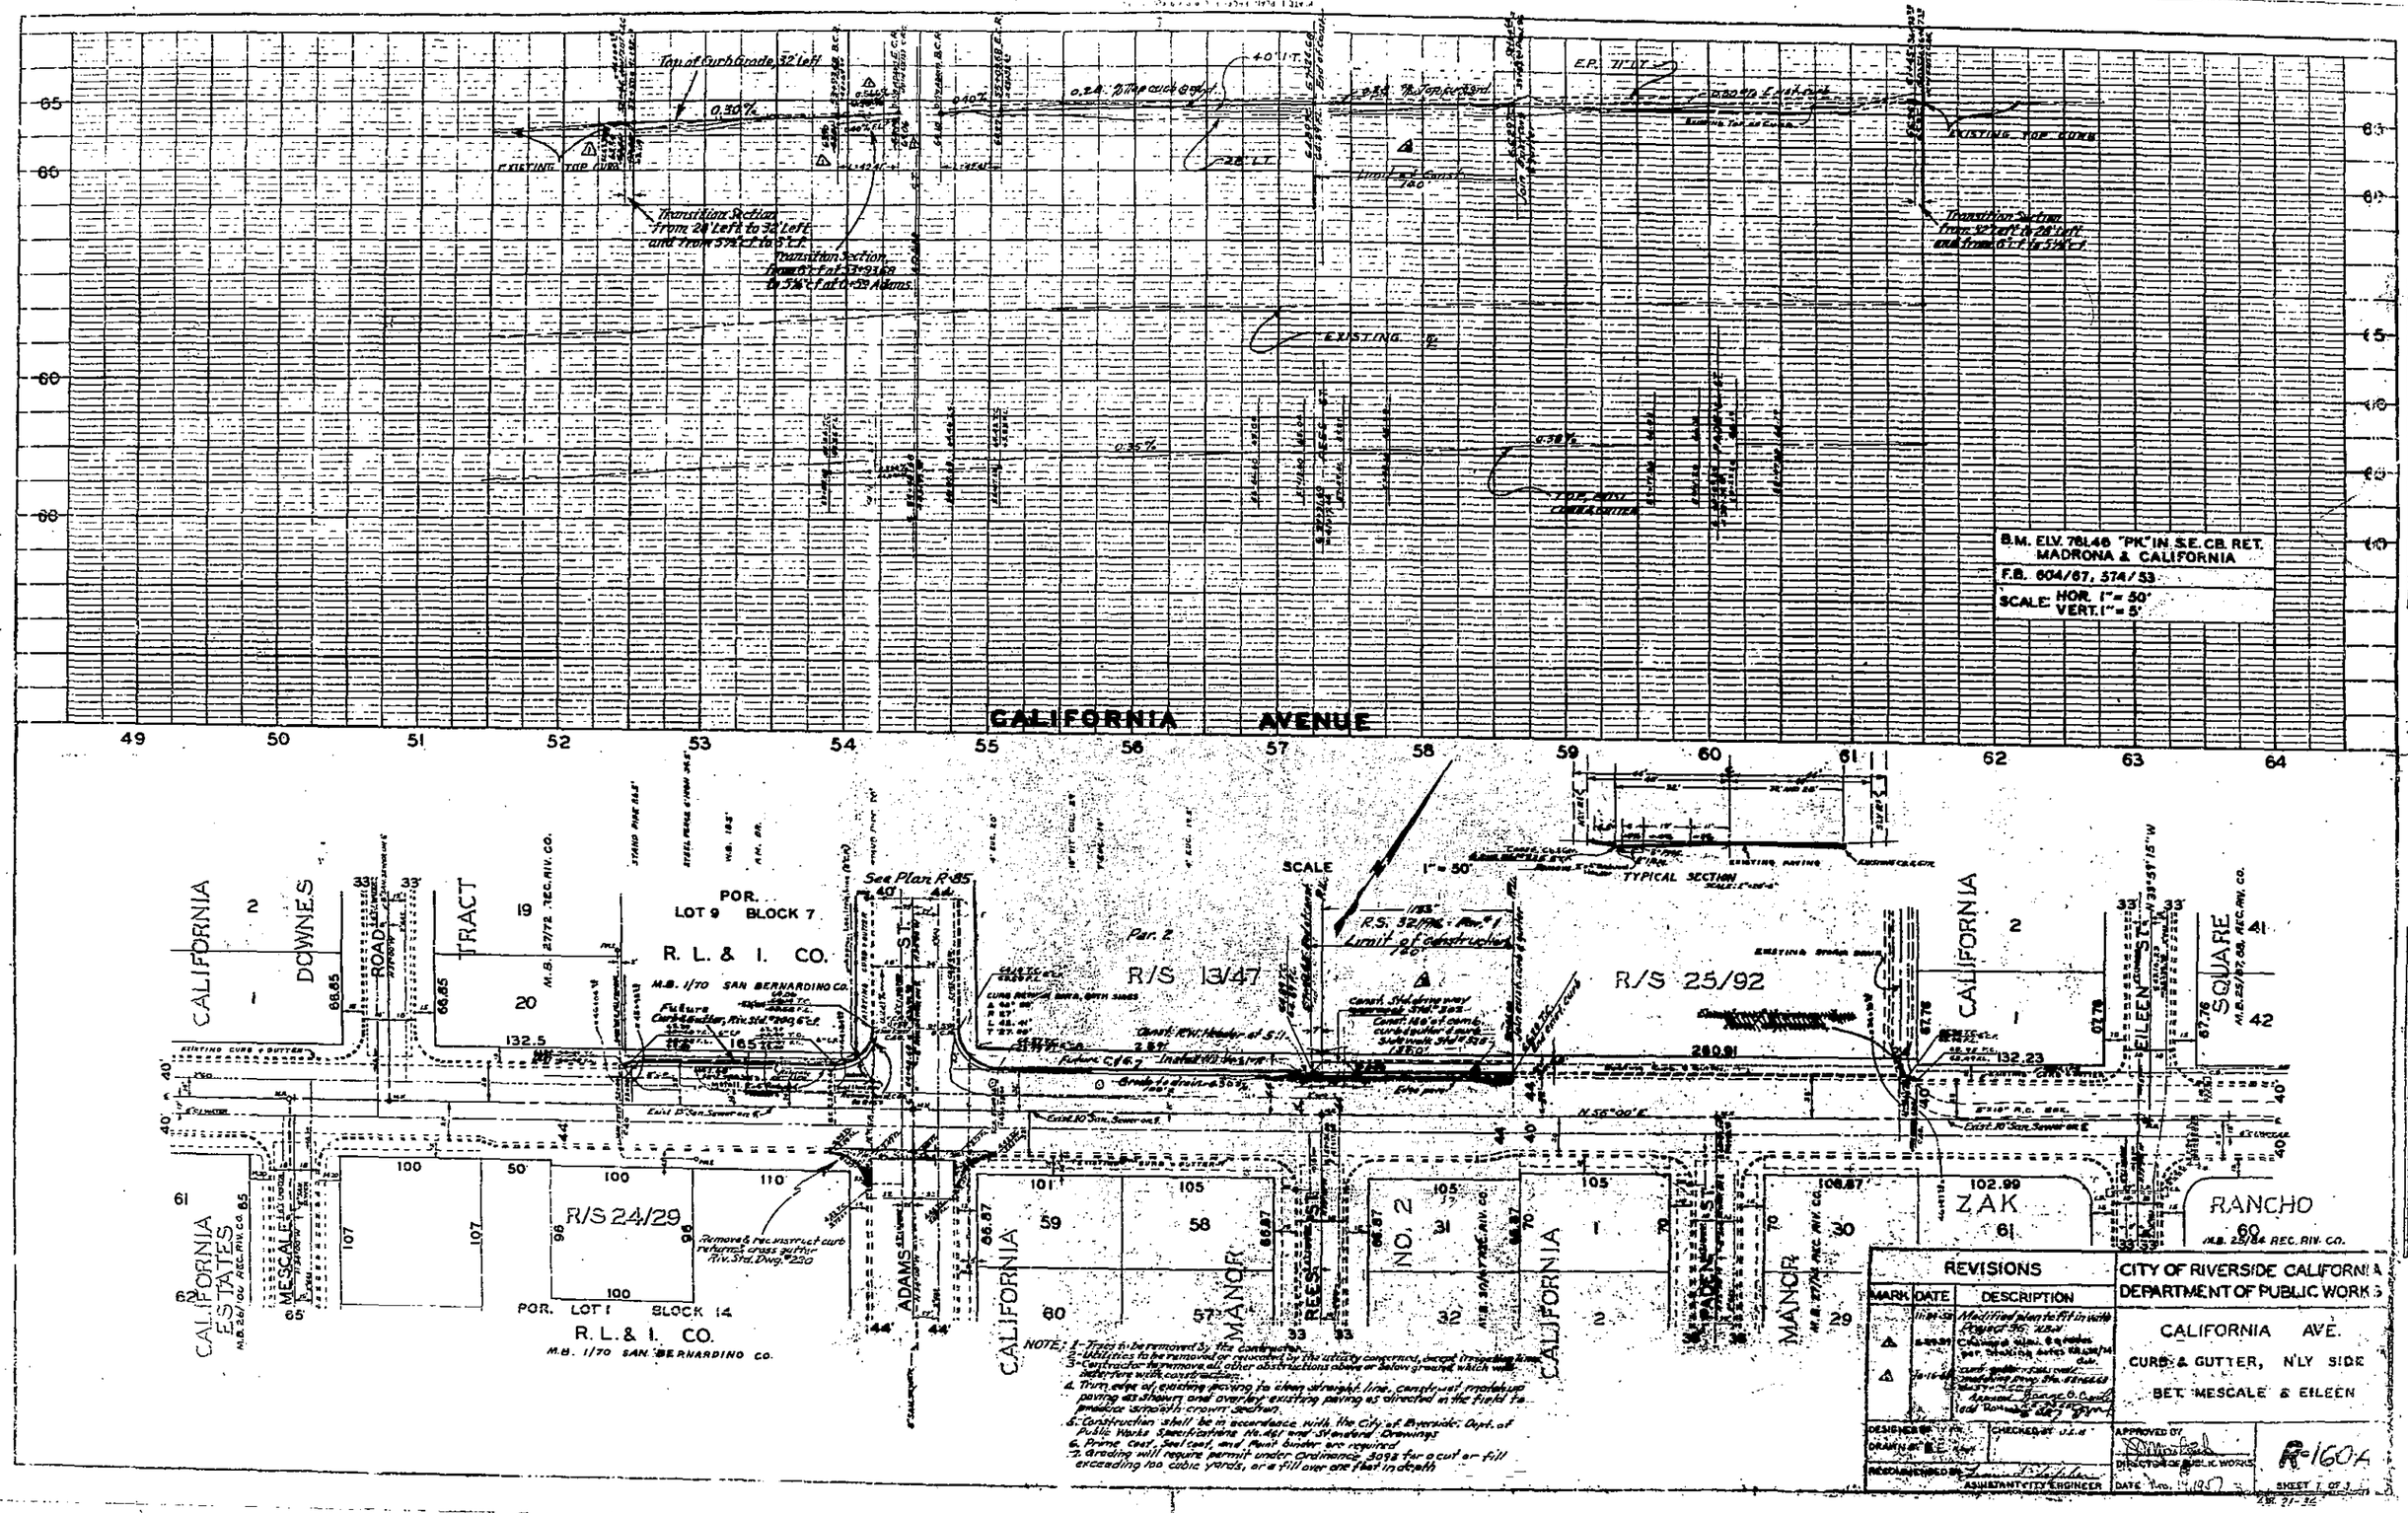
CALIFORNIA AVENUE
Top of Curb Grade 32' left
0.30%
EXISTING TOP CURB
Transition Section from 28' left to 32' left and from 5½" C to 5" C
Transition Section from 67' F of 33+93.60 to 5½" F at 0+59 Adams
EXISTING
0.35%
0.38%
TOP OF CURB
EXISTING TOP CURB
Transition Section from 42' left to 28' left and from 6" C to 5½" C
B.M. ELV. 781.46 "PK" IN S.E. CB. RET. MADRONA & CALIFORNIA
F.B. 604/67, 574/53
SCALE: HOR. 1" = 50'
VERT. 1" = 5'
TYPICAL SECTION
SCALE 1" = 50'
R.S. 32/196 Rev. #1
Limit of construction
R/S 13/47
R/S 25/92
R/S 24/29
POR. LOT 9 BLOCK 7
R. L. & I. CO.
M.B. 1/70 SAN BERNARDINO CO.
POR. LOT 1 BLOCK 14
R. L. & I. CO.
M.B. 1/70 SAN BERNARDINO CO.
See Plan R-85
Remove & reconstruct curb refurnish cross gutter Riv. Std. Dwg. #220
CALIFORNIA DOWNES TRACT
CALIFORNIA ESTATES
MESCALE ROAD
ADAMS ST.
CALIFORNIA MANOR NO. 2
REES ST.
PARK ST.
CALIFORNIA MANOR
EILEEN STA.
CALIFORNIA SQUARE
ZAK
RANCHO
NOTE: 1-Trees to be removed 3, the contractor.
2-Utilities to be removed or relocated by the utility concerned, except irrigation lines.
3-Contractor to remove all other obstructions above or below ground which will interfere with construction.
4. Trim edge of existing paving to clean straight line, compact and replace paving as shown and overlay existing paving as directed in the field to produce smooth crown section.
5. Construction shall be in accordance with the City of Riverside Dept. of Public Works Specifications No. 461 and Standard Drawings
6. Prime coat, Seal coat, and Paint binder are required
7. Grading will require permit under Ordinance 3092 for a cut or fill exceeding 100 cubic yards, or a fill over one foot in depth
REVISIONS
MARK DATE DESCRIPTION
CITY OF RIVERSIDE CALIFORNIA
DEPARTMENT OF PUBLIC WORKS
CALIFORNIA AVE.
CURB & GUTTER, N'LY SIDE
BET. MESCALE & EILEEN
DESIGNED BY
DRAWN BY
CHECKED BY
RECOMMENDED BY
ASSISTANT CITY ENGINEER
APPROVED BY
DIRECTOR OF PUBLIC WORKS
DATE
R-160A
SHEET 1 OF 3
PROFILE
PLAN