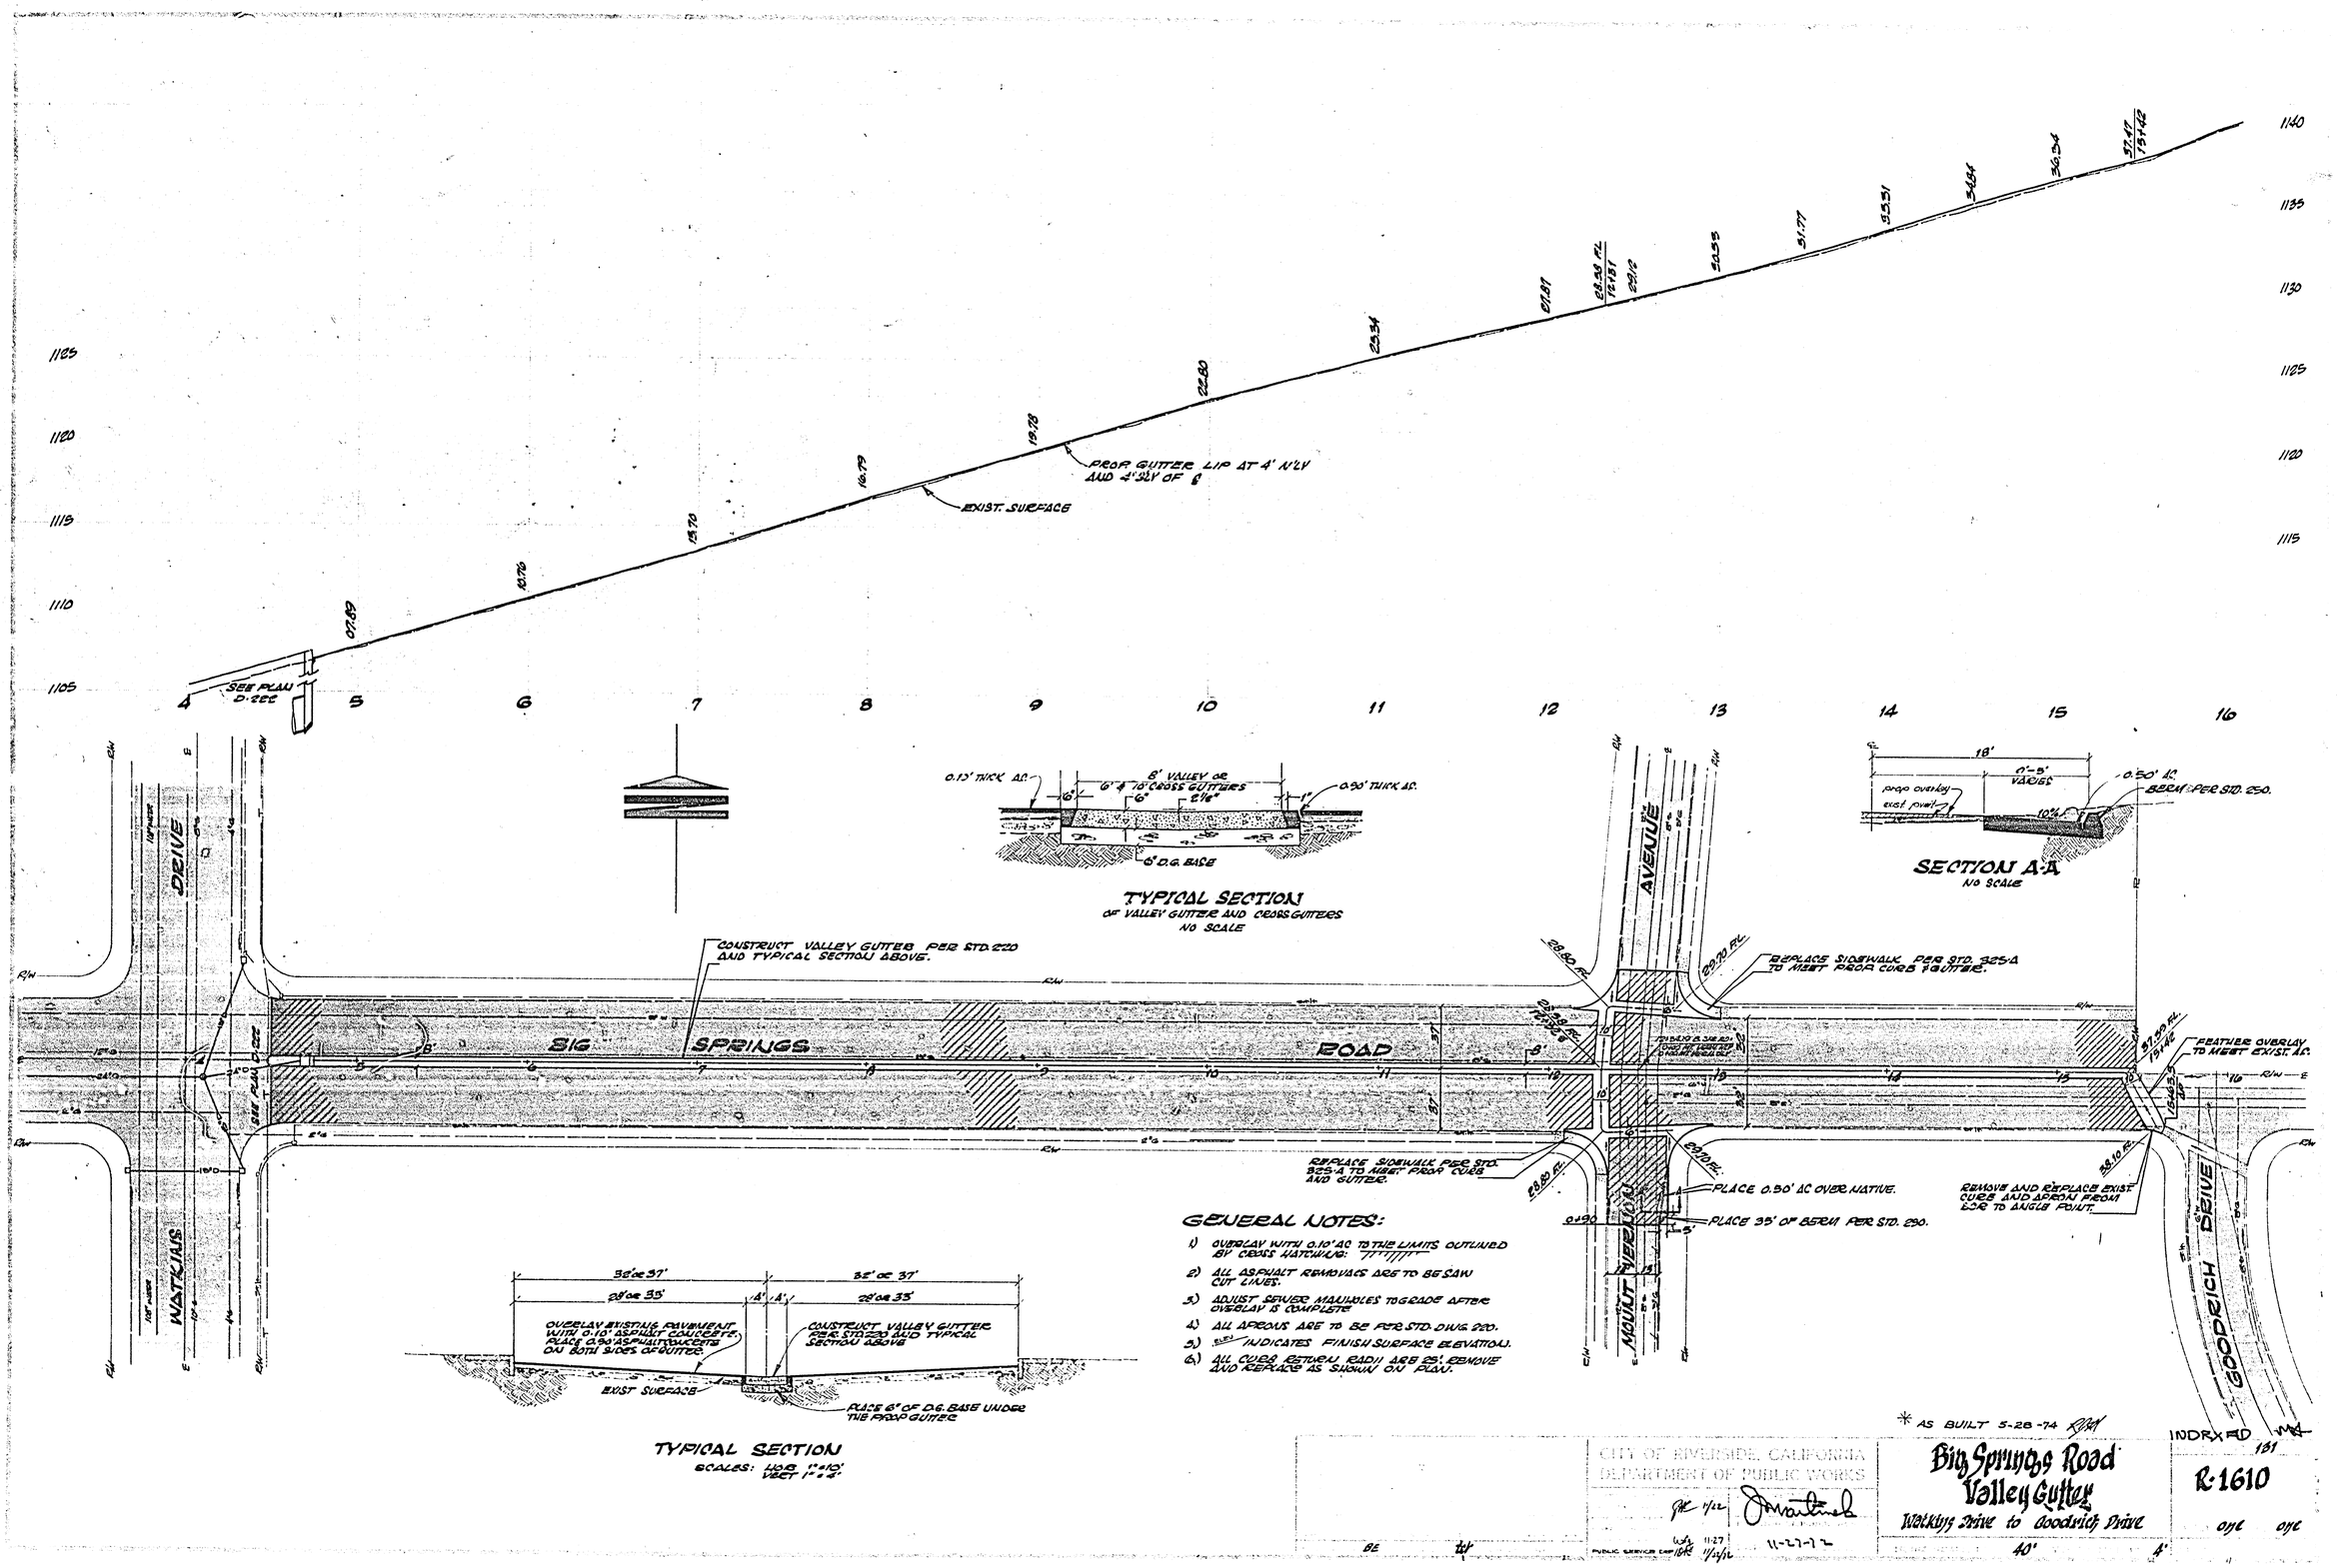

GENERAL NOTES:

1) OVERLAY WITH 0.10' AC TO THE LIMITS OUTLINED BY CROSS HATCHING:
2) ALL ASPHALT REMOVALS ARE TO BE SAW CUT LINES.
3) ADJUST SEWER MANHOLES TO GRADE AFTER OVERLAY IS COMPLETE
4) ALL APRONS ARE TO BE PER STD. DWG. 220.
5) INDICATES FINISH SURFACE ELEVATION.
6) ALL CURB RETURN RADII ARE 25'. REMOVE AND REPLACE AS SHOWN ON PLAN.

* AS BUILT 5-28-74

INDEXED

CITY OF RIVERSIDE, CALIFORNIA
DEPARTMENT OF PUBLIC WORKS

11-27-72

PUBLIC SERVICE DIR.

Big Springs Road Valley Gutter

Watkins Drive to Goodrich Drive

R-1610

40' 4'