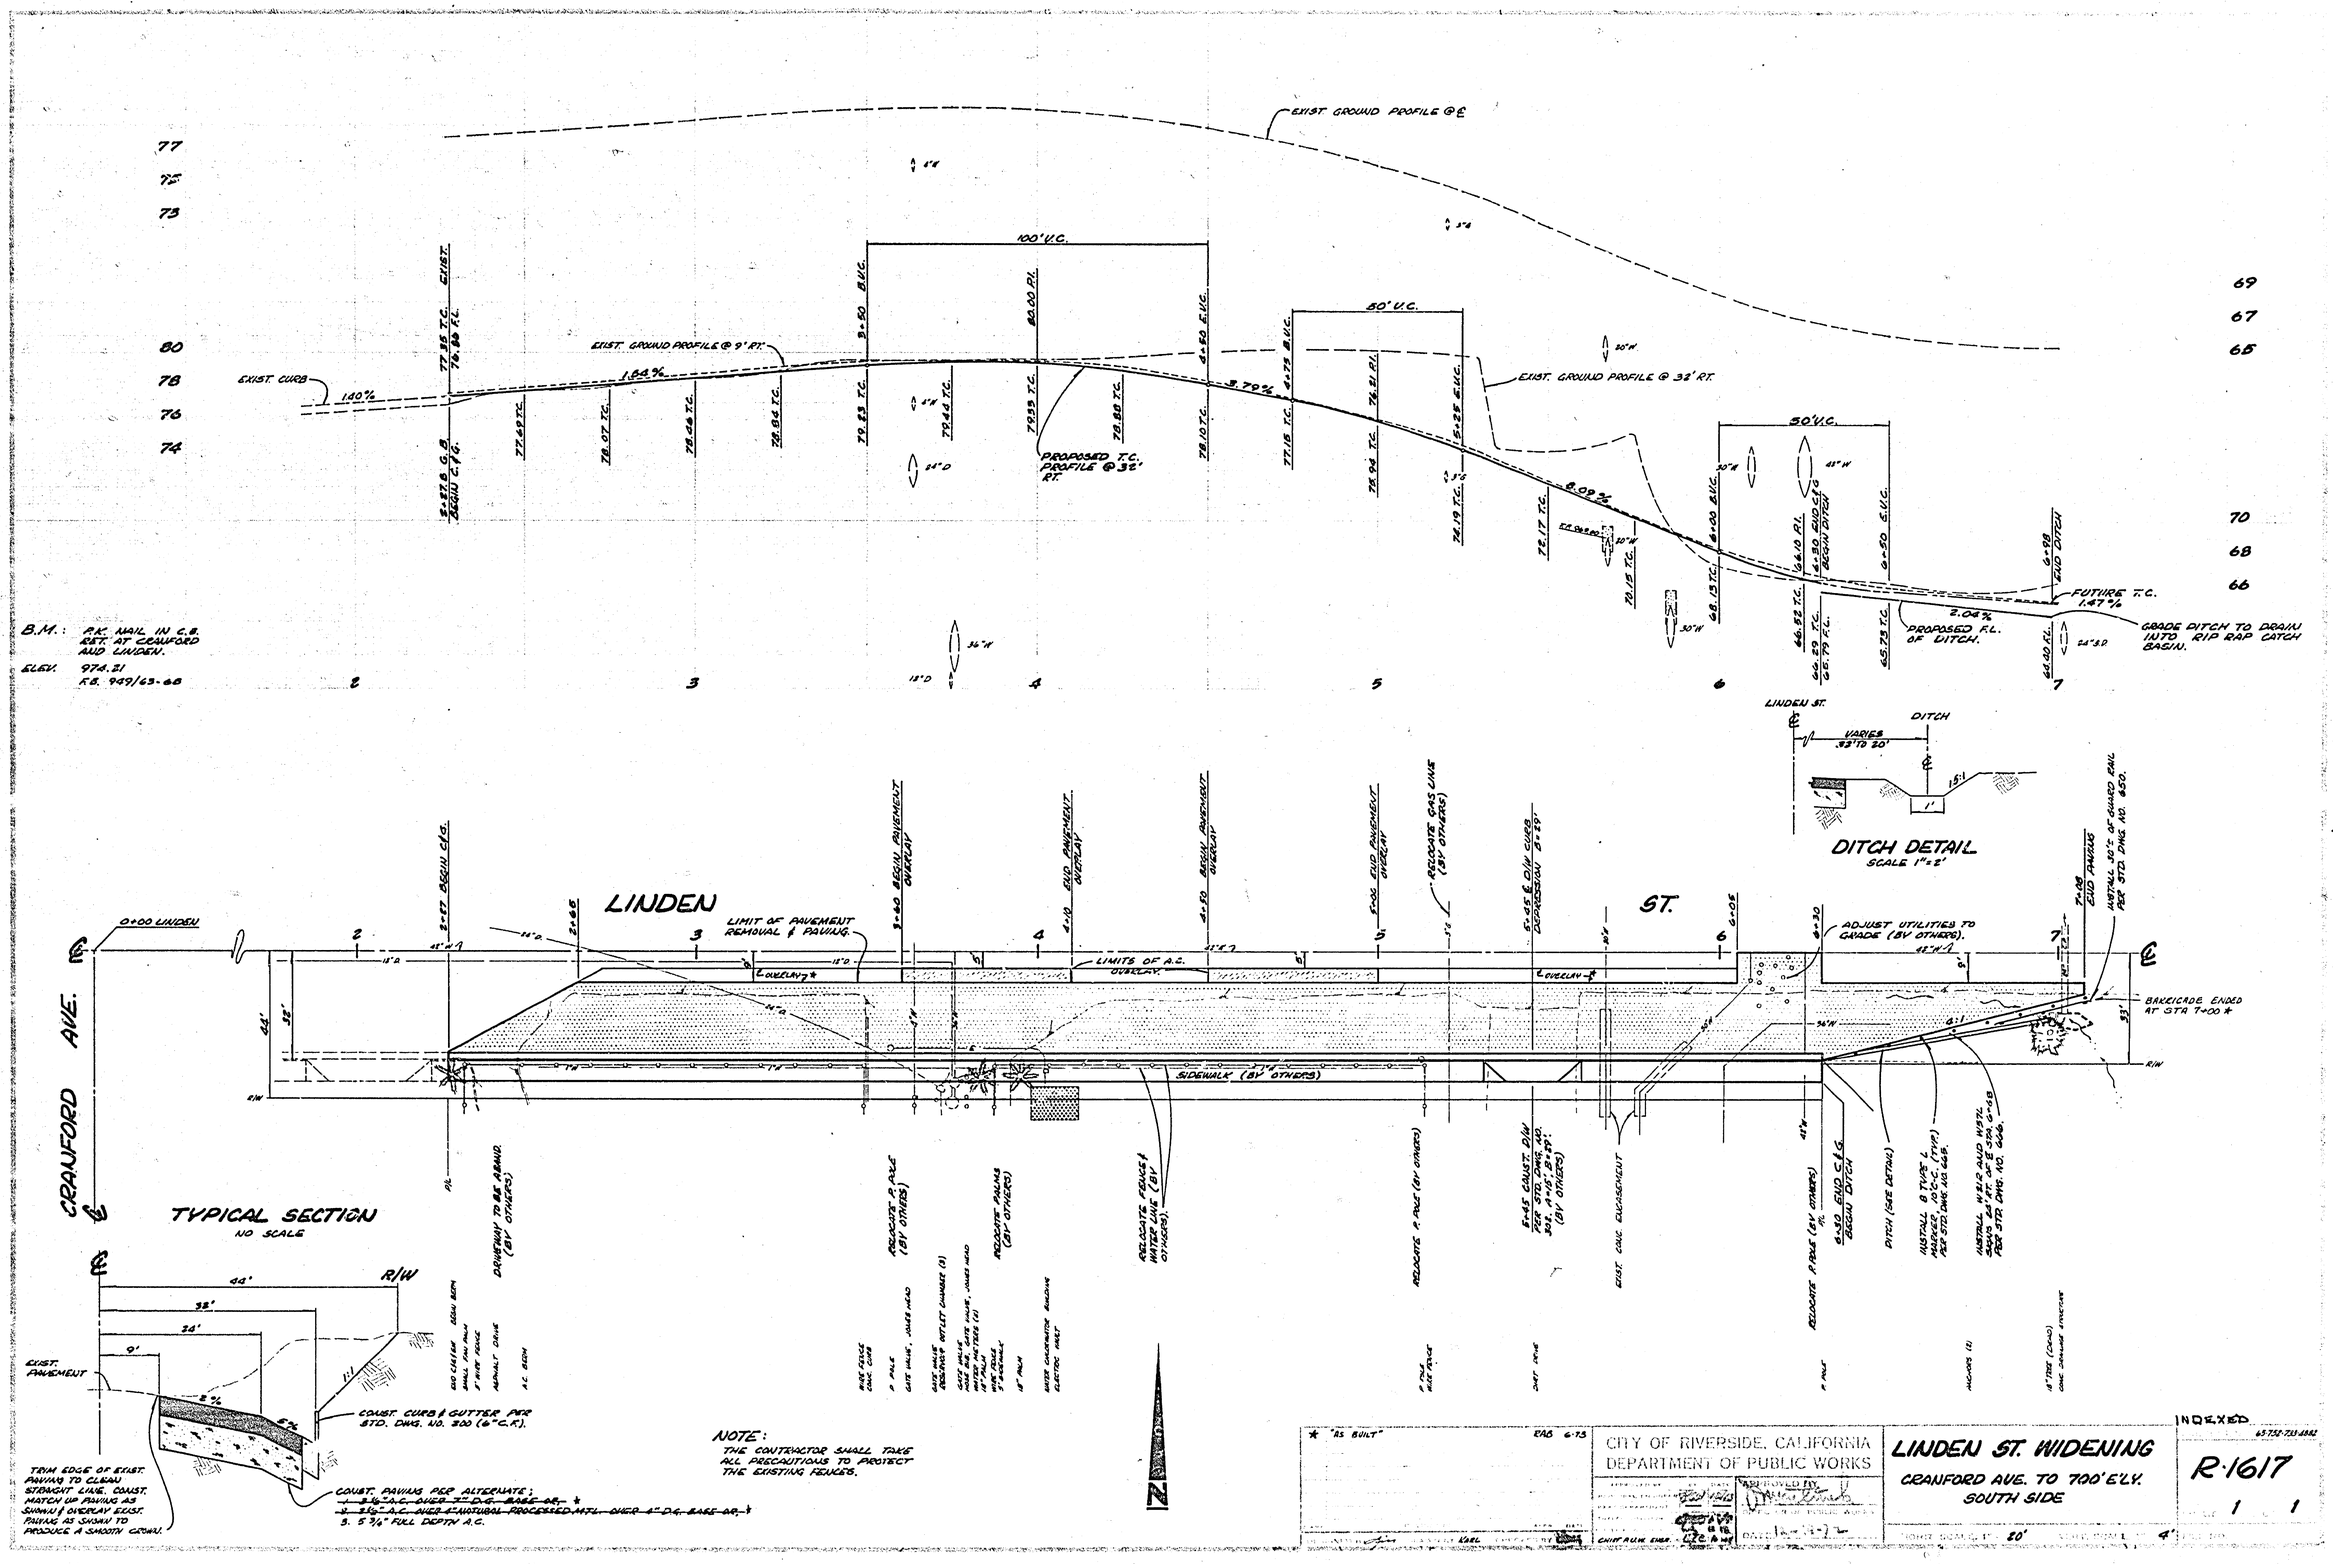

* "AS BUILT" RAB 6-73	CITY OF RIVERSIDE, CALIFORNIA DEPARTMENT OF PUBLIC WORKS	LINDEN ST. WIDENING CRANFORD AVE. TO 700' E'LY. SOUTH SIDE	INDEXED R-1617
		HORIZ. SCALE 1" = 20'	1 1