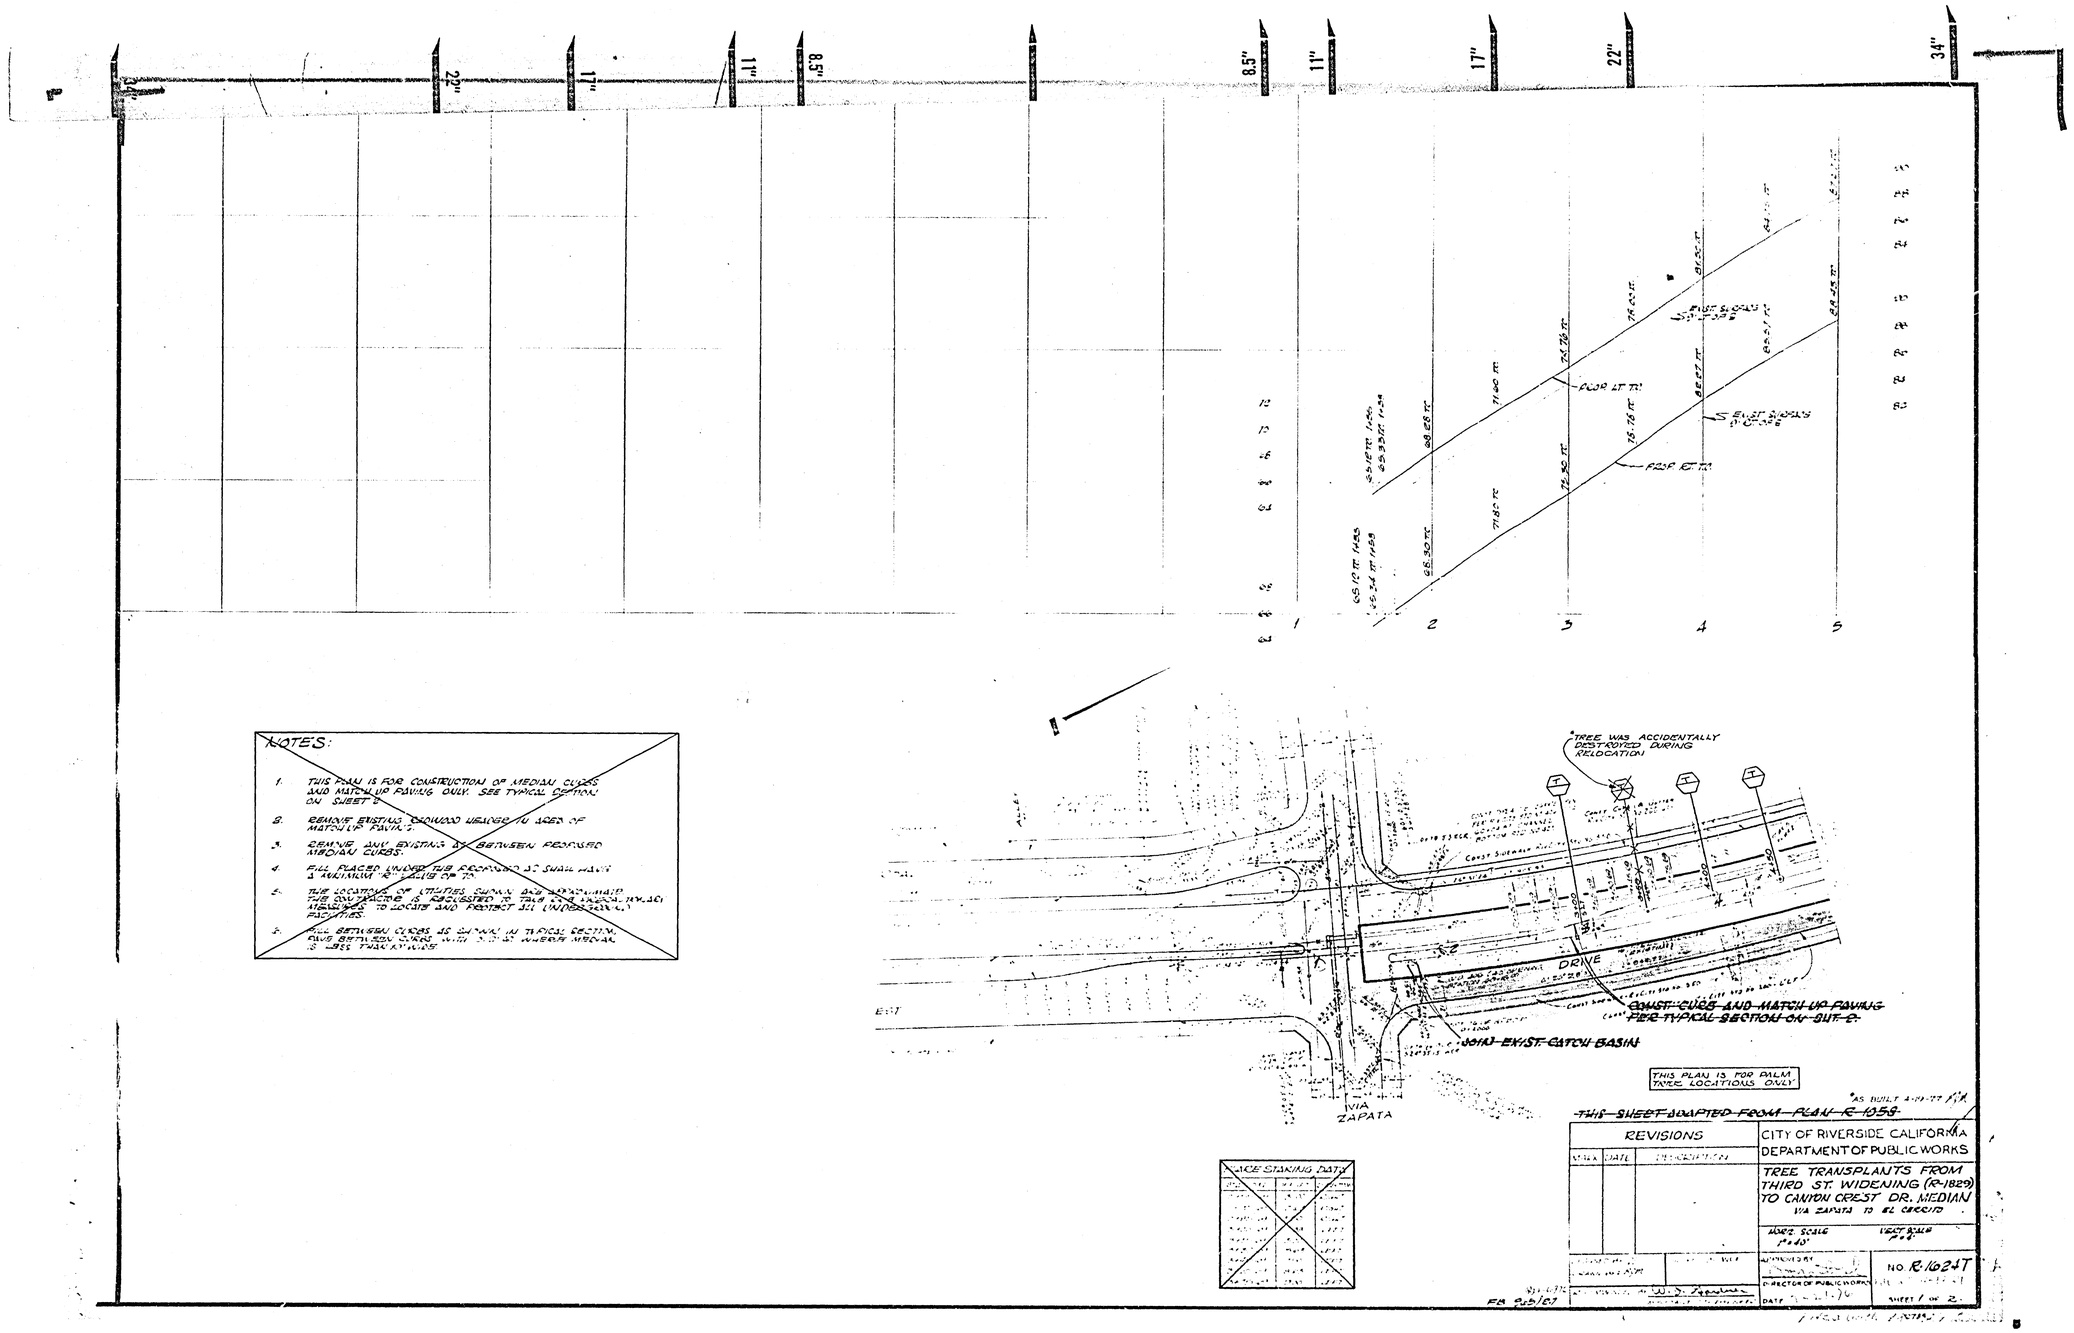

34"
22"
17"
11"
8.5"
8.5"
11"
17"
22"
34"
1
2
3
4
5
PROP. LT. TO
PROP. RT. TO
EXIST. SURFACE
NOTES:
1. THIS PLAN IS FOR CONSTRUCTION OF MEDIAN CURBS AND MATCH UP PAVING ONLY. SEE TYPICAL SECTION ON SHEET 2.
2. REMOVE EXISTING REDWOOD HEADER IN AREA OF MATCH UP PAVING.
3. REMOVE ANY EXISTING AS BETWEEN PROPOSED MEDIAN CURBS.
4. FILL PLACED UNDER THE PROPOSED AC SHALL HAVE A MINIMUM "R" VALUE OF 70.
5. THE LOCATIONS OF UTILITIES SHOWN ARE APPROXIMATE. THE CONTRACTOR IS REQUESTED TO TAKE FULL PRECAUTIONARY MEASURES TO LOCATE AND PROTECT ALL UNDERGROUND FACILITIES.
6. FILL BETWEEN CURBS AS SHOWN IN TYPICAL SECTION. PAVE BETWEEN CURBS WITH 0.0' AT WHERE MEDIAN IS LESS THAN 10' WIDE.
*TREE WAS ACCIDENTALLY DESTROYED DURING RELOCATION
DRIVE
CONST. CURB AND MATCH UP PAVING PER TYPICAL SECTION ON SHT. 2.
JOIN EXIST. CATCH BASIN
VIA ZAPATA
THIS PLAN IS FOR PALM TREE LOCATIONS ONLY
*AS BUILT 4-29-77
THIS SHEET ADAPTED FROM PLAN R-1058
PLACE STAKING DATA
REVISIONS
MARK
DATE
DESCRIPTION
CITY OF RIVERSIDE CALIFORNIA
DEPARTMENT OF PUBLIC WORKS
TREE TRANSPLANTS FROM THIRD ST. WIDENING (R-1829) TO CANYON CREST DR. MEDIAN
VIA ZAPATA TO EL CERRITO
HORIZ. SCALE 1"=40'
VERT. SCALE 1"=4'
APPROVED BY
DIRECTOR OF PUBLIC WORKS
DATE
NO. R-1624T
SHEET 1 OF 2.
FB 9-25-67

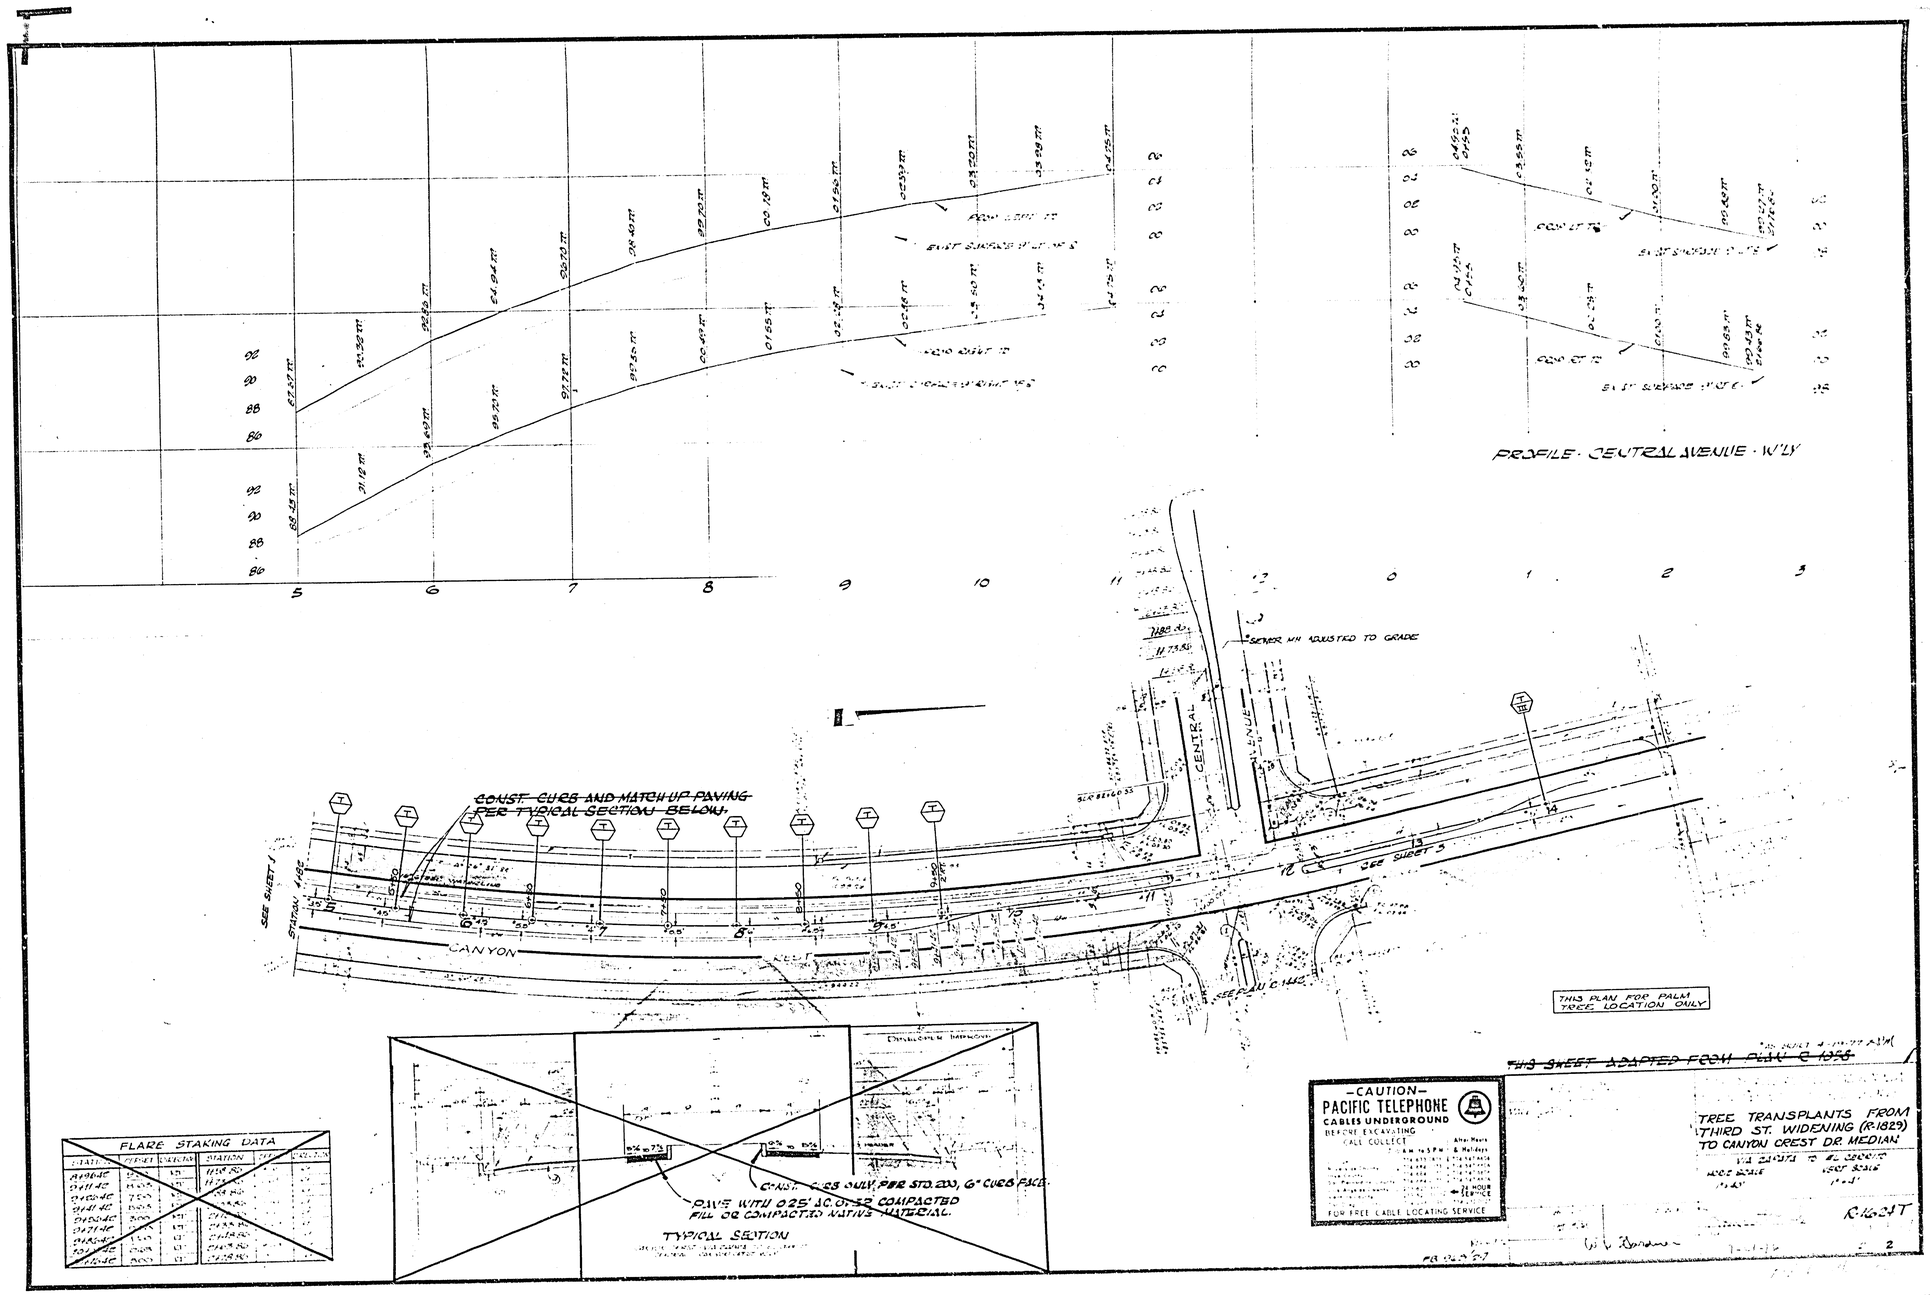
PROFILE · CENTRAL AVENUE · W'LY
SEWER MH ADJUSTED TO GRADE
CENTRAL
AVENUE
CANYON
SEE SHEET 1
SEE SHEET 3
CONST. CURB AND MATCH UP PAVING PER TYPICAL SECTION BELOW.
THIS PLAN FOR PALM TREE LOCATION ONLY
THIS SHEET ADAPTED FROM PLAN C-1058
-CAUTION-
PACIFIC TELEPHONE
CABLES UNDERGROUND
BEFORE EXCAVATING
CALL COLLECT
FOR FREE CABLE LOCATING SERVICE
TREE TRANSPLANTS FROM THIRD ST. WIDENING (R-1829) TO CANYON CREST DR. MEDIAN
R-1624T
FLARE STAKING DATA
CONST. CURB ONLY PER STD. 200, 6" CURB FACE.
PAVE WITH 0.25' AC. OVER COMPACTED FILL OR COMPACTED NATIVE MATERIAL.
TYPICAL SECTION