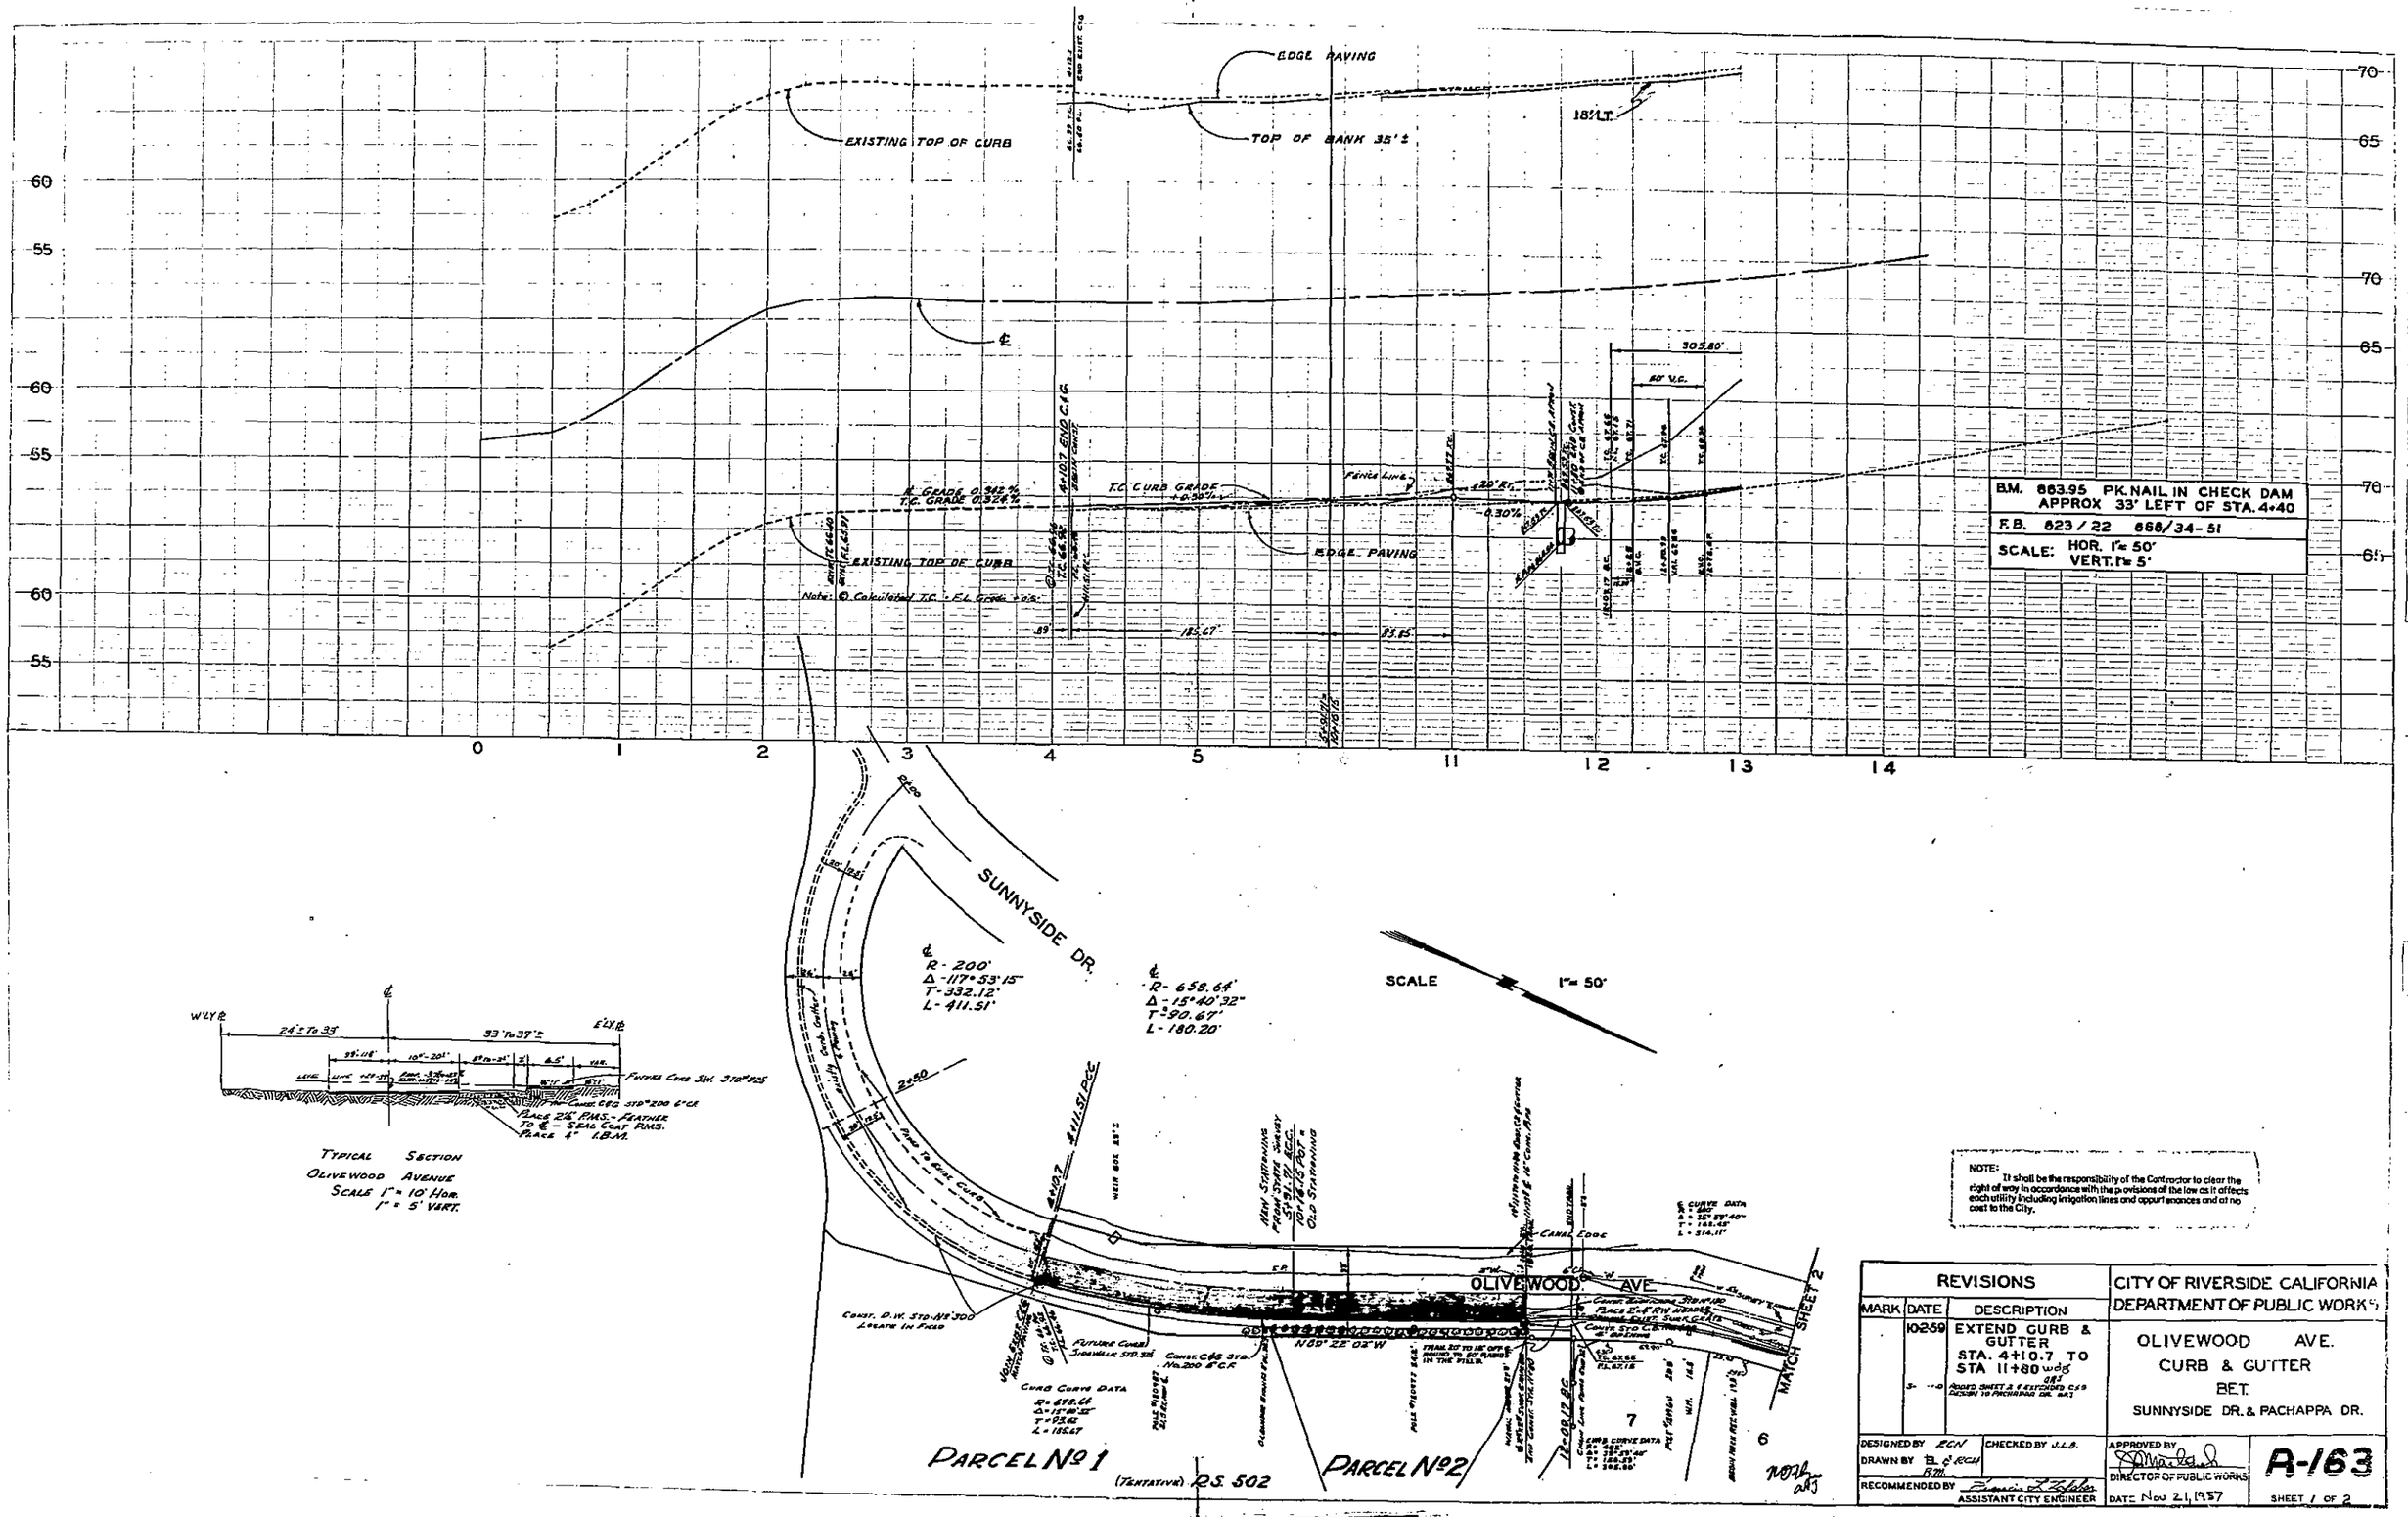

NOTE:
It shall be the responsibility of the Contractor to clear the right of way in accordance with the provisions of the law as it affects each utility including irrigation lines and appurtenances and at no cost to the City.

REVISIONS			CITY OF RIVERSIDE CALIFORNIA DEPARTMENT OF PUBLIC WORKS
MARK	DATE	DESCRIPTION	OLIVEWOOD AVE. CURB & GUTTER BET. SUNNYSIDE DR. & PACHAPPA DR.
	10-2-59	EXTEND CURB & GUTTER STA. 4+10.7 TO STA 11+80 wdg	
	3- -10	ADDED SHEET 2 & EXTENDED C&G DESIGN TO PACHAPPA DR.	

DESIGNED BY RCN
DRAWN BY B. C. RCH R.M.
CHECKED BY J.L.B.
RECOMMENDED BY Francis L. Zeller ASSISTANT CITY ENGINEER
APPROVED BY [signature] DIRECTOR OF PUBLIC WORKS
DATE Nov 21, 1957
A-163
SHEET 1 OF 2

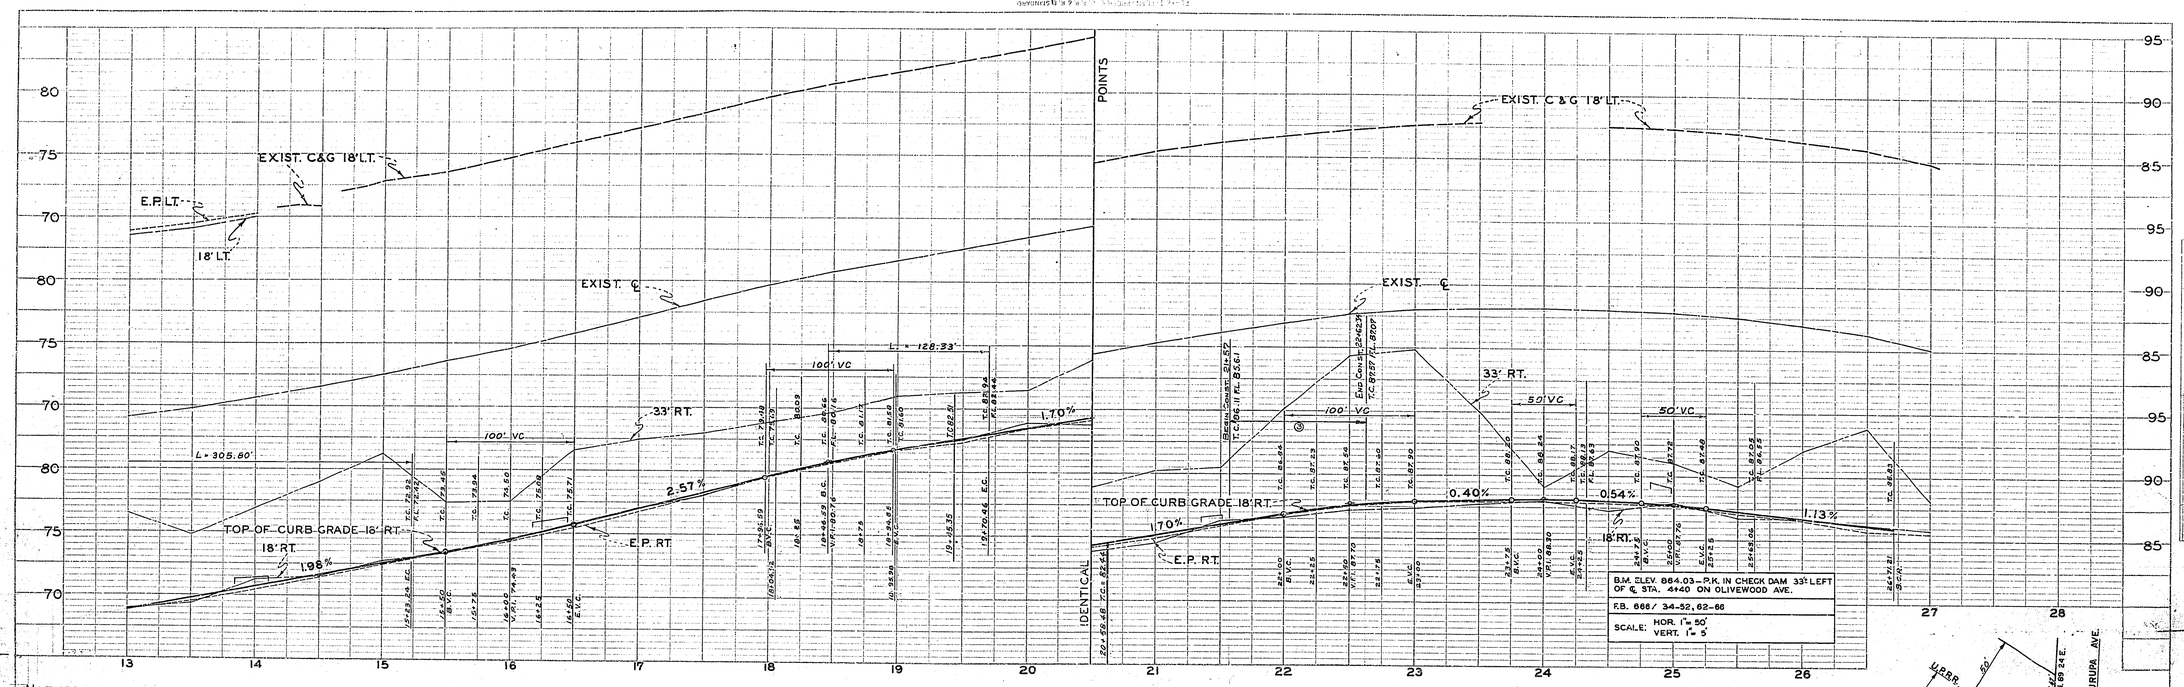

NOTES:

1. ALL CONSTRUCTION SHALL BE IN ACCORDANCE WITH STANDARDS AND SPECIFICATIONS NO. 461 OF THE CITY OF RIVERSIDE, DEPARTMENT OF PUBLIC WORKS.
2. TRIM EDGE OF PAVING TO CLEAN STRAIGHT LINE. CONSTRUCT MATCH UP PAVING AS SHOWN AND OVERLAY EXISTING PAVING AS DIRECTED IN THE FIELD TO PRODUCE A SMOOTH CROWN SECTION.
3. IT SHALL BE THE RESPONSIBILITY OF THE CONTRACTOR TO CLEAR THE RIGHT OF WAY IN ACCORDANCE WITH THE PROVISIONS OF THE LAW AS IT AFFECTS EACH UTILITY, INCLUDING IRRIGATION LINES AND APPURTENANCES, AND AT NO COST TO THE CITY.
4. PRIME COAT, PAINT BINDER, AND SEAL COAT WILL BE REQUIRED.
5. CONSTRUCT DRIVEWAY APPROACH PER STANDARD DRAWING NO. 302 FOR CURB TYPE SIDEWALK. LOCATION TO BE DETERMINED BY THE PROPERTY OWNER. A = 10', B = 17'

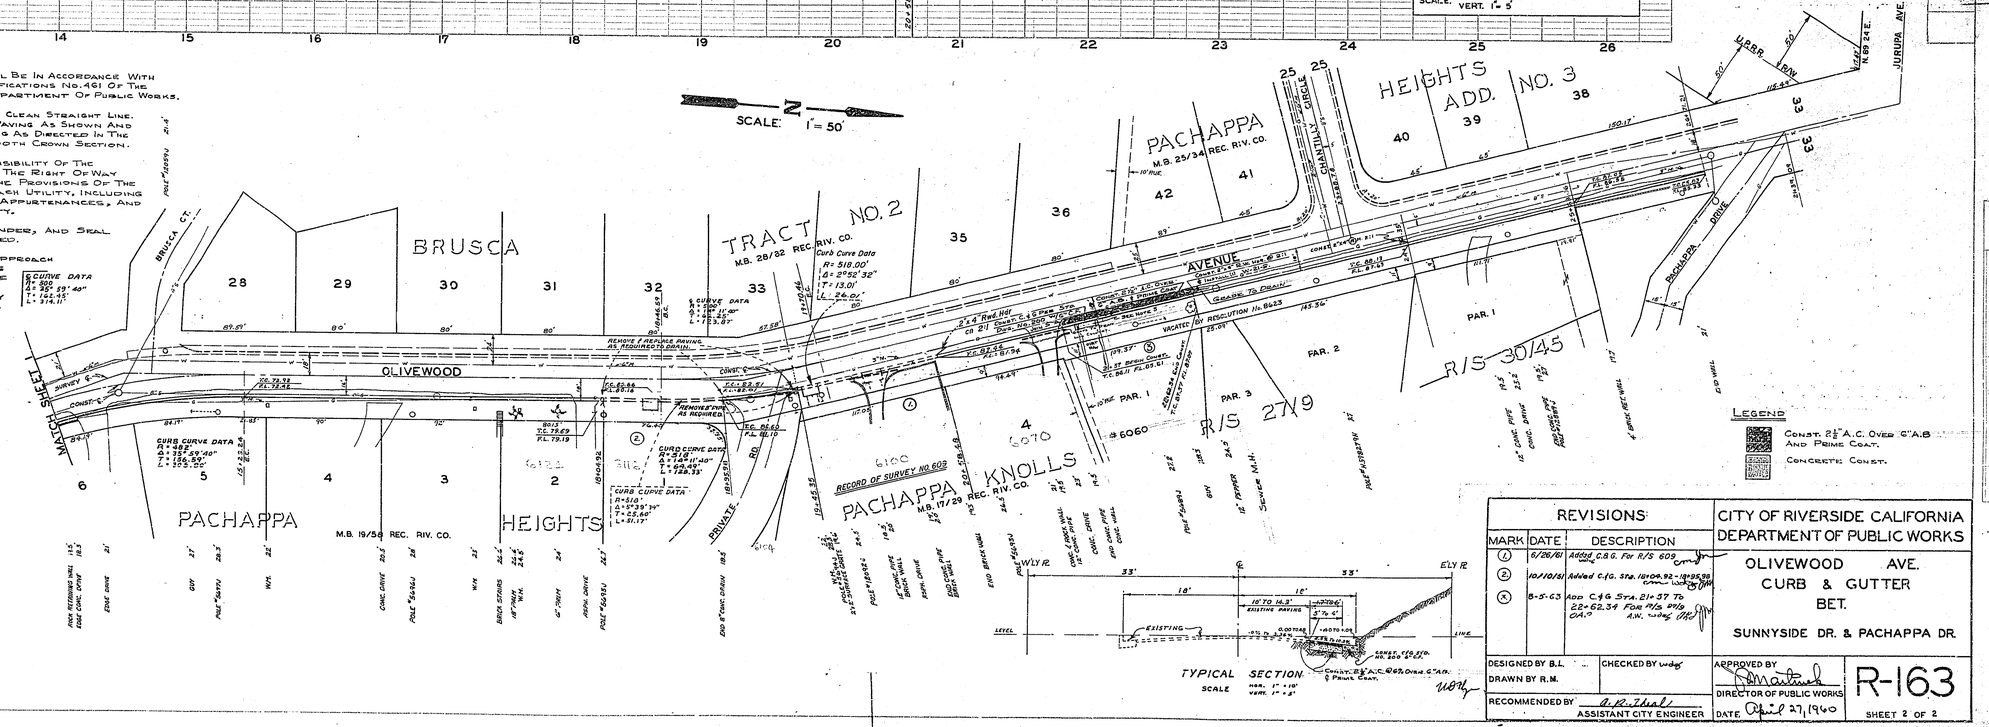

REVISIONS		
MARK	DATE	DESCRIPTION
1	6/26/61	Added C.&G. For R/S 609
2	10/10/61	Added C.&G. Sta. 18+09.92 - 18+95.98
X	8-5-63	Add C.&G. Sta. 21+57 To 22+62.34 For R/S 27/9 OA.? A.W.

CITY OF RIVERSIDE CALIFORNIA
DEPARTMENT OF PUBLIC WORKS

OLIVEWOOD AVE.
CURB & GUTTER
BET.
SUNNYSIDE DR. & PACHAPPA DR.

DESIGNED BY B.L. CHECKED BY
DRAWN BY R.M.
RECOMMENDED BY A. R. Theal ASSISTANT CITY ENGINEER
APPROVED BY DIRECTOR OF PUBLIC WORKS
DATE April 27, 1960

R-163
SHEET 2 OF 2

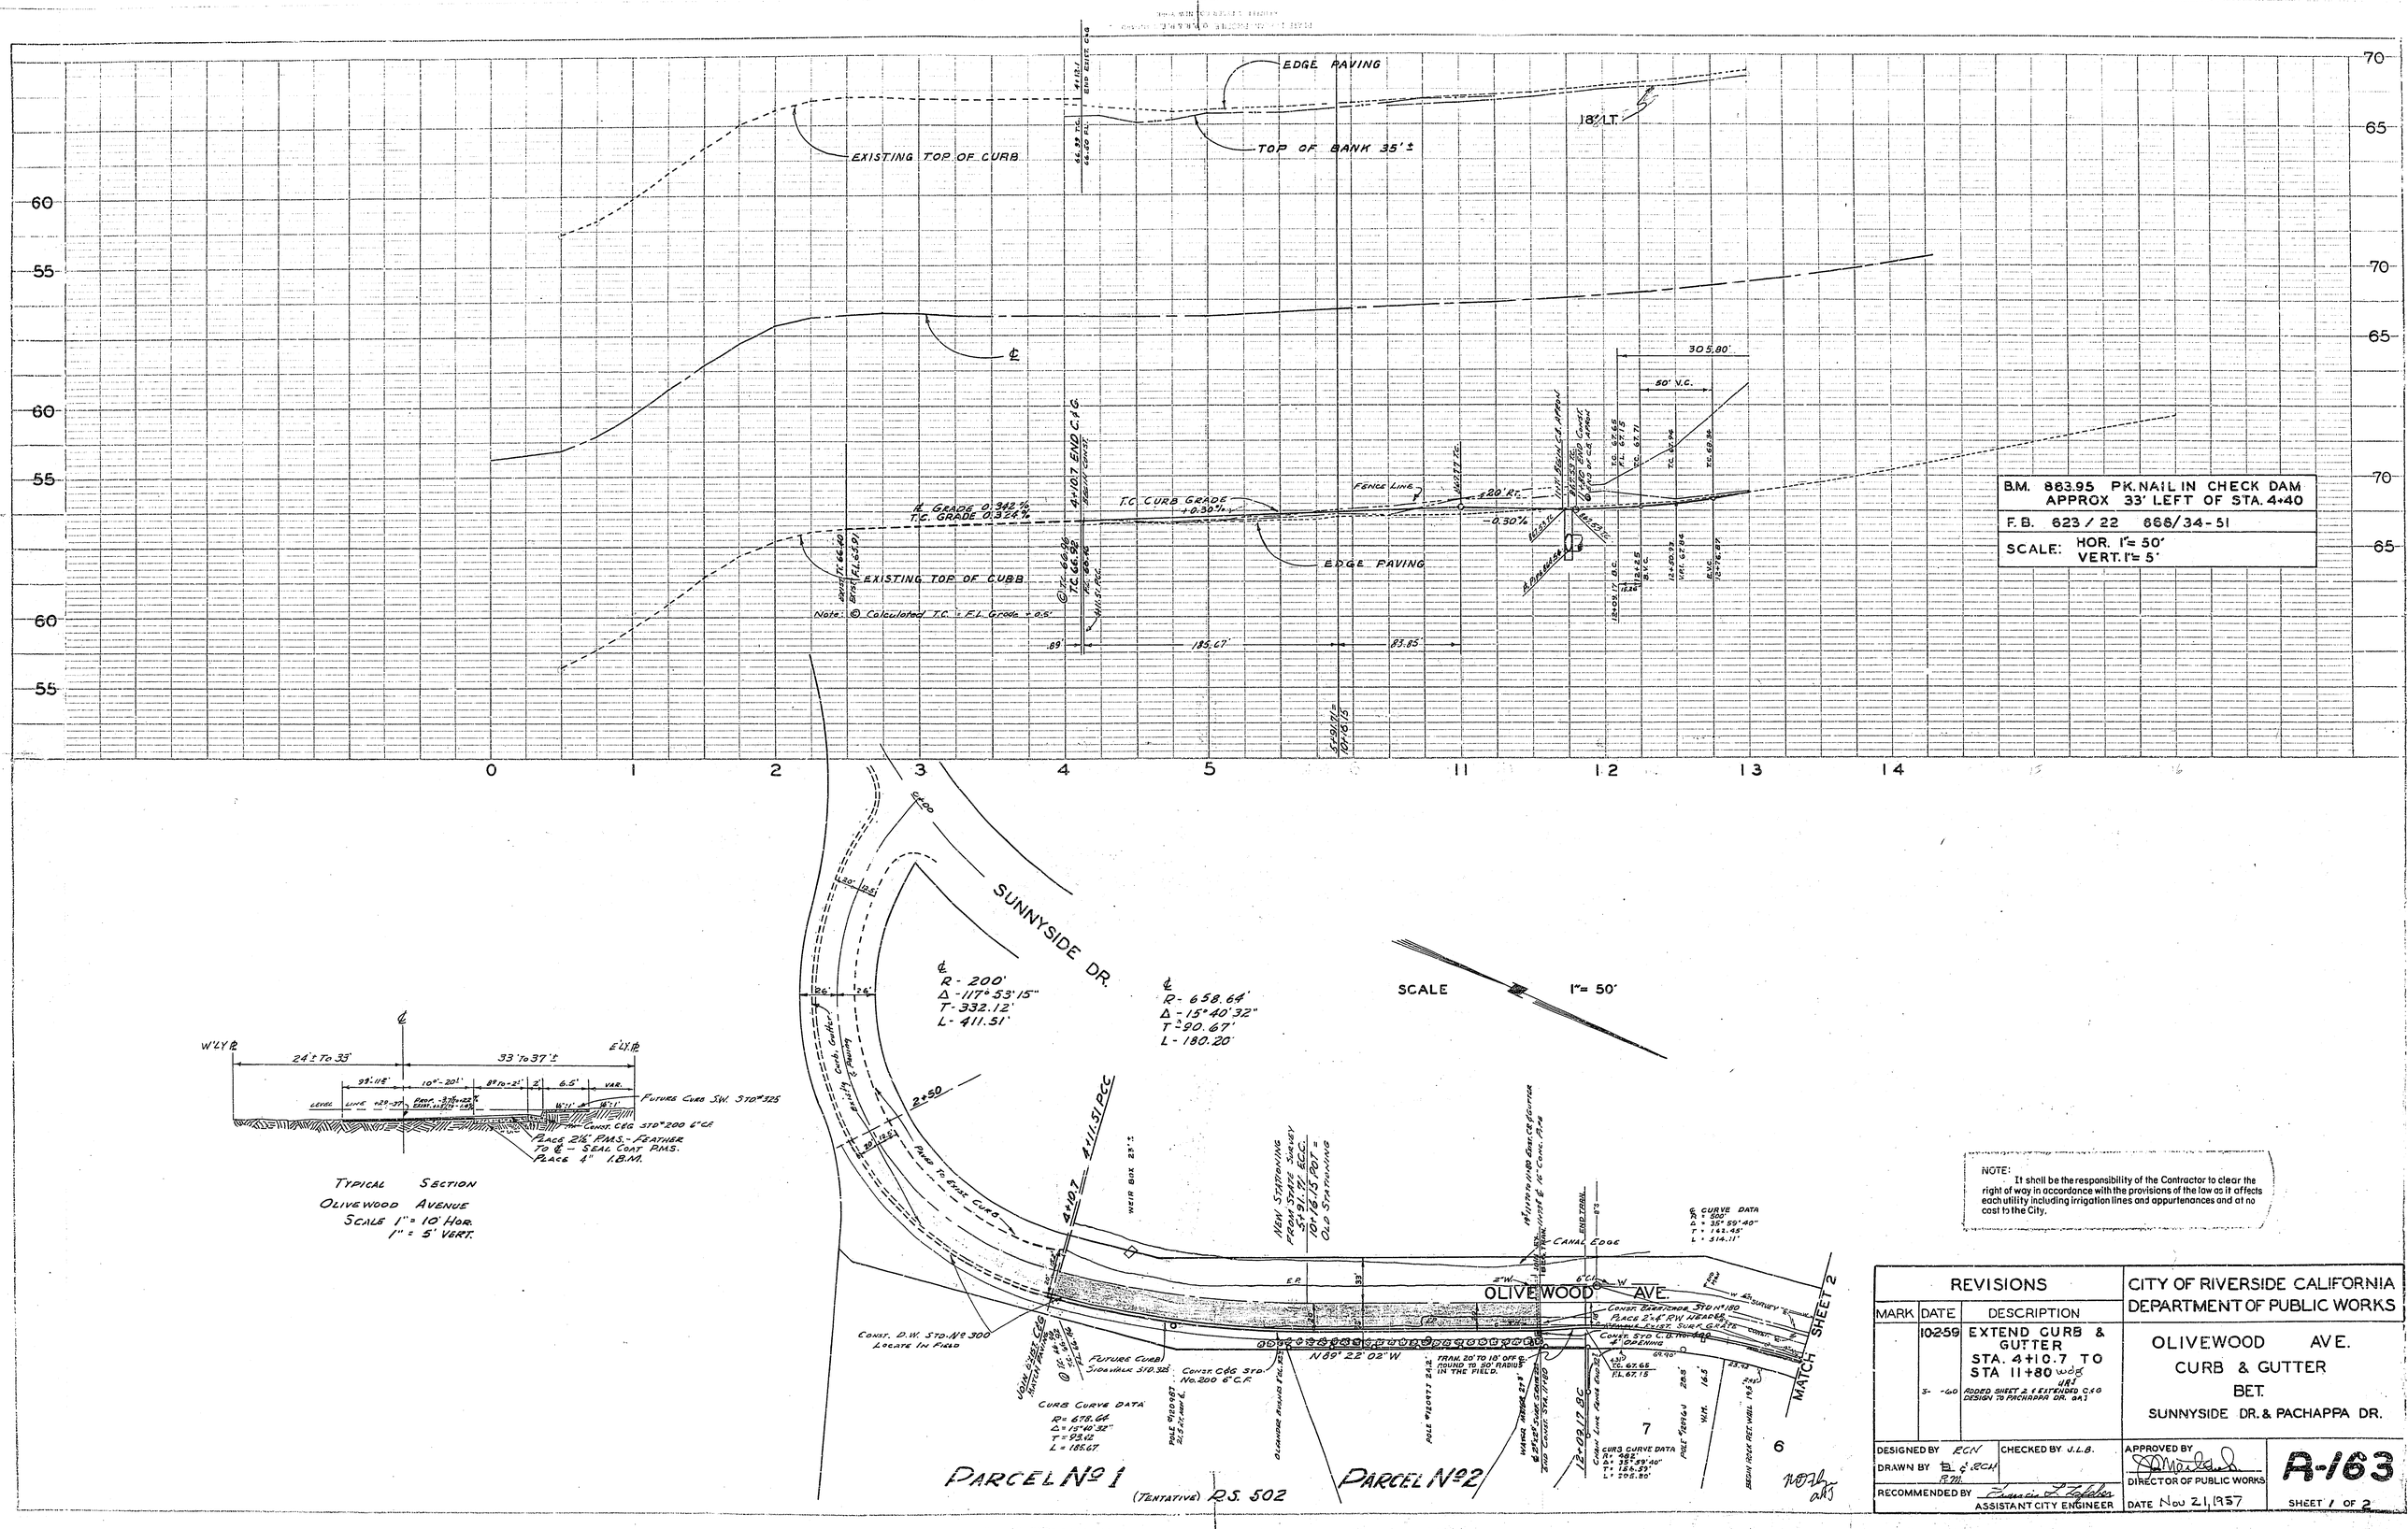

TYPICAL SECTION
OLIVEWOOD AVENUE
SCALE 1" = 10' HOR.
1" = 5' VERT.

NOTE:
It shall be the responsibility of the Contractor to clear the right of way in accordance with the provisions of the law as it affects each utility including irrigation lines and appurtenances and at no cost to the City.

REVISIONS			CITY OF RIVERSIDE CALIFORNIA DEPARTMENT OF PUBLIC WORKS
MARK	DATE	DESCRIPTION	OLIVEWOOD AVE. CURB & GUTTER BET. SUNNYSIDE DR. & PACHAPPA DR.
	10-2-59	EXTEND CURB & GUTTER STA. 4+10.7 TO STA 11+80 w&g	
	3- -60	ADDED SHEET 2 & EXTENDED C&G DESIGN TO PACHAPPA DR.	

DESIGNED BY RCN
DRAWN BY R.C.H. R.M.
CHECKED BY J.L.B.
RECOMMENDED BY Francis L. Lefebvre ASSISTANT CITY ENGINEER
APPROVED BY [signature] DIRECTOR OF PUBLIC WORKS
DATE Nov 21, 1957
R-163
SHEET 1 OF 2