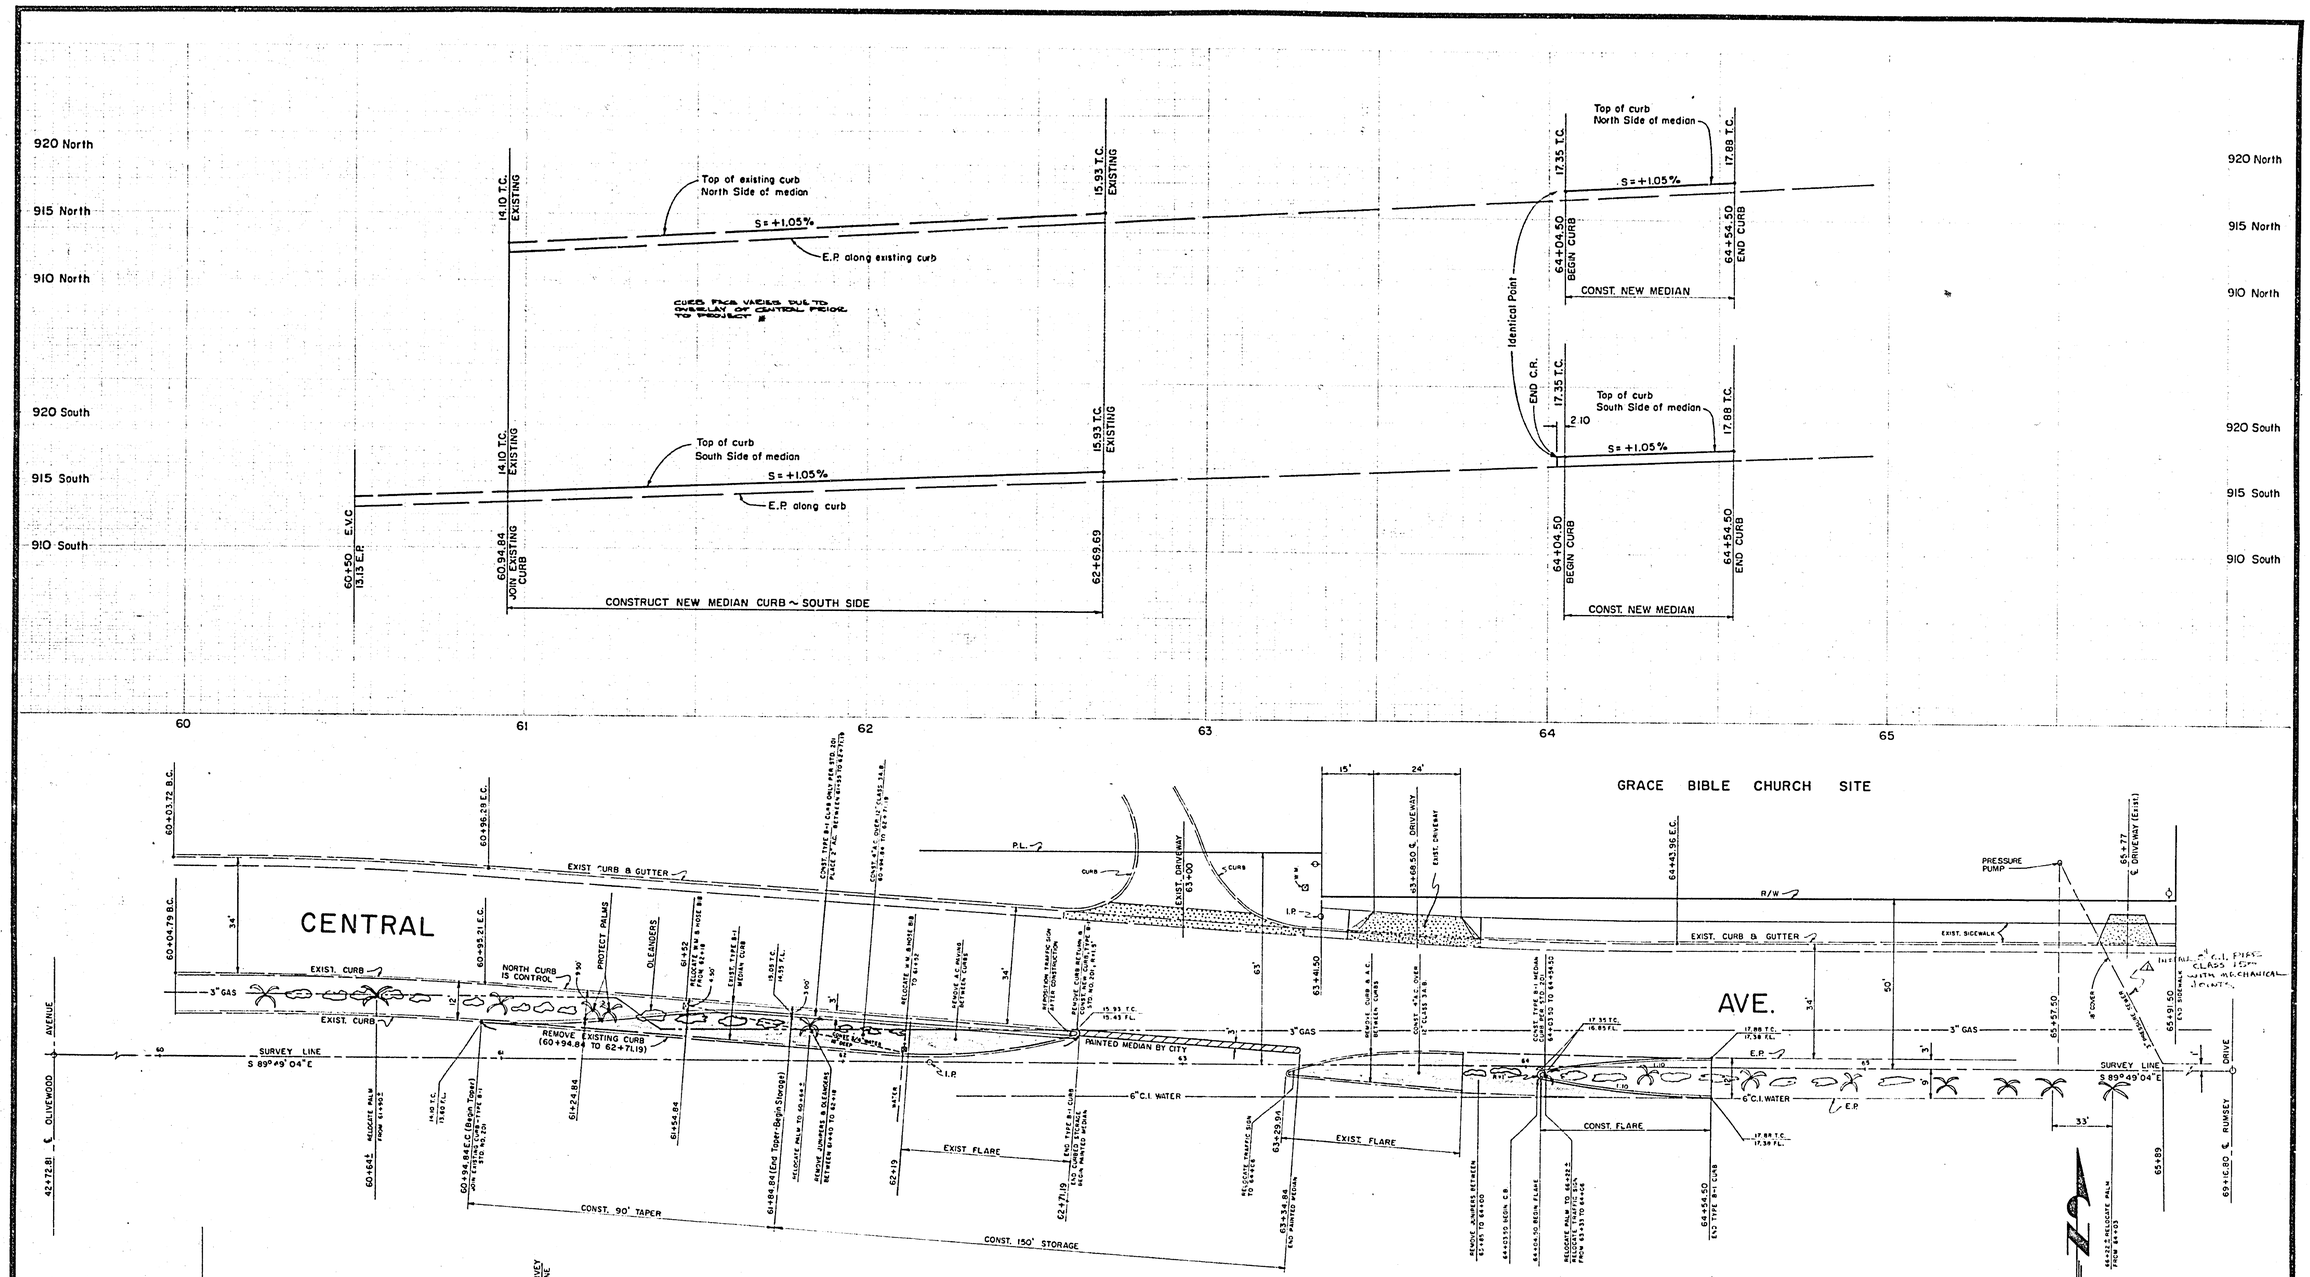

SEE D-266 FOR S.D. ON CENTRAL FROM RIVERSIDE AVE. TO RUMSEY DR.

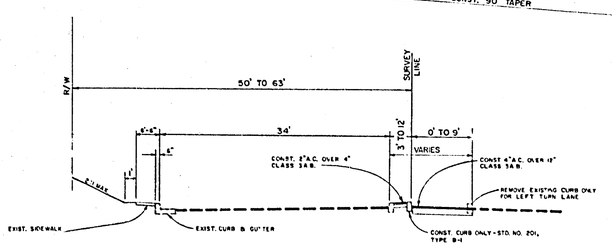

TYPICAL SECTION
CENTRAL AVENUE
NO SCALE

CONSTRUCTION NOTES:

1. All construction shall be in accordance with Standard Specifications for Pubic Works Construction 1970 Edition, and per City of Riverside Standard Drawings.
2. All flagged elevations shall be staked in the field by the engineer.

NOTE:
SEE DWG. NO. R-112 SHT. 3 of 9 FOR REFERENCE.

B.M. ELEV. 922.015 PK. NAIL IN S.W. CURB RET. RUMSEY & CENTRAL F.B. 609/33, 677/9

NEAL L. SMITHHAMMER
Neal L. Smithhammer
R.C.E. 16757 Date: 29 NOV 71

MARK	REVISIONS	APPR.	DATE
A	ADDED C.I. PIPE REQUIREMENT PER		

DESIGNED BY ____ DRAWN BY R.A.L. CHECKED BY W

CITY OF RIVERSIDE, CALIFORNIA
DEPARTMENT OF PUBLIC WORKS

APPROVED BY	BY	DATE
OFFICE ENGINEER		
PARK DEPARTMENT		
TRAFFIC DIVISION		
ASSISTANT CITY ENG.		

APPROVED BY
DIRECTOR OF PUBLIC WORKS
DATE 12/28/72

STREET PLAN AND PROFILE
CENTRAL AVENUE
BETWEEN OLIVEWOOD & RUMSEY AVENUE
FOR C-35-689
HORIZ. SCALE: 1" - 20' VERT. SCALE: 1" - 4"

INDEXED MR
PROJECT NO. R-1634
SHEET 1 OF 1
FILE NO.