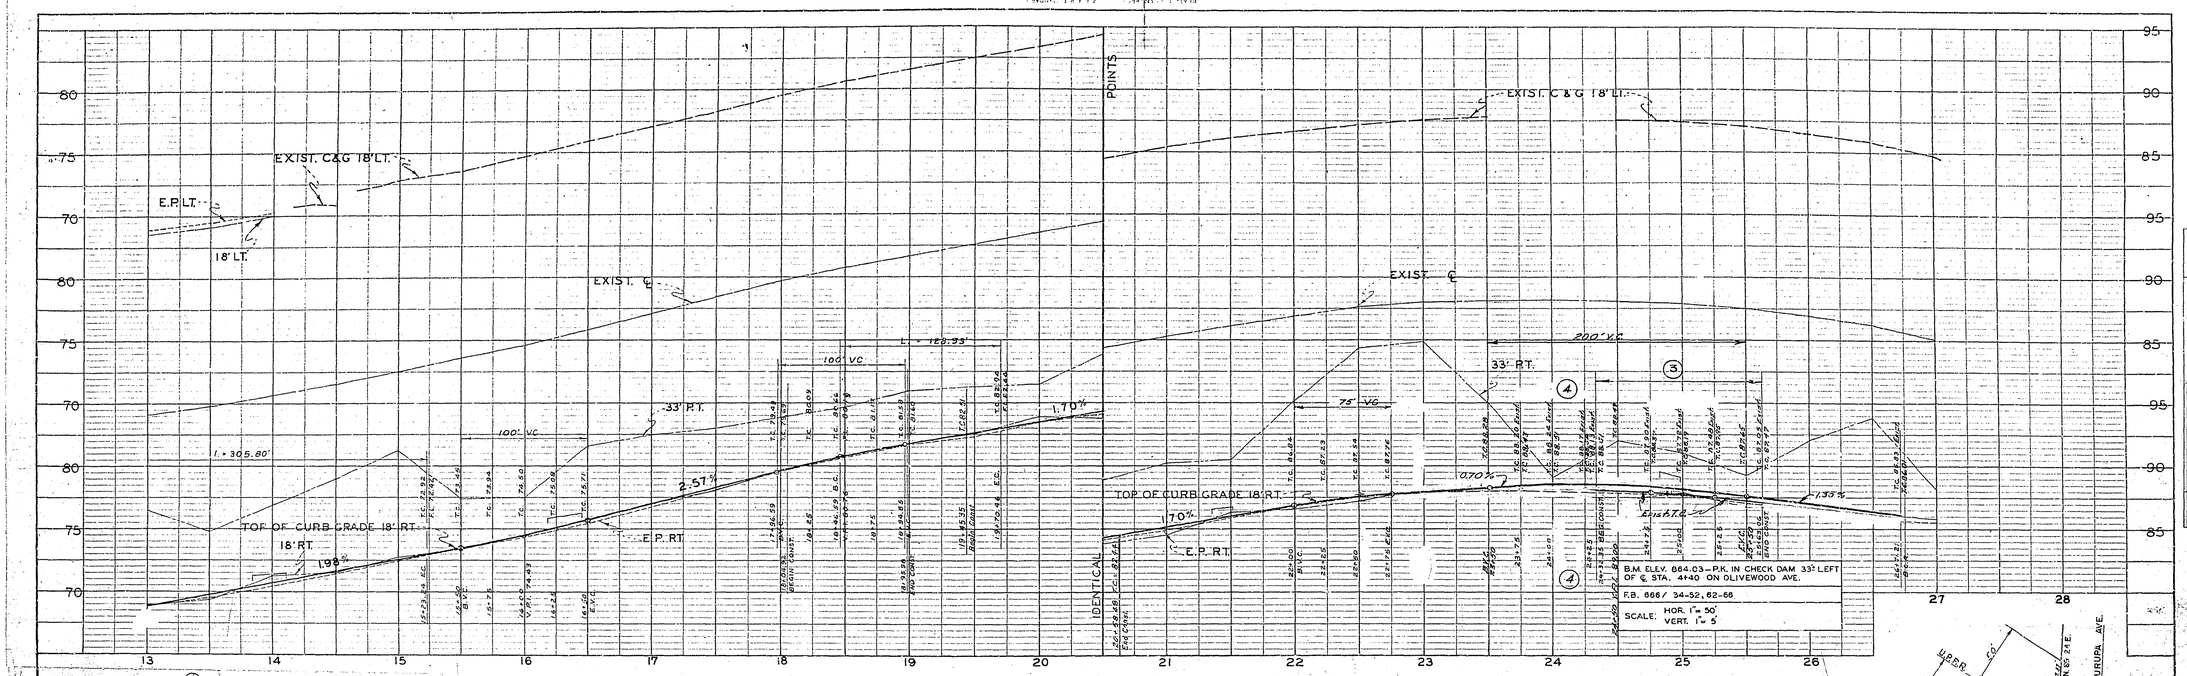

③ NOTES

1. The Contractor shall comply with all applicable portions of the City of Riverside Standard Specifications No. 461, including the requirements for insurance and bonds Sec. 1(1:16, 1:17)
2. The Contractor shall be allowed 15 calendar days, after notice to begin is given by the City Engineer, to complete the project.
3. Liquidated damages shall be in the amount of $25.00 per day.
4. Olivewood Avenue shall remain open to traffic at all times.
5. Match up Asphalt Concrete paving shall require a prime coat & paint binder.

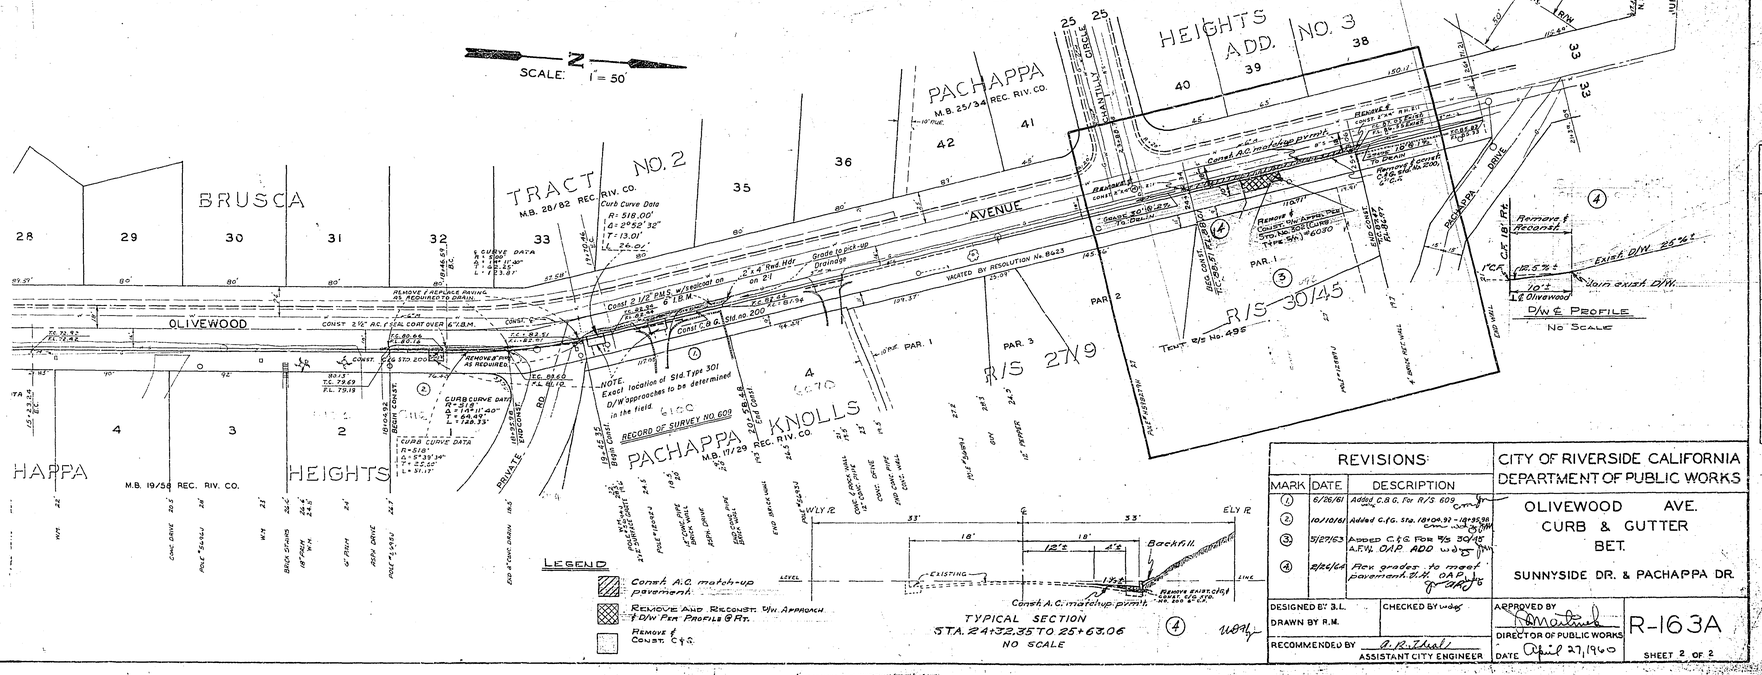

REVISIONS		
MARK	DATE	DESCRIPTION
①	6/26/61	Added C.&G. for R/S 609
②	10/10/61	Added C.&G. Sta. 18+04.97 - 18+95.98
③	5/27/63	Added C.&G. for R/S 30/45 A.F.W. OAP ADD
④	2/26/64	Rev. grades to meet pavement. U.H. OAP

CITY OF RIVERSIDE CALIFORNIA
DEPARTMENT OF PUBLIC WORKS

OLIVEWOOD AVE.
CURB & GUTTER
BET.
SUNNYSIDE DR. & PACHAPPA DR.

DESIGNED BY: B.L.
DRAWN BY: R.M.
CHECKED BY: wdg
RECOMMENDED BY: A. R. Thiel, ASSISTANT CITY ENGINEER
APPROVED BY: [signature], DIRECTOR OF PUBLIC WORKS
DATE: April 27, 1960

R-163A
SHEET 2 OF 2