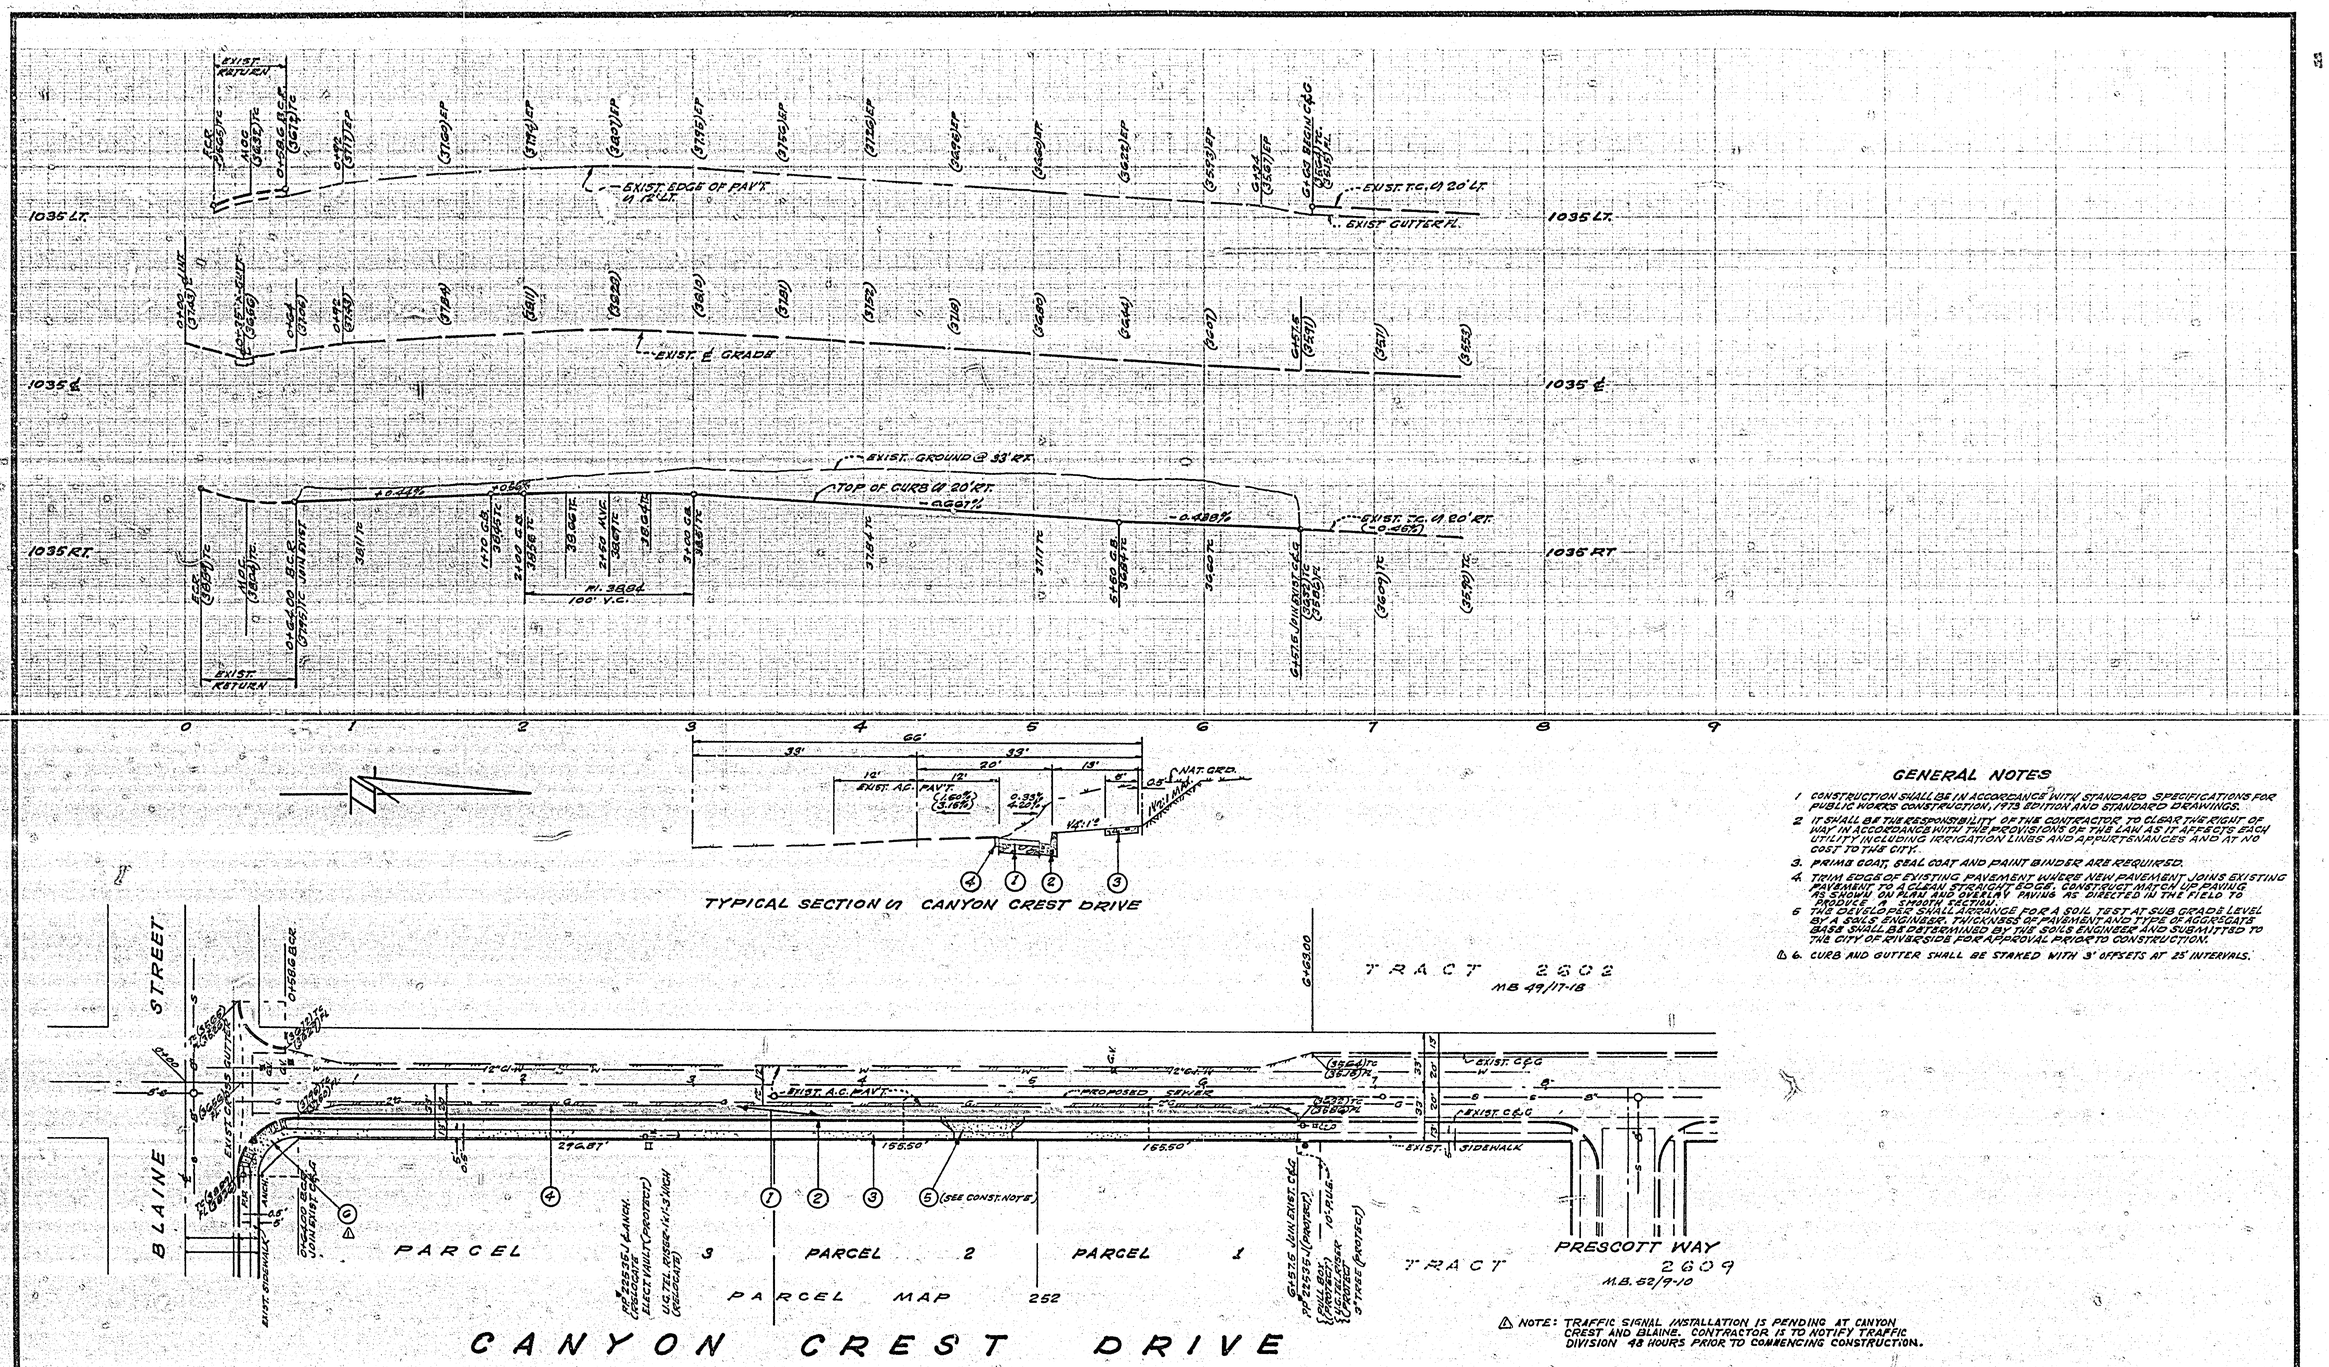

GENERAL NOTES

1. CONSTRUCTION SHALL BE IN ACCORDANCE WITH STANDARD SPECIFICATIONS FOR PUBLIC WORKS CONSTRUCTION, 1973 EDITION AND STANDARD DRAWINGS.
2. IT SHALL BE THE RESPONSIBILITY OF THE CONTRACTOR TO CLEAR THE RIGHT OF WAY IN ACCORDANCE WITH THE PROVISIONS OF THE LAW AS IT AFFECTS EACH UTILITY INCLUDING IRRIGATION LINES AND APPURTENANCES AND AT NO COST TO THE CITY.
3. PRIME COAT, SEAL COAT AND PAINT BINDER ARE REQUIRED.
4. TRIM EDGE OF EXISTING PAVEMENT WHERE NEW PAVEMENT JOINS EXISTING PAVEMENT TO A CLEAN STRAIGHT EDGE. CONSTRUCT MATCH UP PAVING AS SHOWN ON PLAN AND OVERLAY PAVING AS DIRECTED IN THE FIELD TO PRODUCE A SMOOTH SECTION.
5. THE DEVELOPER SHALL ARRANGE FOR A SOIL TEST AT SUB GRADE LEVEL BY A SOILS ENGINEER. THICKNESS OF PAVEMENT AND TYPE OF AGGREGATE BASE SHALL BE DETERMINED BY THE SOILS ENGINEER AND SUBMITTED TO THE CITY OF RIVERSIDE FOR APPROVAL PRIOR TO CONSTRUCTION.
6. CURB AND GUTTER SHALL BE STAKED WITH 3' OFFSETS AT 25' INTERVALS.

NOTE: TRAFFIC SIGNAL INSTALLATION IS PENDING AT CANYON CREST AND BLAINE. CONTRACTOR IS TO NOTIFY TRAFFIC DIVISION 48 HOURS PRIOR TO COMMENCING CONSTRUCTION.

CONSTRUCTION NOTES

1. CONST. 3" A.C. OVER [illegible] COMPACTED NATIVE
2. CONST. CURB & GUTTER (G'C.F.) PER STD. No 200.
3. CONST. PROPERTY LINE SIDEWALK PER STD. No 350.
4. REMOVE EXIST. 2"x4" RDWD. HDR.
5. CONST. DRIVEWAY APPROACH PER STD. # 302 (SIZE & LOCATION TO BE DETERMINED BY OWNER, AND TO BE APPROVED BY THE TRAFFIC ENGINEER.)
6. CONST. WHEEL CHAIR RAMP PER STD. No 304.

BENCH MARK
CHIS. "D" B.C.R., S.E. CURB RETURN, CANYON CREST DR. & BLAINE ST. - PER C/R BLAINE ST. B.M. SHEET.
ELEV. 1037.89

HAWKINS, ROBERTSON & ASSOC.
ENGINEERS & SURVEYORS
RIVERSIDE, CALIFORNIA

Charles E. Robertson
R.C.E. 16016
12-5-72
DATE

MARK	REVISIONS	APPR.	DATE
1	ADD WHEEL CHAIR RAMP (REV. FOR PM. 252) C.E.R. 1/10/76	[illegible]	3/23/76
2	Added paving section	[illegible]	4-16-77

DESIGNED BY C.H. DRAWN BY C.H. CHECKED BY [illegible]

CITY OF RIVERSIDE, CALIFORNIA
DEPARTMENT OF PUBLIC WORKS

APPROVED BY	BY	DATE
OFFICE ENGINEER	[illegible]	1/13
PARK DEPARTMENT	—	—
TRAFFIC DIVISION	[illegible]	2/12
ASSISTANT CITY ENG.	[illegible]	5-1

APPROVED BY [signature]
DIRECTOR OF PUBLIC WORKS
DATE 5-2-74

STREET PLAN & PROFILE
CANYON CREST DRIVE
FROM BLAINE ST. TO 667.5' NORTH OF BLAINE ST.
PARCEL MAP ~~No~~ 252 (1)
HORIZ. SCALE: 1" = 40' VERT. SCALE: 1" = 4'

INDEXED MD
PROJECT NO. R-1641
SHEET 1 OF 1
FILE NO. 72-2268