STREET LIGHTING CONSTRUCTION NOTES

1. Install all street light facilities as shown in accordance with the plans, standard plans, and the latest revision of the City of Riverside Public Utilities Department Street Light Specification № 113.
2. Contact Public Utilities Street Light Inspector, telephone no. 787-1423, for required inspections.
3. Excavation for electrolier foundations, pullboxes, and conduits must be done after installation of curbs and gutters, but before installation of sidewalks. Foundation locations shall be approved by the engineer prior to excavation.
4. $ 28.00 connection and inspection fees to be paid by contractor.
5. Install a waterproof "in line" fuse holder in both branch conductors in the base of each street light standard. Fuse holder to be "Bussman" # HEBB-BB for copper wire with a "Bussman" FNM 5 Amp 250 volt fuse or approved equal.
6. All service points to be connected by City of Riverside.

STREET LIGHT STRUCTURE SCHEDULE

GENERAL INFORMATION			STANDARD PLANS	
SYMBOL	DESCRIPTION	SIZE	Nº REQ'D.	PLAN Nº	ITEM Nº
	Metal Electrolier Standard	14 ft	7	UGS 800	CG
	Roof Top Luminaire	175 W.	7	"	LS
	Color Corrected Lamp	175 W.	7	"	LA 1
	Photo Control	240 V 1000 W.	7	"	PC 2
	Concrete Pullbox	10"×17"	4	"	P 1
	1" Rigid steel conduit with 2-#8 Cu. 600 V. cables unless otherwise noted	A B	SHOWN		

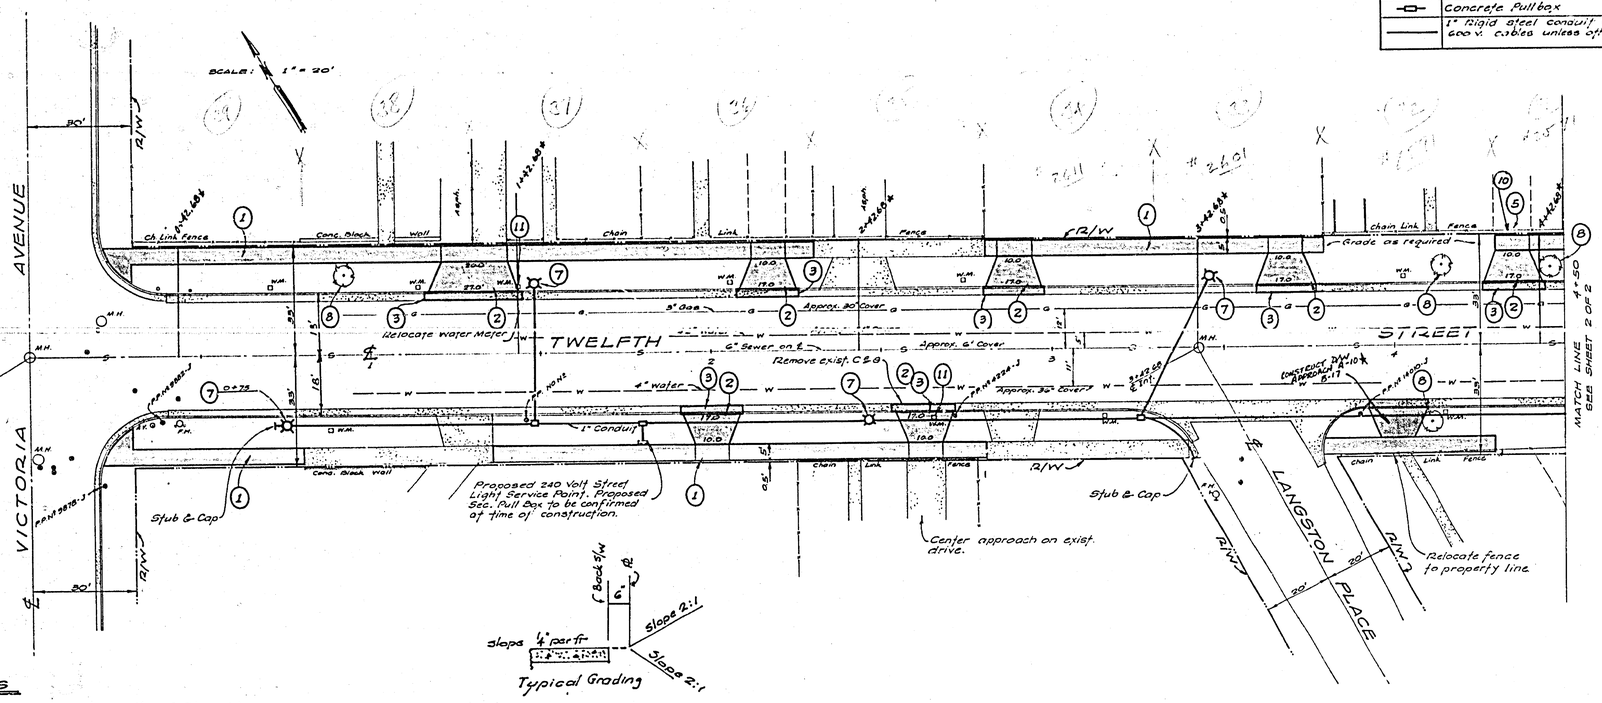

CONSTRUCTION NOTES

1. Construct 5 ft. property line sidewalk per City of Riverside Std. 350. Match existing sidewalk where applicable.
2. Construct Driveway Approach per C/R Std. 302. Dimensions "A" and "B" shown on plans.
3. Remove existing depression and curb & gutter and construct driveway and curb depression per C/R Std. 302.
4. Remove existing Conc. block wall and construct new block wall per C/R Std. 704. Match existing size, color, and texture.
5. Regrade dirt driveway to match driveway approach and sidewalk elevation. Maximum slope to be 10%.
6. Construct concrete steps per detail on Sheet 2 of 2.
7. Install post top luminaire with metal electrolier standard.
8. Remove trees and fill void.
9. Construction to be done in accordance with Standard Specifications for Public Works Construction, 1970 Edition, and City of Riverside Standard Drawings.
10. Lower existing gate to grade to suit owner.
11. Contractor shall make all necessary arrangements with City of Riverside for water meter relocation.

APPROVED FOR CONCEPT & SCOPE
D.R. Nicholson
Riv. Red. Ag.
1-22-73
DATE.

APPROVED FOR STREET LIGHTS
Utility Engineer
Date 1-7-73

ALBERT A. WEBB ASSOCIATES
CIVIL ENGINEERS
RIVERSIDE, CALIFORNIA
APPROVED BY Joseph Reich DATE 12-27-72
R.E. No. 21776
W.O. 72-451 FOR: C/R REDEVELOPMENT AGY. F.B.

MARK	REVISIONS	APPR.	DATE
★	"AS BUILT"	RAB	6-73

DESIGNED BY WB DRAWN BY JND CHECKED BY

CITY OF RIVERSIDE, CALIFORNIA
DEPARTMENT OF PUBLIC WORKS

APPROVED BY	BY	DATE
OFFICE ENGINEER		
PARK DEPARTMENT		
TRAFFIC DIVISION		
ASSISTANT CITY ENG.		
DIRECTOR		

APPROVED BY
DIRECTOR OF PUBLIC WORKS
DATE 1-24-73

IMPROVEMENTS
TWELFTH STREET
VICTORIA AVE. TO BERMUDA AVE.

HORIZ. SCALE: 1" = 20' VERT. SCALE: 1" =

INDEXED MB
PROJECT NO. R-1644
SHEET 1 OF 2
FILE NO. 72-451

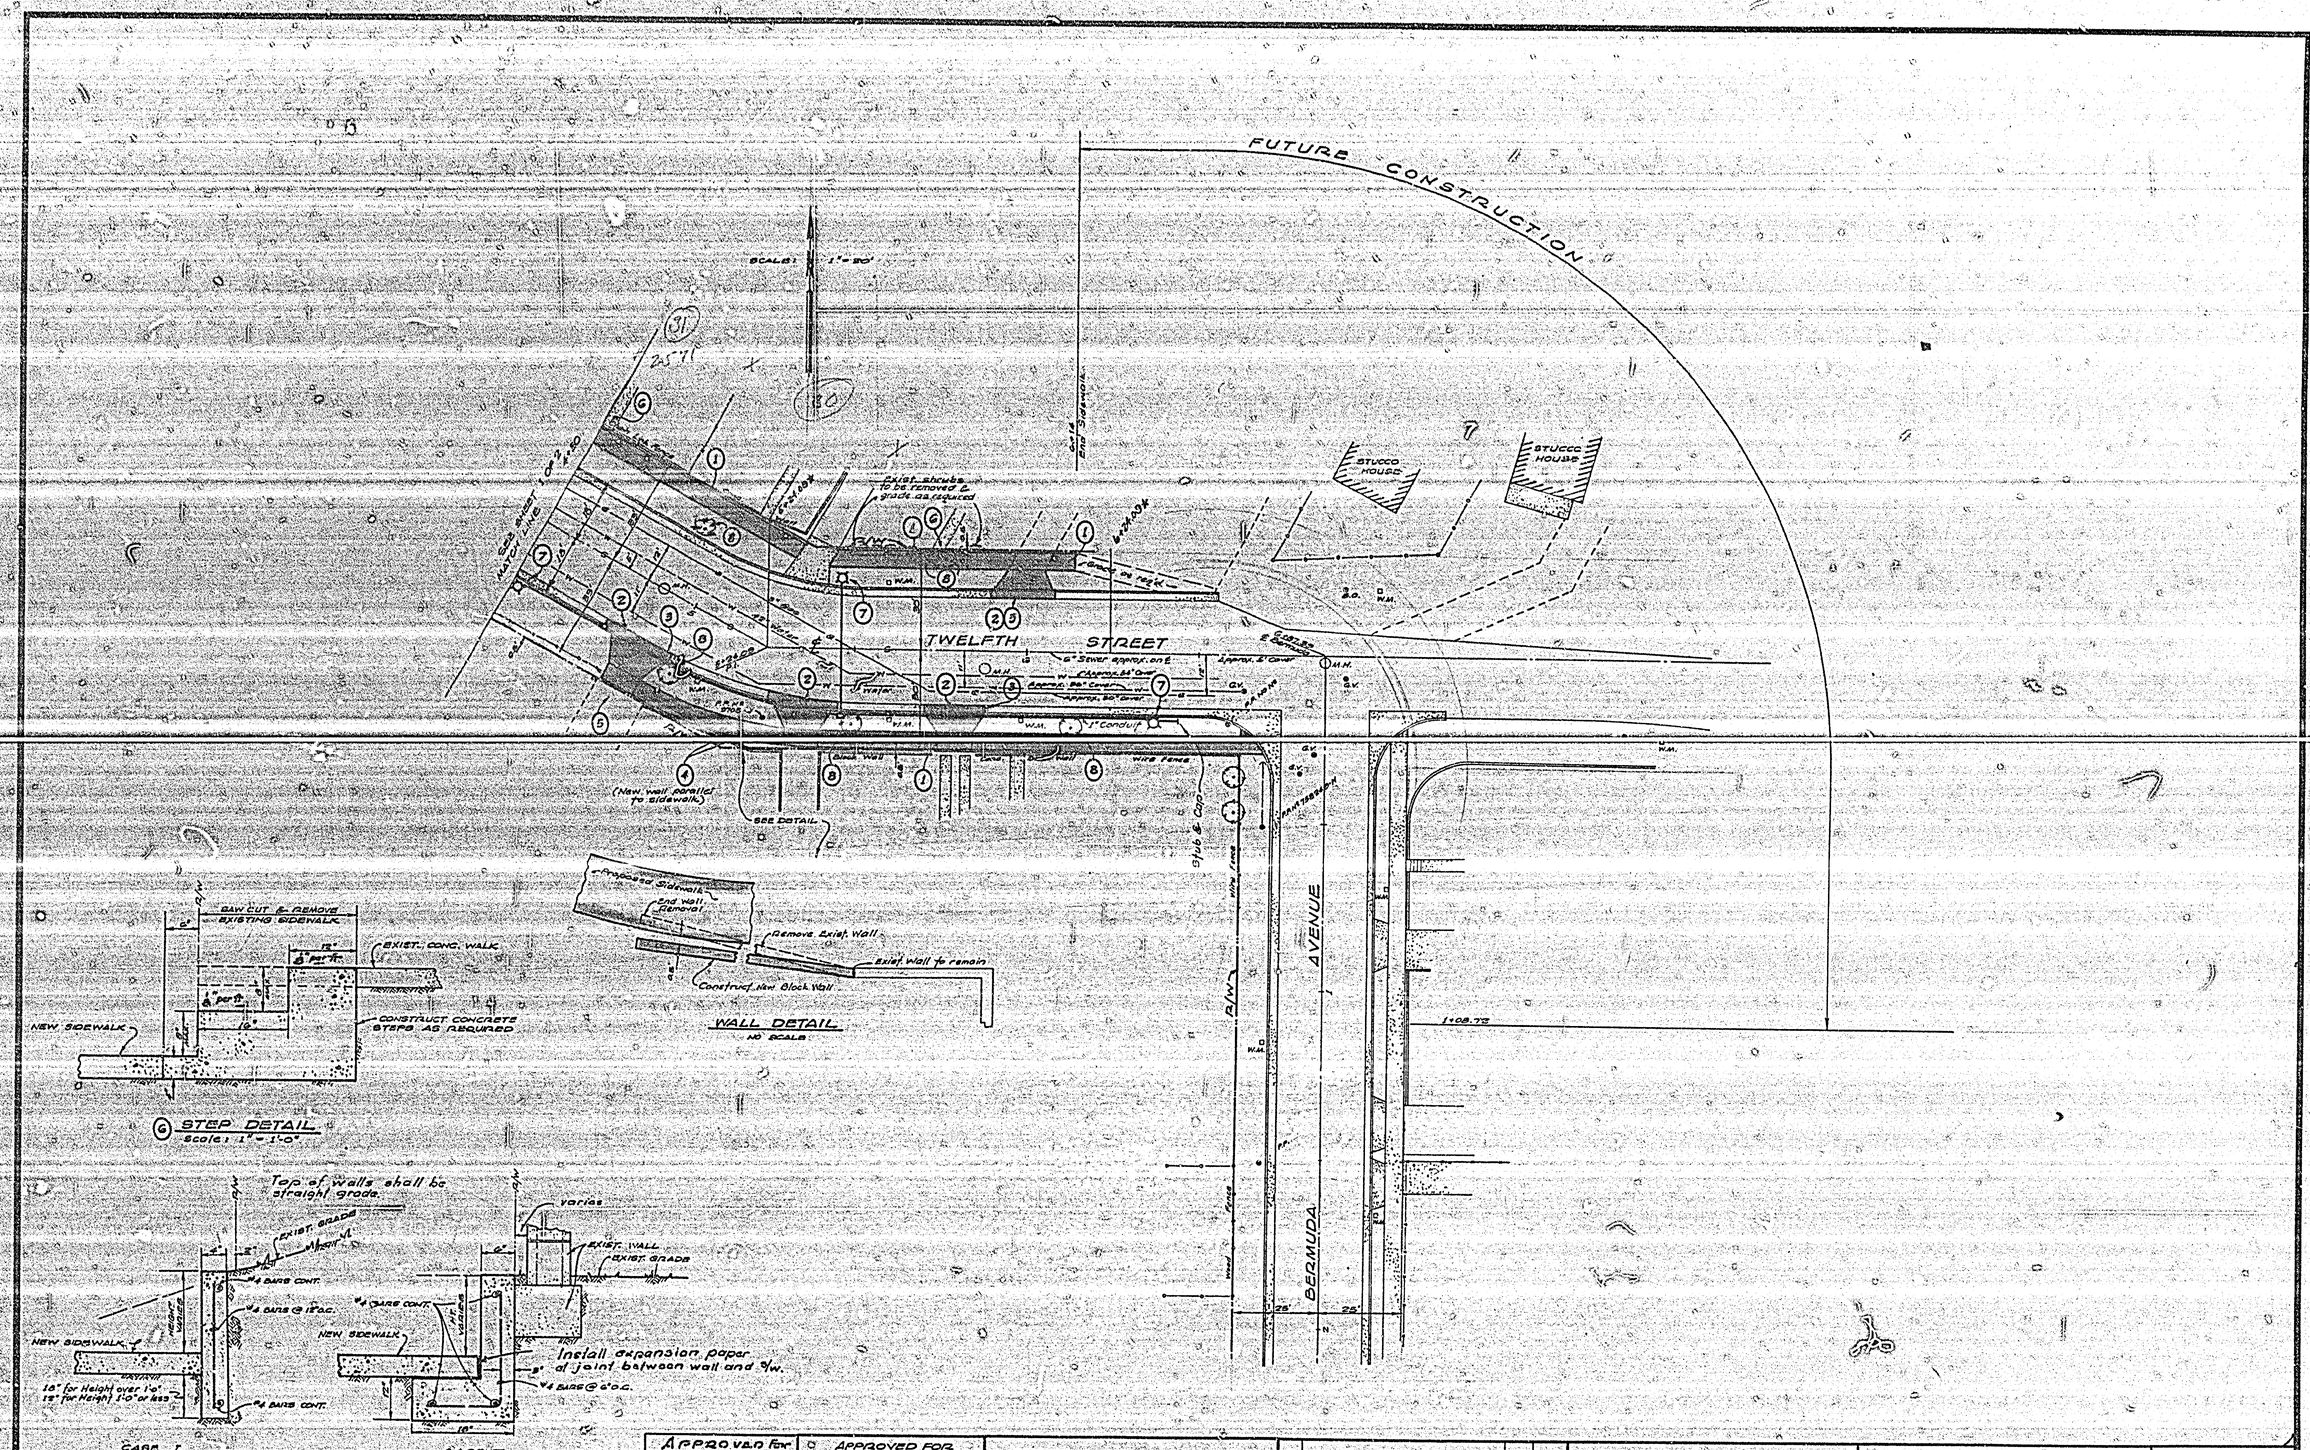

APPROVED FOR Concept & Scope D.R. Nichols Riv. Redev. Ag. 1-22-73 Date	APPROVED FOR STREET LIGHTS [signature] W. Utility Engineer Date 1-2-73	ALBERT A. WEBB ASSOCIATES CIVIL ENGINEERS RIVERSIDE, CALIFORNIA APPROVED BY [signature] DATE 12-27-72 R.E. No. 21775 W.O. 72-451 FOR C/R REDEVELOPMENT AG'Y. F.B.	MARK / REVISIONS / APPR. / DATE DESIGNED BY WB DRAWN BY JNB CHECKED BY	CITY OF RIVERSIDE, CALIFORNIA DEPARTMENT OF PUBLIC WORKS APPROVED BY / BY / DATE OFFICE ENGINEER / PKU / 1-3 PARK DEPARTMENT / XS / 1-3 TRAFFIC DIVISION / [illegible] / 1-2 ASSISTANT CITY ENG. / [illegible] / 1-23 APPROVED BY [signature] DIRECTOR OF PUBLIC WORKS DATE 1-24-73	IMPROVEMENTS TWELFTH STREET VICTORIA AVE. TO BERMUDA AVE. HORIZ. SCALE: 1" = 20' VERT. SCALE: 1" =	PROJECT NO. R-1644 SHEET 2 OF 2 FILE NO. 72-451