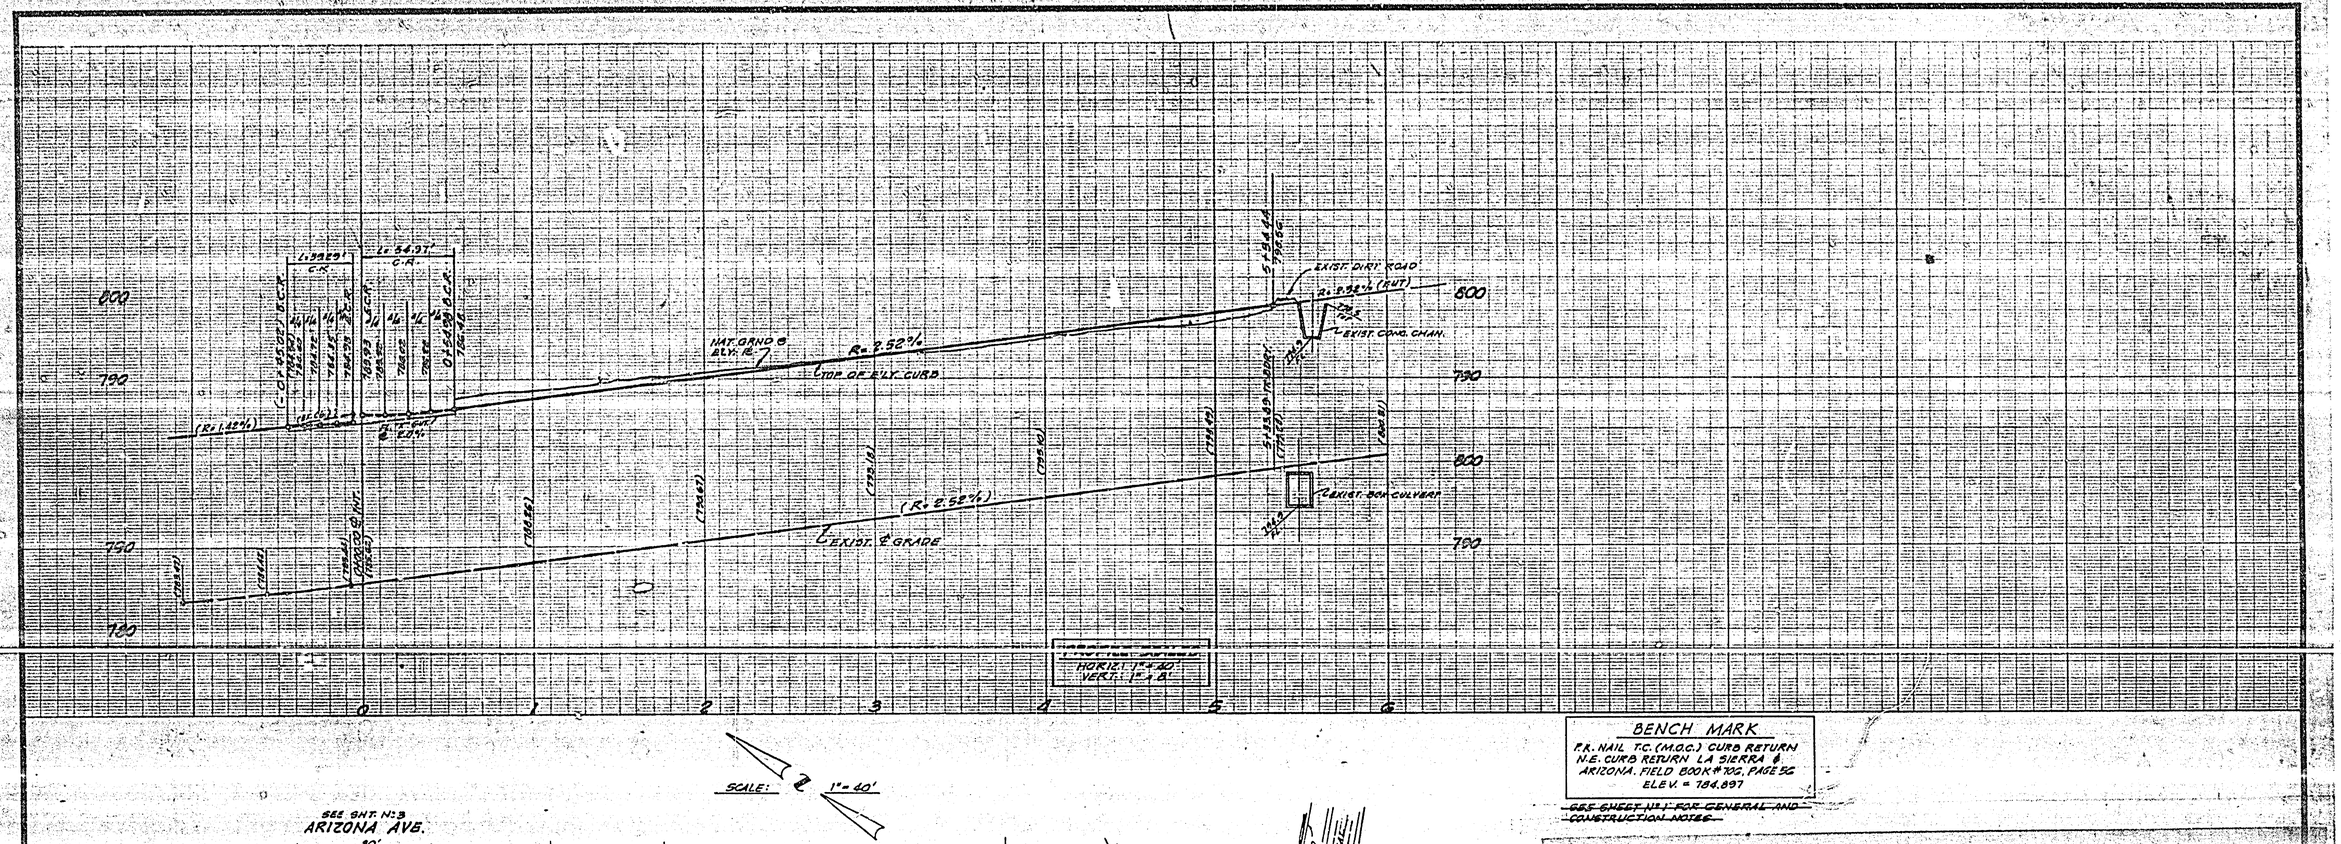

BENCH MARK

P.K. NAIL T.C. (M.O.C.) CURB RETURN N.E. CURB RETURN LA SIERRA & ARICONA. FIELD BOOK # 700, PAGE 56
ELEV. = 784.897

~~SEE SHEET N° 1 FOR GENERAL AND CONSTRUCTION NOTES~~

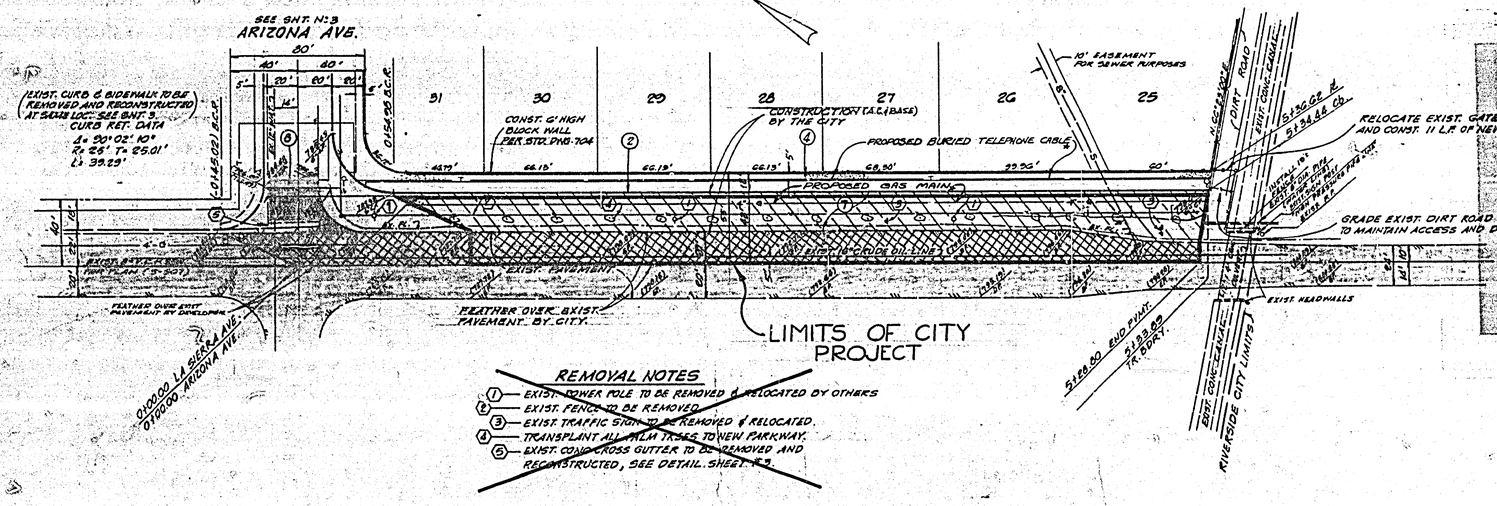

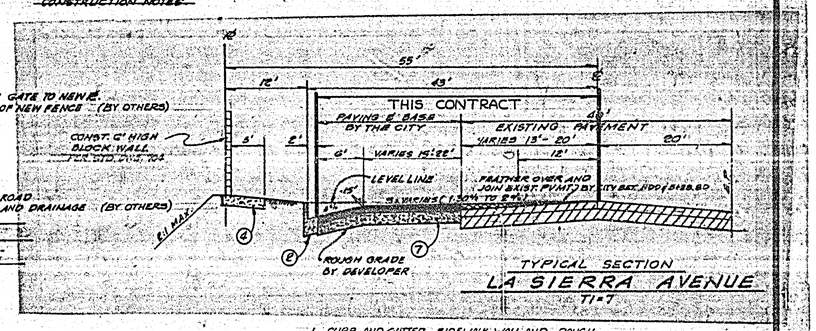

TYPICAL SECTION
LA SIERRA AVENUE
TI=7

1. CURB AND GUTTER, SIDEWALK, WALL AND ROUGH GRADING BY OTHERS.
2. CITY'S CONTRACTOR TO INSTALL PAVING IN WIDENED PORTION. USE 4" A.C. OVER 4" D.G. BASE OR, OPTIONAL, 6" A.C. OVER COMPACTED NATIVE MATERIAL.
3. CONSTRUCT A.C. OVERLAY AS SHOWN.

REMOVAL NOTES

1. EXIST. POWER POLE TO BE REMOVED & RELOCATED BY OTHERS
2. EXIST. FENCE TO BE REMOVED
3. EXIST. TRAFFIC SIGN TO BE REMOVED & RELOCATED.
4. TRANSPLANT ALL PALM TREES TO NEW PARKWAY.
5. EXIST. COND. CROSS GUTTER TO BE REMOVED AND RECONSTRUCTED, SEE DETAIL. SHEET N° 3

LA SIERRA AVENUE

-CAUTION-
PACIFIC TELEPHONE
CABLES UNDERGROUND
BEFORE EXCAVATING
CALL COLLECT:

	7:30 A.M. to 5 P.M.	After Hours & Holidays
Orange County	714-633-0811	714-547-4606
Riverside County	714-684-0071	714-547-4606
Inyo County	714-684-0071	714-547-4606
San Bernardino County	714-684-0071	714-547-4606
Los Angeles County	213-621-3111	24 HOUR SERVICE
Ventura County	213-621-3111	
San Diego County	714-298-0395	714-232-0037

FOR FREE CABLE LOCATING SERVICE

"AS BUILT" RAB 9-73

APPROVED BY: Jack Mahoney RCE 14525 — 1-7-73 DATE

APPROVED: Lawrence R. Drewen, RIVERSIDE WATER CO. — 1-31-73 DATE

MARK	REVISIONS	BY	DATE
★	REVISED PROFILE AND ADDED CURB RETURN	RAB	4/73

DESIGNED BY: VTC DRAWN BY: RAB CHECKED BY:

CITY OF RIVERSIDE, CALIFORNIA
DEPARTMENT OF PUBLIC WORKS

APPROVED BY	BY	DATE
OFFICE ENGINEER		
PARK DEPARTMENT		
TRAFFIC DIVISION		
ASSISTANT CITY ENG.		

APPROVED BY: William D. Harding, DIRECTOR OF PUBLIC WORKS — DATE 4/2/73

STREET PLAN AND PROFILE
TRACT 4935 CITY PARTICIPATION
LA SIERRA AVE. BETWEEN ARIZONA AVE. AND RIV. WAT. CO. CANAL

PROJECT NO. R-1645-A
SHEET 1 OF 1
HORIZ. SCALE: 1" = 40' VERT. SCALE: 1" = 4'
FILE NO.

ADAPTED FROM PLAN R-1640