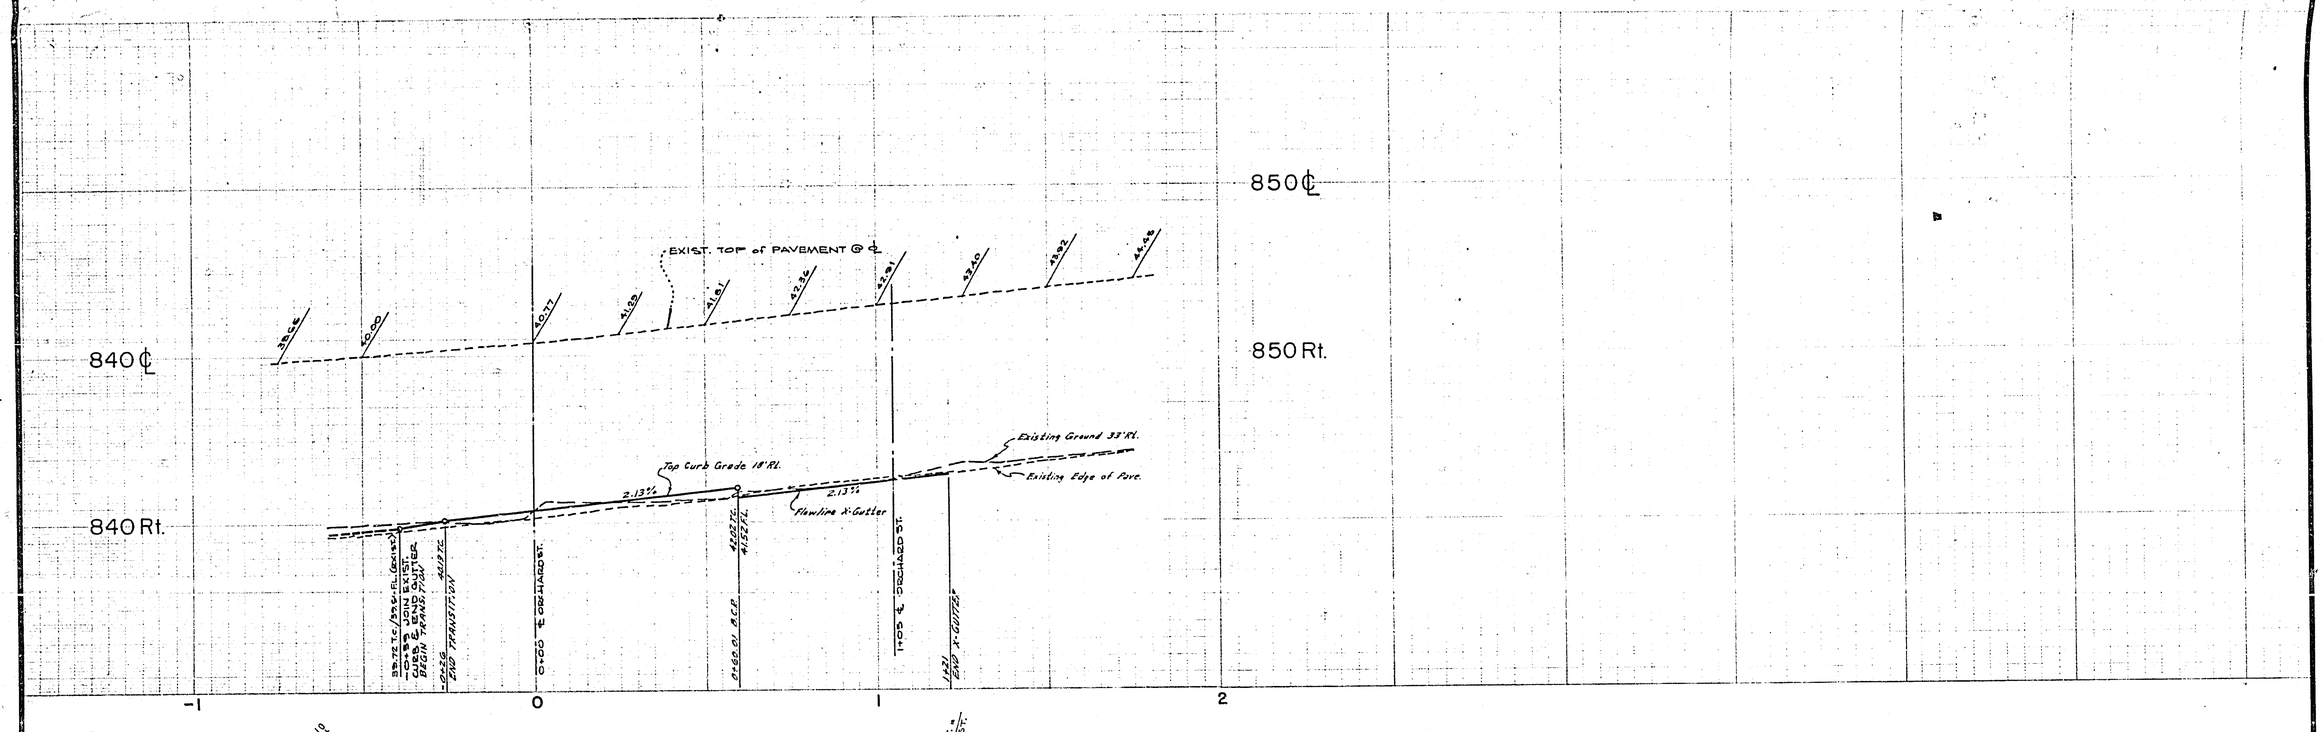

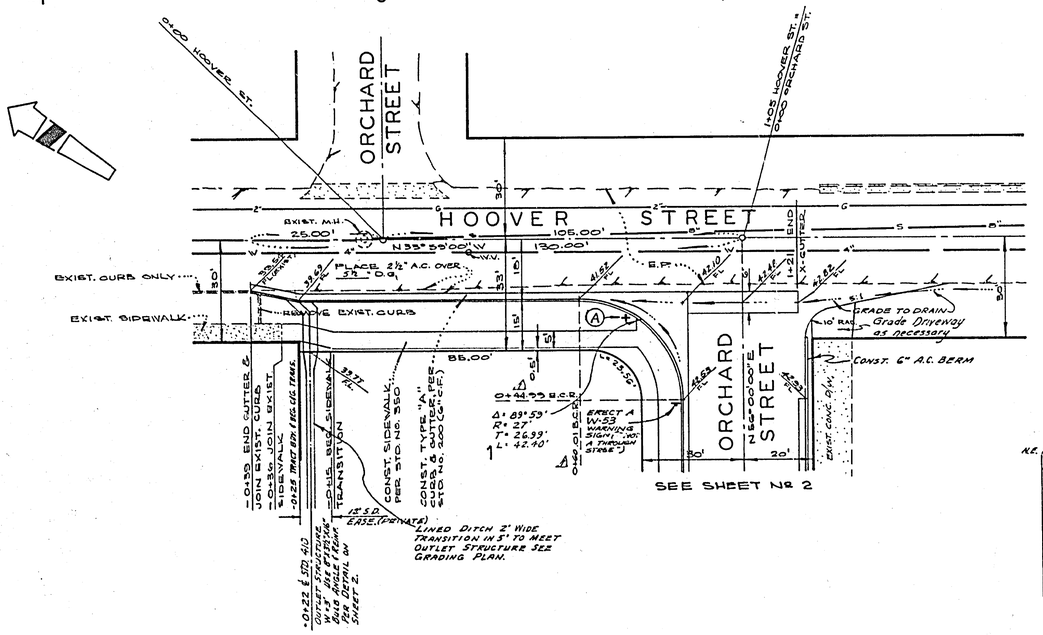

STREET NAME SIGN SCHEDULE

(A)	HOOVER STREET	3600
	ORCHARD STREET	7300

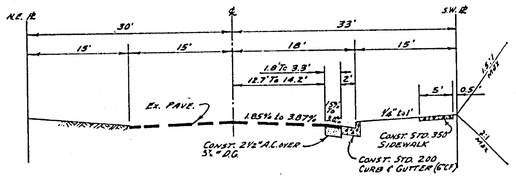

TYPICAL SECTION
HOOVER STREET

NO SCALE
T.I. = 6

GENERAL NOTES

1. Construction shall be in accordance with the Standard Specifications for Public Works Construction 1970 Edition & per City of Riverside Standard Drawings.
2. All flagged elevations shall be staked in the field by the Engineer.
3. The Subdivider shall arrange for a soil test to be made by soils Engineer after the street has been prepared to rough grade. Depth of base material and A.C. paving shall be determined by the City of Riverside Design Standard and Test procedures.
4. Driveways to be located in the field and constructed per City of Riverside Std. No. 302.
5. All Curb Returns shall be constructed per City of Riverside Std. No. 304.

BENCH MARK

S/L in Curb @ N.W. Corner Mariella & Orchard
C/R F.B. 438/60 Elev. = 842.17

G.R. #802
R-36

ALBERT A. WEBB ASSOCIATES
CIVIL ENGINEERS
RIVERSIDE, CALIFORNIA
APPROVED BY [signature] DATE 11/16/72
R.E. No. 9876
W.O. 72-368 FOR: Tavaglione Const. Consultants F.B. 560

MARK	REVISIONS	APPR.	DATE
A	CORRECTED CURB RETURN STATIONS		

DESIGNED BY REC DRAWN BY W.J.K. CHECKED BY L.

CITY OF RIVERSIDE, CALIFORNIA
PUBLIC WORKS DEPARTMENT

APPROVED BY	BY	DATE
PRINCIPAL ENGINEER		
PARK DEPARTMENT		
TRAFFIC DIVISION		
CHIEF PUB. WKS. ENGR.		

APPROVED BY William D. Gardner
DIRECTOR OF PUBLIC WORKS
DATE 4/13/73

TRACT NO. 4889
STREET PLAN AND PROFILE
HOOVER STREET

SCALE: HORIZ: 1"=20' ; VERT.: 1"=4'

ACCOUNT No. 72-368
DRAWING NUMBER
R-1654
SHEET 1 OF 2
72-368-A

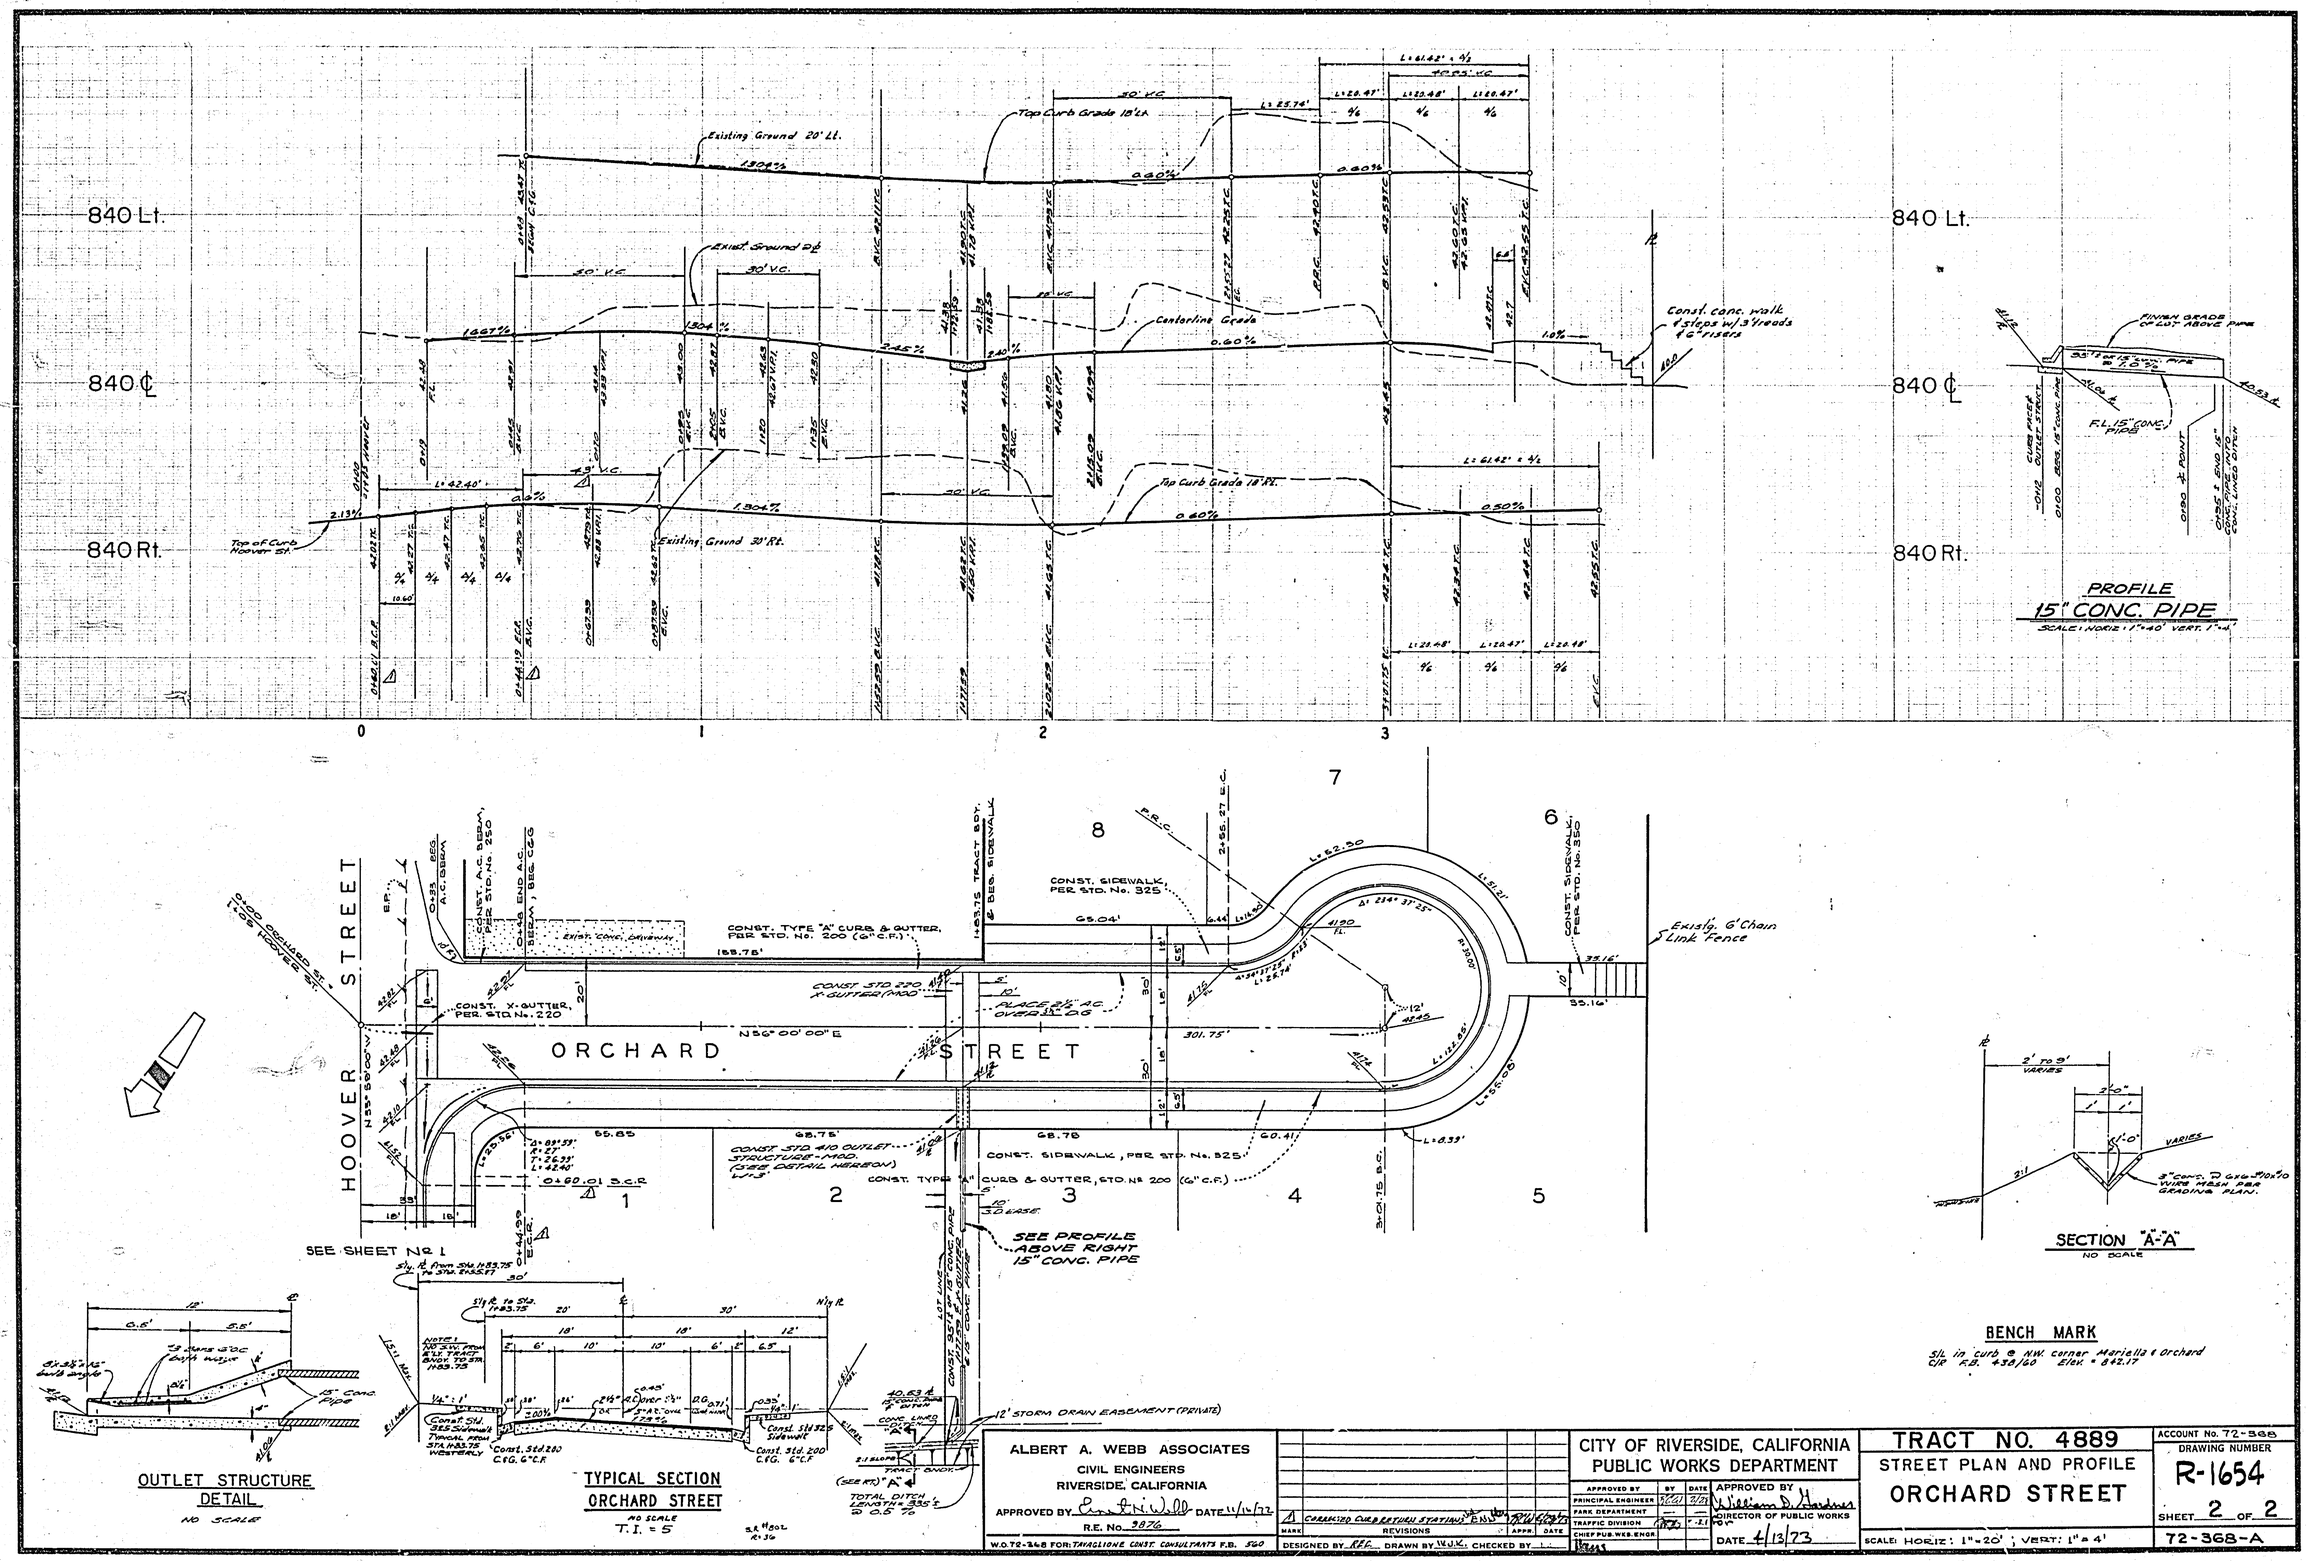

ALBERT A. WEBB ASSOCIATES
CIVIL ENGINEERS
RIVERSIDE, CALIFORNIA
APPROVED BY Ernest N. Webb DATE 11/16/72
R.E. No. 9876
W.O. 72-368 FOR: TAVAGLIONE CONST. CONSULTANTS F.B. 560

MARK	REVISIONS	APPR.	DATE
1	CORRECTED CURB RETURN STATIONS		

DESIGNED BY REC DRAWN BY W.J.K. CHECKED BY

CITY OF RIVERSIDE, CALIFORNIA
PUBLIC WORKS DEPARTMENT

APPROVED BY	BY	DATE
PRINCIPAL ENGINEER		
PARK DEPARTMENT		
TRAFFIC DIVISION		
CHIEF PUB. WKS. ENGR.		

APPROVED BY William D. Gardner
DIRECTOR OF PUBLIC WORKS
DATE 4/13/73

TRACT NO. 4889
STREET PLAN AND PROFILE
ORCHARD STREET

SCALE: HORIZ: 1"=20'; VERT: 1"=4'

ACCOUNT No. 72-368
DRAWING NUMBER R-1654
SHEET 2 OF 2
72-368-A