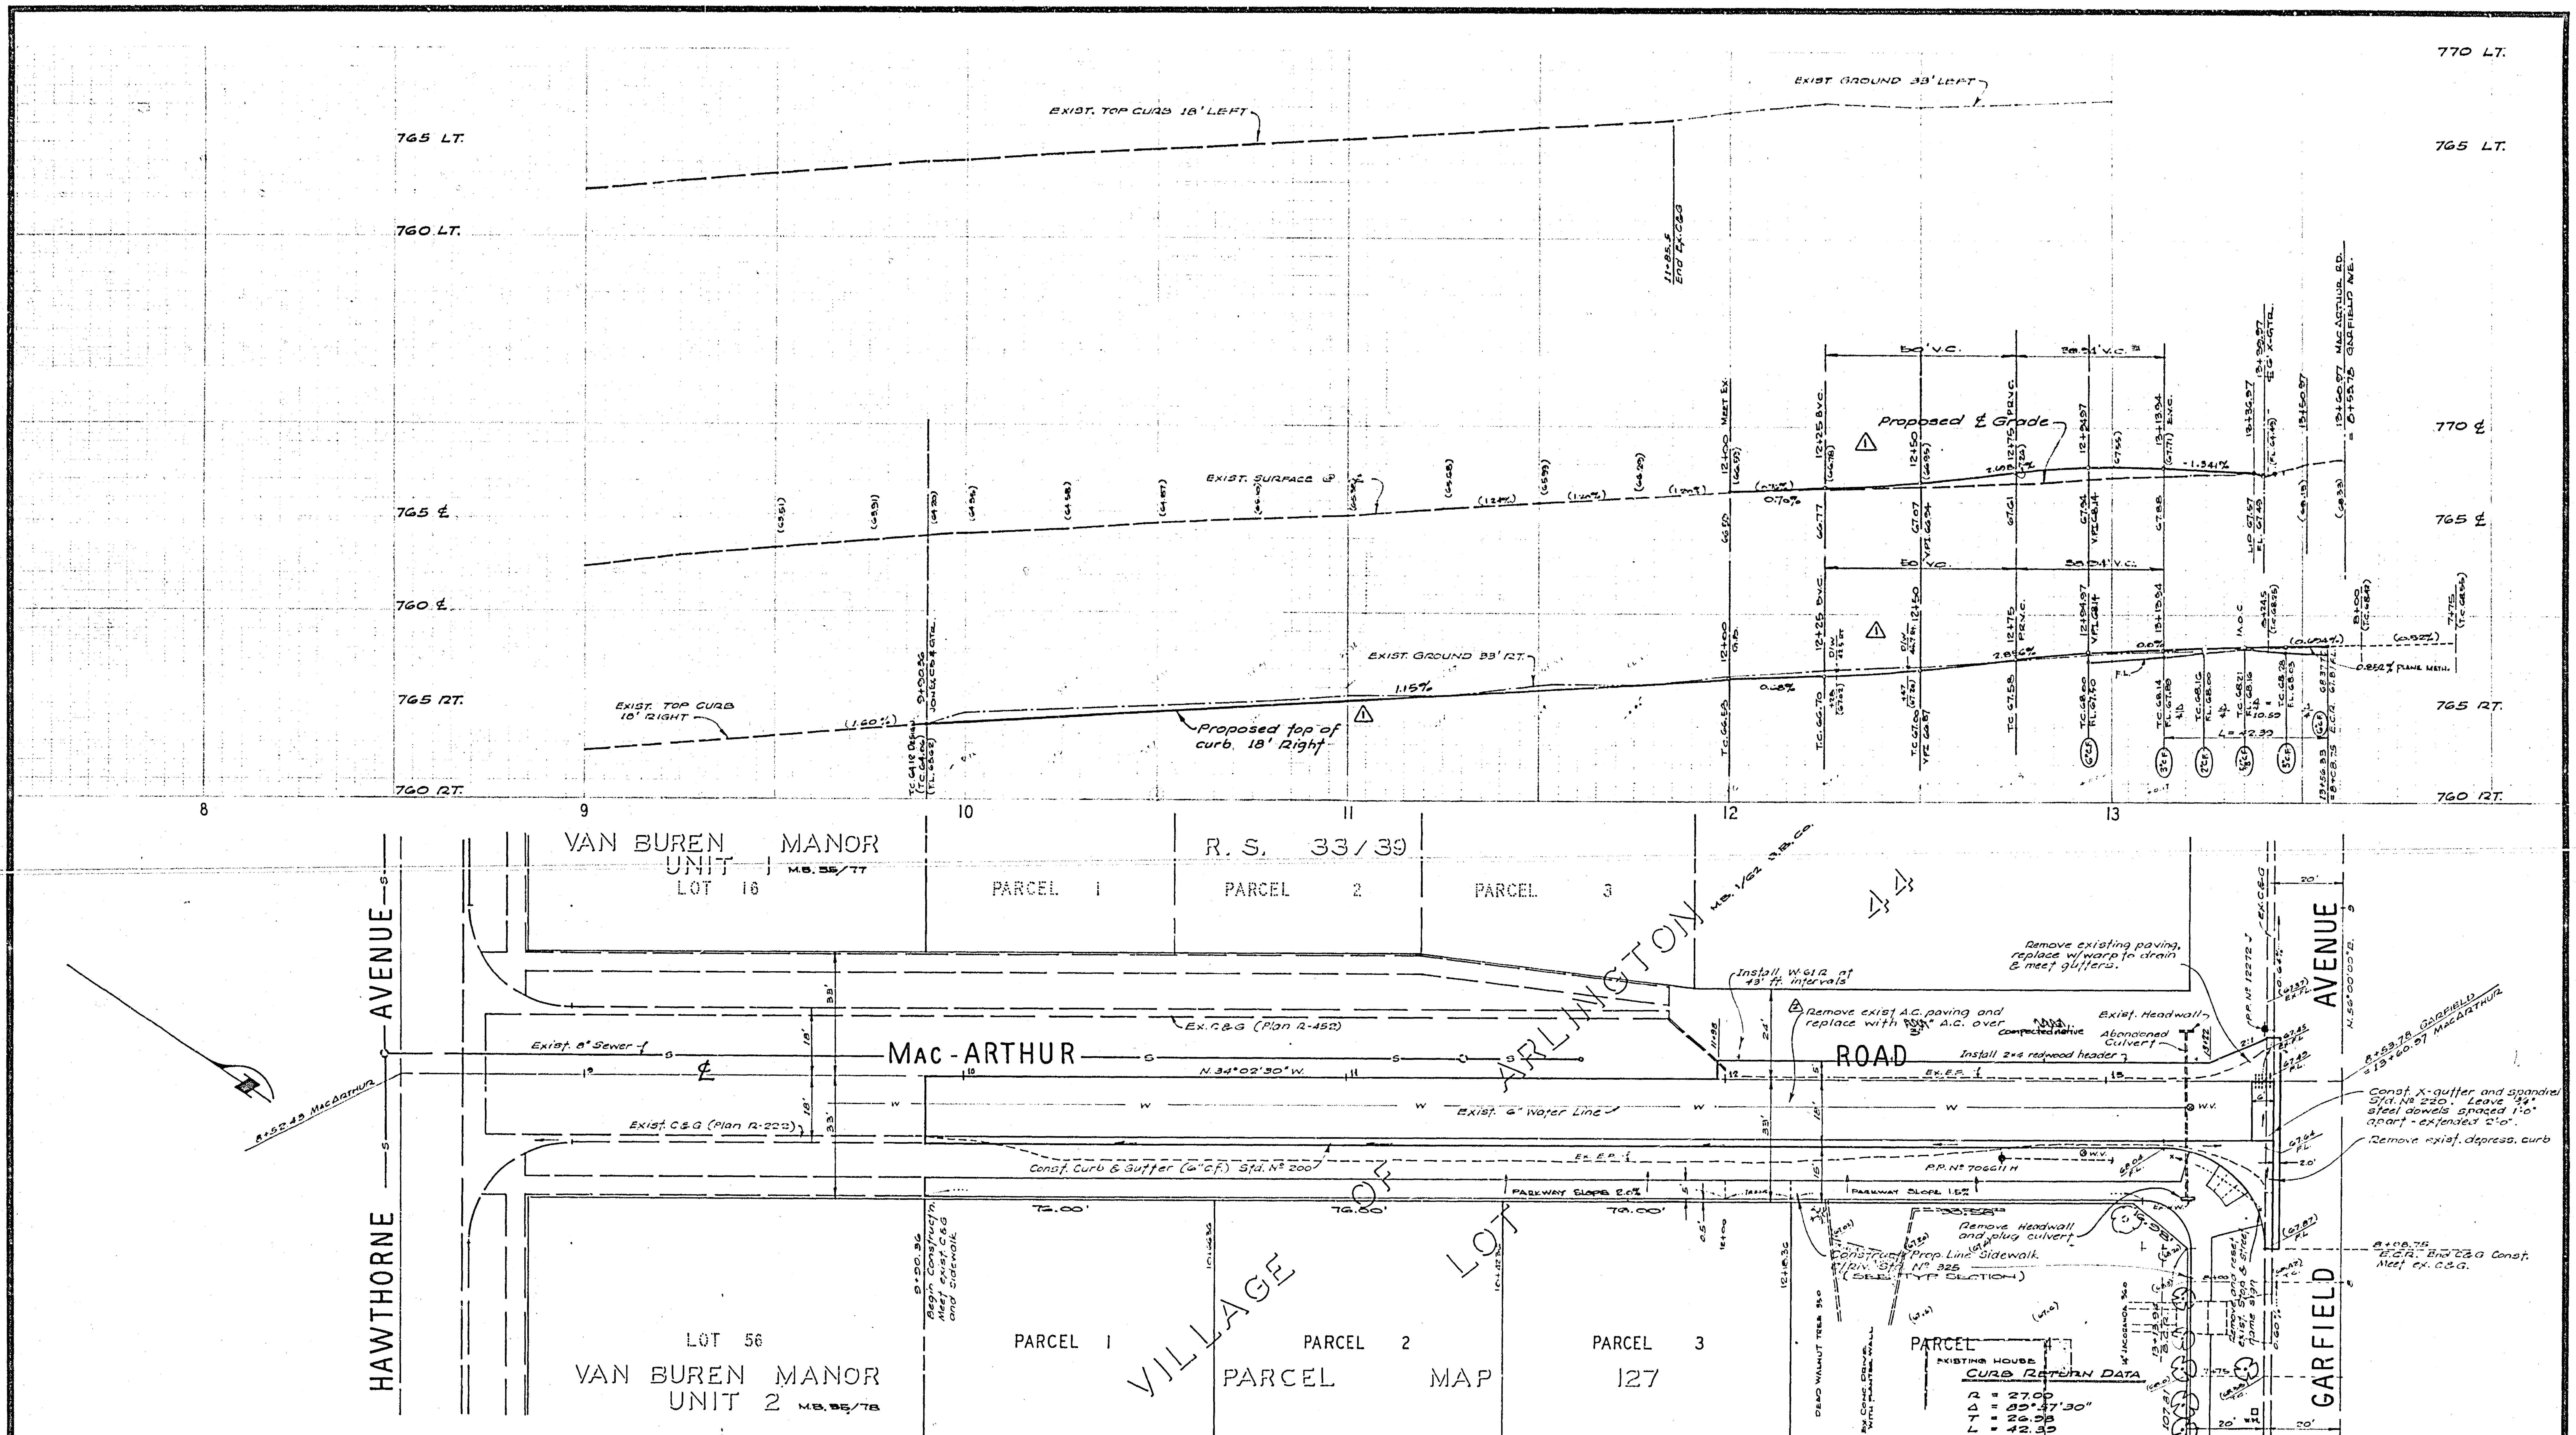

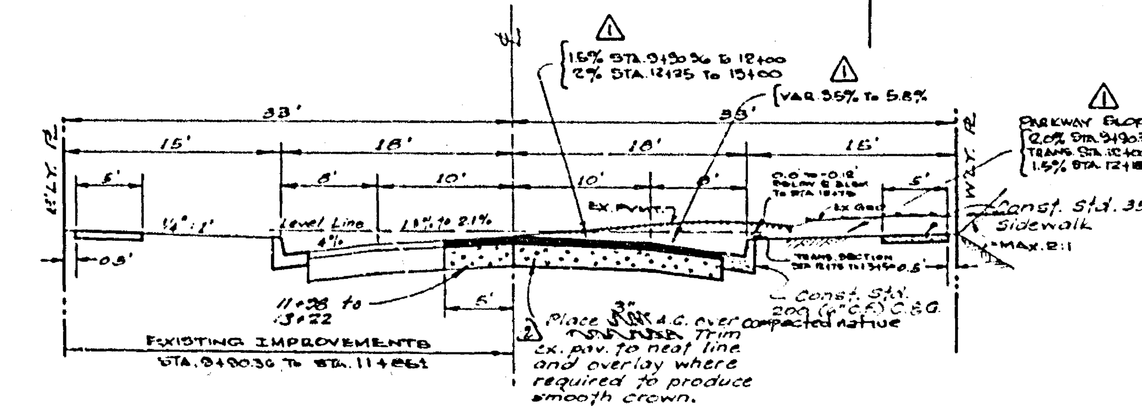

TYPICAL SECTION - MACARTHUR RD.
9+90.36 TO 13+13.94
T.I. = 5

GENERAL NOTES

1. Construction shall be in accordance with the Standard Specifications for Public Works Construction, 1973 Edition, and per City of Riverside Standard Drawings.
2. The developer shall arrange for a soil test by a Soil Engineer after the street has been prepared to rough grade. Depth of base mat'l. and A.C. paving shall be determined by City of Riverside design standards and test procedures.
3. Location of driveway approaches, Std. Nº 302, to be determined at time of construction, or as indicated.
4. Construct curb return per Std. Dwg 304
5. Exist. Elev. indicated thus (67.24)

ALBERT A. WEBB ASSOCIATES
CIVIL ENGINEERS
RIVERSIDE, CALIFORNIA
APPROVED BY [signature] DATE 2/16/73
R.E. No. 9876
W.O. 72-426 FOR: Home & Country Dev. Co. F.B. 1029

MARK	REVISIONS	APPR.	DATE
2	Added paving section		8-30-76
1	MAJOR REDESIGN TO BETTER MEET EXIST. CONDITIONS		10.8.74

DESIGNED BY JNB DRAWN BY JNB CHECKED BY L.L.

CITY OF RIVERSIDE, CALIFORNIA
PUBLIC WORKS DEPARTMENT

APPROVED BY	BY	DATE
PRINCIPAL ENGINEER		3/13
PARK DEPARTMENT	—	—
TRAFFIC DIVISION		5-1
CHIEF PUB. WKS. ENGR.		

APPROVED BY [signature]
DIRECTOR OF PUBLIC WORKS
DATE 7/13/73

STREET PLAN AND PROFILE
MacARTHUR ROAD
PARCEL MAP 127
SCALE: 1" = 20' HOR. 1" = 4' VERT.

ACCOUNT No.
DRAWING NUMBER
R-1664
SHEET 1 OF 1
75-202 A