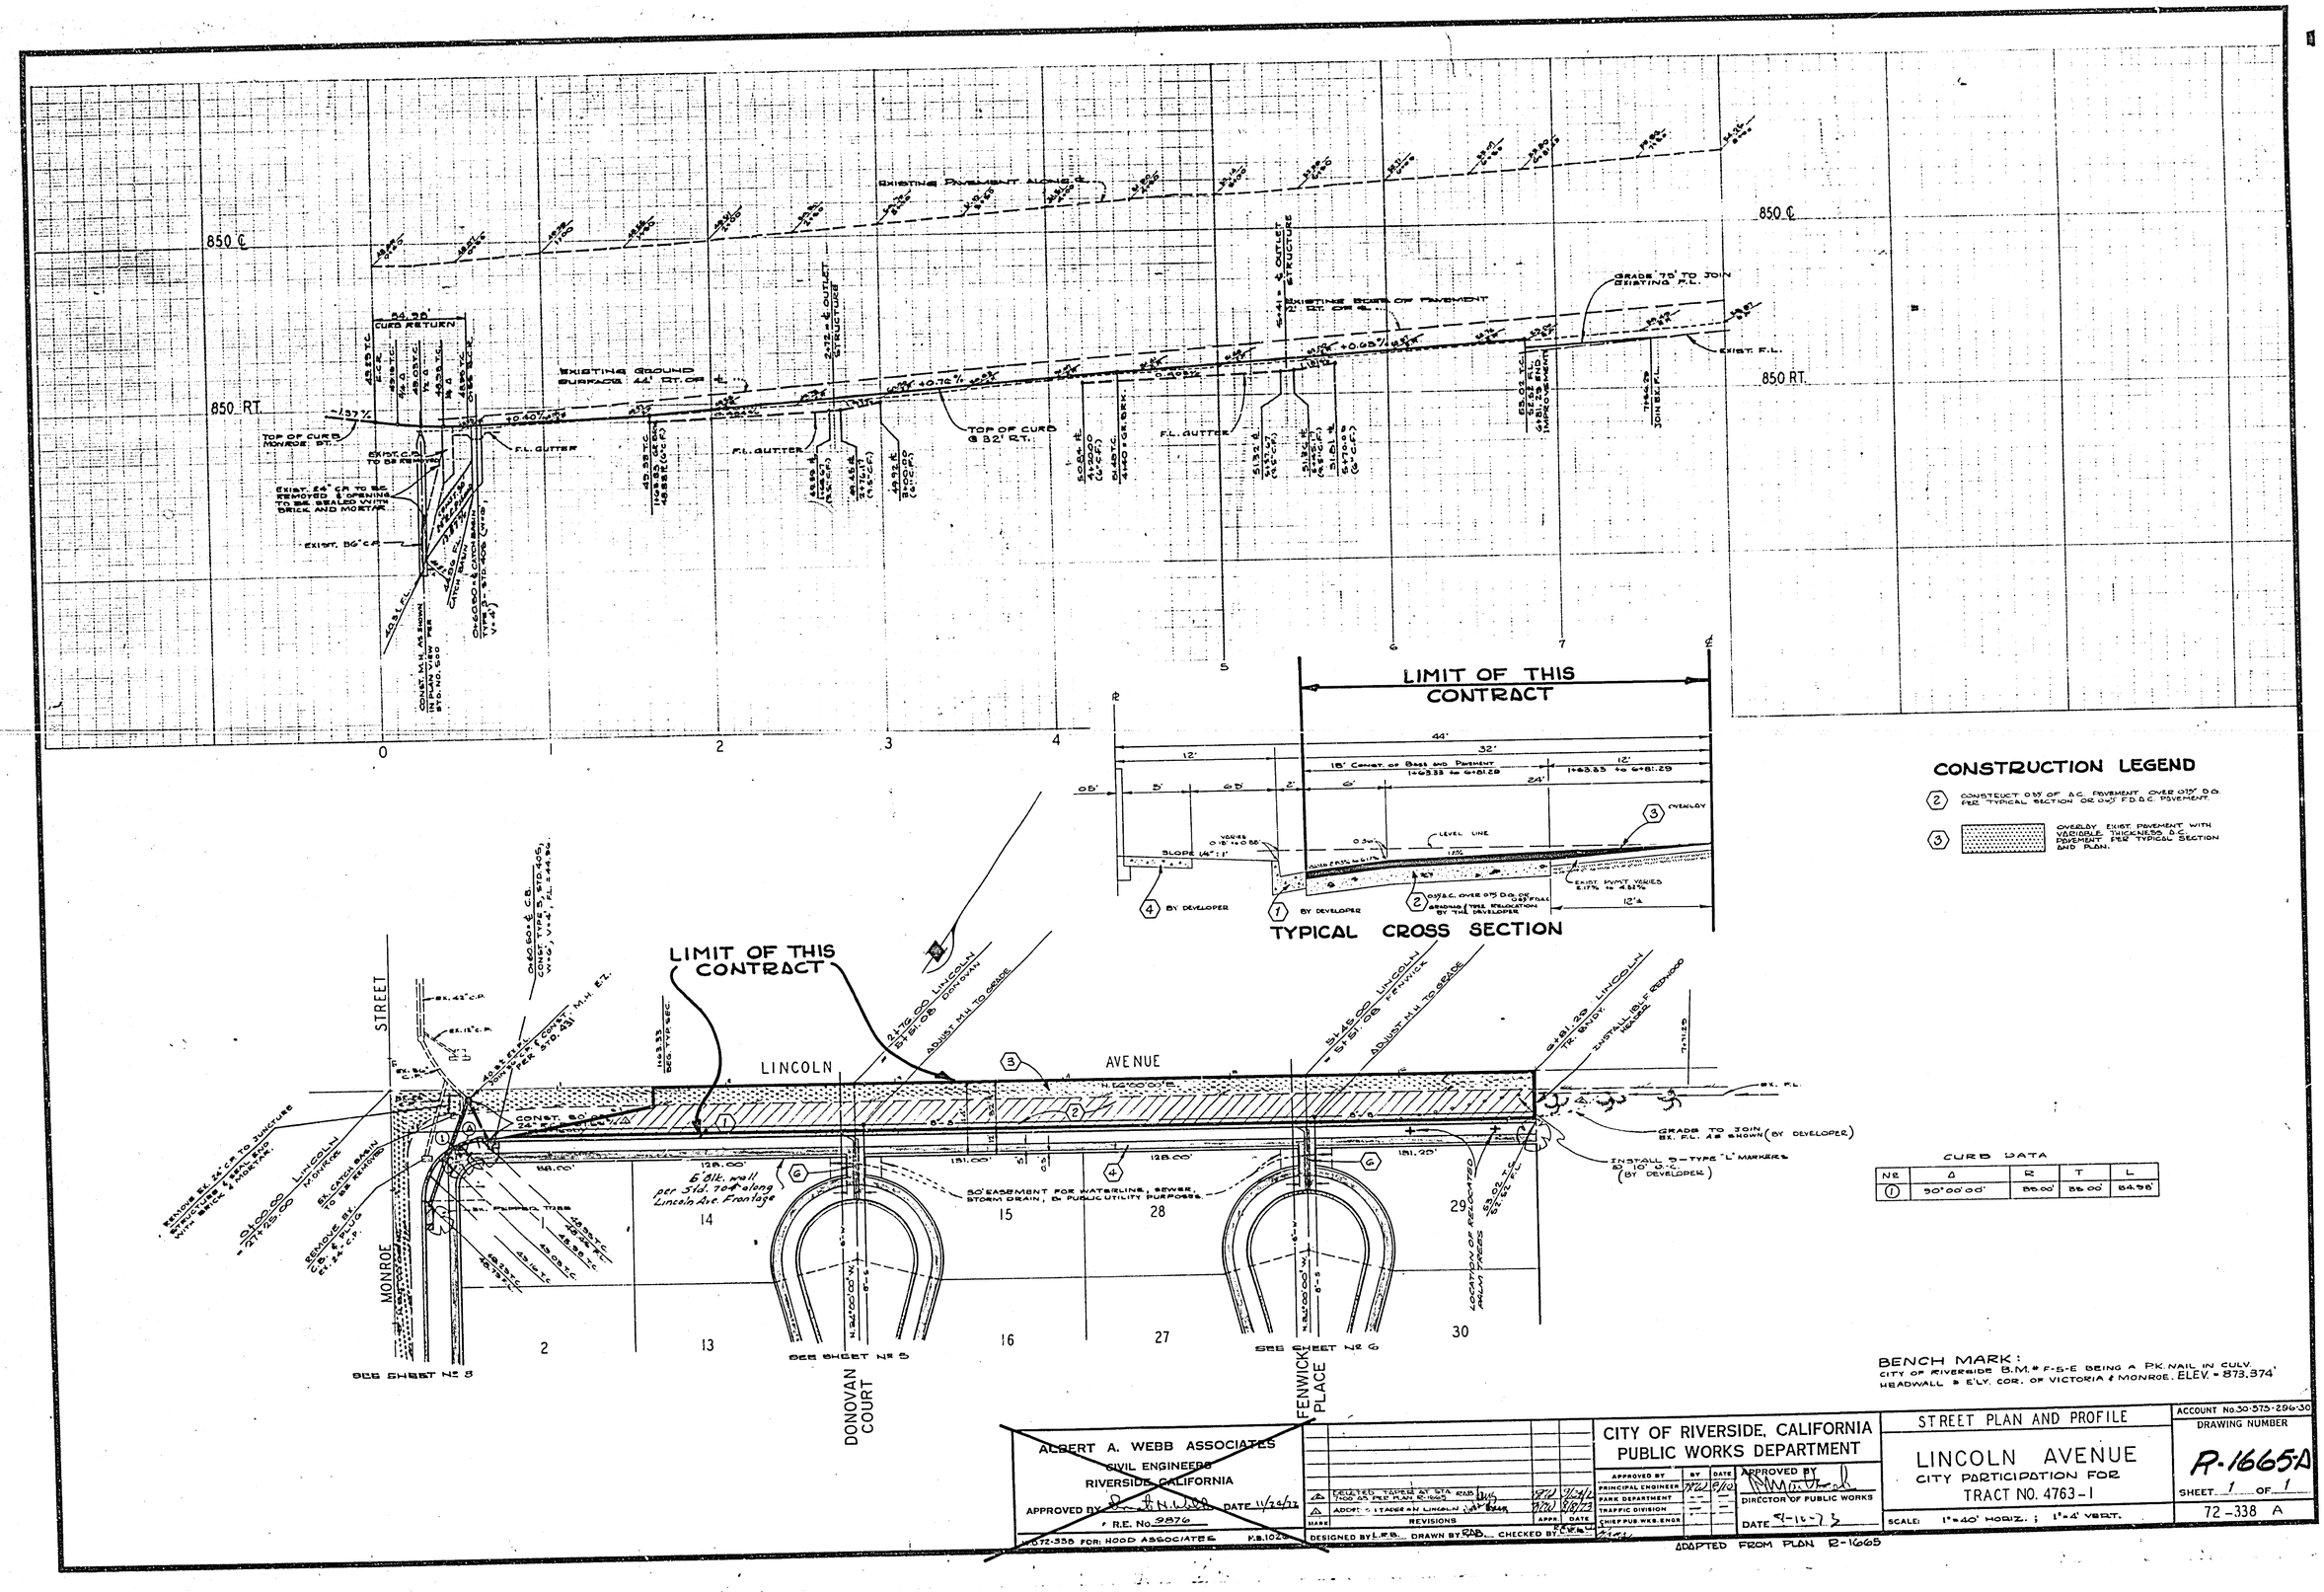

CONSTRUCTION LEGEND

(2) CONSTRUCT 0.5' OF A.C. PAVEMENT OVER 0.75' D.G. PER TYPICAL SECTION OR 0.5' F.D.A.C. PAVEMENT.

(3) OVERLAY EXIST. PAVEMENT WITH VARIABLE THICKNESS A.C. PAVEMENT PER TYPICAL SECTION AND PLAN.

CURB DATA

No	Δ	R	T	L
1	90°00'00"	85.00'	85.00'	84.95'

BENCH MARK:
CITY OF RIVERSIDE B.M. # F-5-E BEING A PK. NAIL IN CULV. HEADWALL @ E'LY. COR. OF VICTORIA & MONROE. ELEV. = 873.374'

ALBERT A. WEBB ASSOCIATES
CIVIL ENGINEERS
RIVERSIDE, CALIFORNIA
APPROVED BY [signature] DATE 11/24/72
R.E. No. 9876
W.O. 72-338 FOR: HOOD ASSOCIATES F.B. 1026

MARK	REVISIONS	APPR.	DATE
△	DELETED TAPER AT STA. RAB 7+00.00 PER PLAN R-1665	[signature]	9/24/72
△	ADDED STAGE ON LINCOLN	[signature]	8/8/72

DESIGNED BY L.F.B. DRAWN BY RAB CHECKED BY [signature]

CITY OF RIVERSIDE, CALIFORNIA
PUBLIC WORKS DEPARTMENT

APPROVED BY	BY	DATE
PRINCIPAL ENGINEER	[signature]	9/10
PARK DEPARTMENT	—	—
TRAFFIC DIVISION	—	—
CHIEF PUB. WKS. ENGR.	—	—

APPROVED BY [signature]
DIRECTOR OF PUBLIC WORKS
DATE 9-10-73

ADAPTED FROM PLAN R-1665

STREET PLAN AND PROFILE

LINCOLN AVENUE
CITY PARTICIPATION FOR
TRACT NO. 4763-1

SCALE: 1"=40' HORIZ.; 1"=4' VERT.

ACCOUNT No. 30-575-296-30
DRAWING NUMBER
R-1665-A
SHEET 1 OF 1
72-338 A