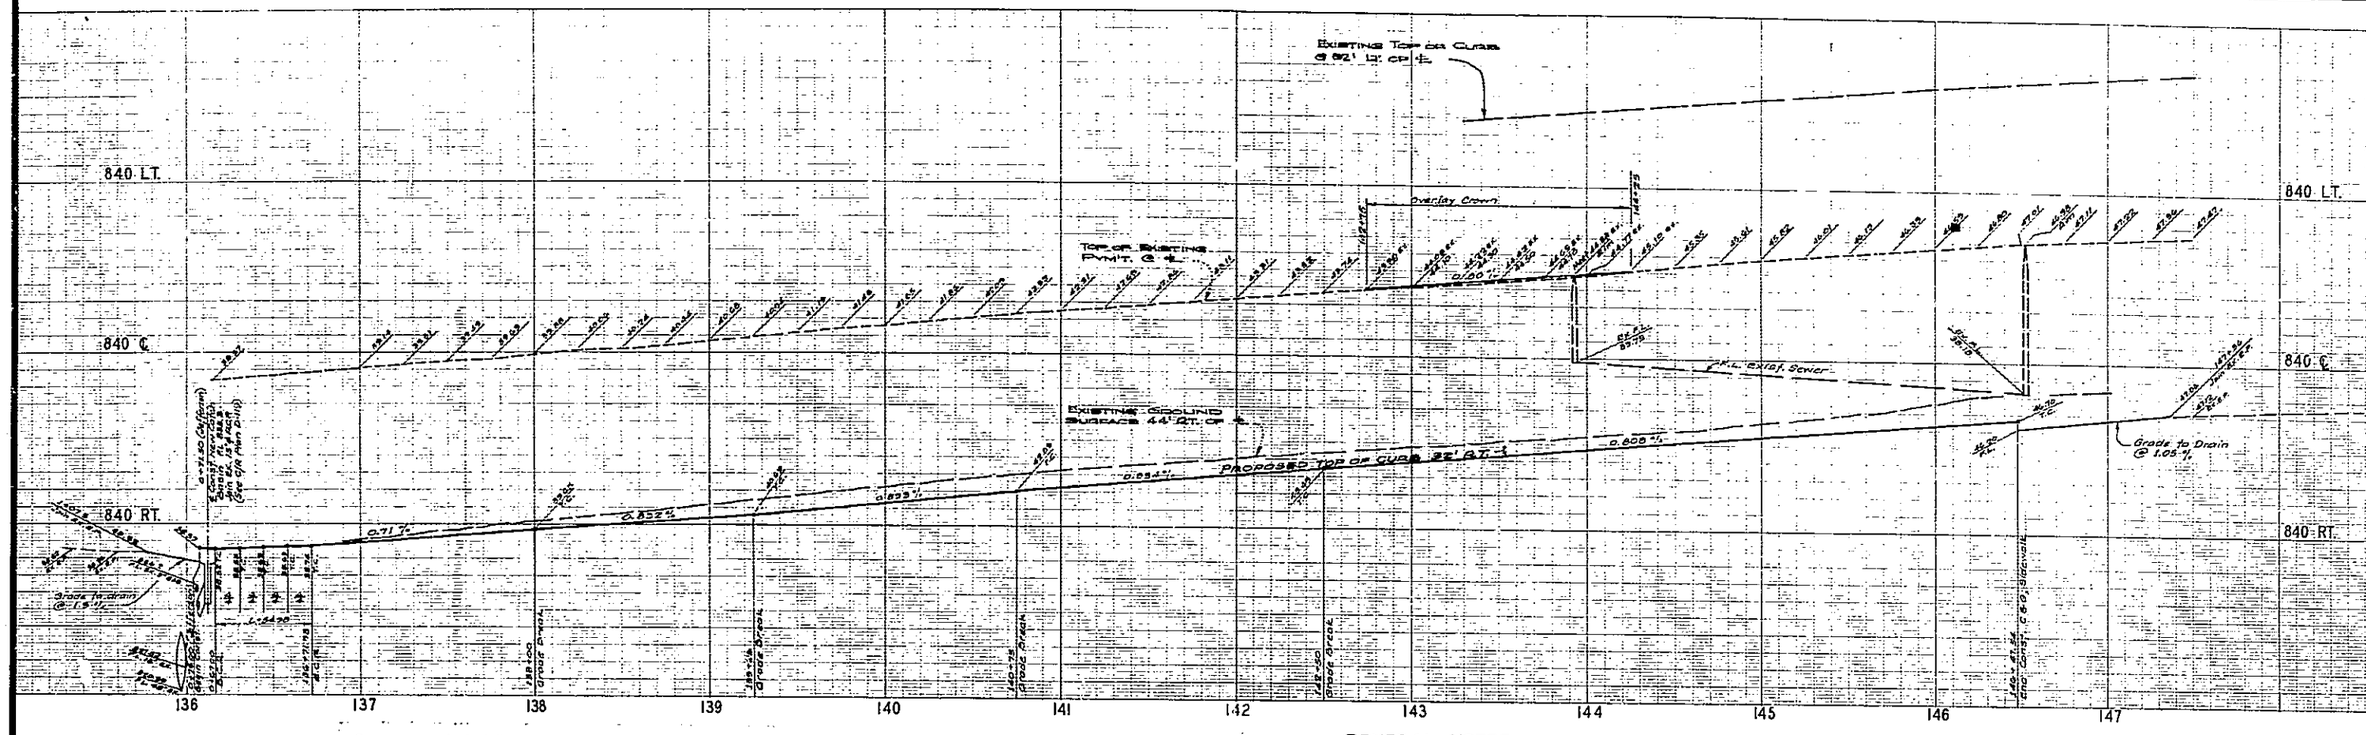

Contractor agrees that he shall assume sole and complete responsibility for job site conditions during the course of construction of this Project, including safety of all persons and property; that this requirement shall apply continuously and not be limited to normal working hours; and that the Contractor shall defend, indemnify and hold the Owner and the Engineer harmless from any and all liability, real or alleged, in connection with the performance of work on this Project, excepting for liability arising from the sole negligence of the Owner or the Engineer.

GENERAL NOTES

1. Construction shall be in accordance with the Standard Specifications for Public Works Construction, 1970 Edition, and per City of Riverside standard drawings.
2. The developer shall arrange for a soil test by a Soil Engineer after the street has been prepared to rough grade. Depth of base mat'l. and A.C. paving shall be determined by the City of Riverside design standards and test procedures.
3. Location of driveway approaches, C/R Std. No. 302, to be determined at time of construction with the approval of the Traffic Engineer.
4. Curb and gutter shall be staked with 3 ft. offset at 25 ft. intervals.
5. It shall be the responsibility of the contractor to clear the right of way in accordance with the provisions of law as it affects each utility including irrigation lines and appurtenances and at no cost to the City.
6. Trim edge of existing pavement where new pavement joins to a smooth straight line. Construct match-up paving as shown and overlay paving as directed in the field to produce a smooth section. Engineer estimates overlay to be 66 tons.

⚠ Contractor to take necessary measures to protect buried 20" dia. manhole on watermain. M.H. at Sta. 141+70±, 2.5 ft. below existing grade.

R.S. 22/93

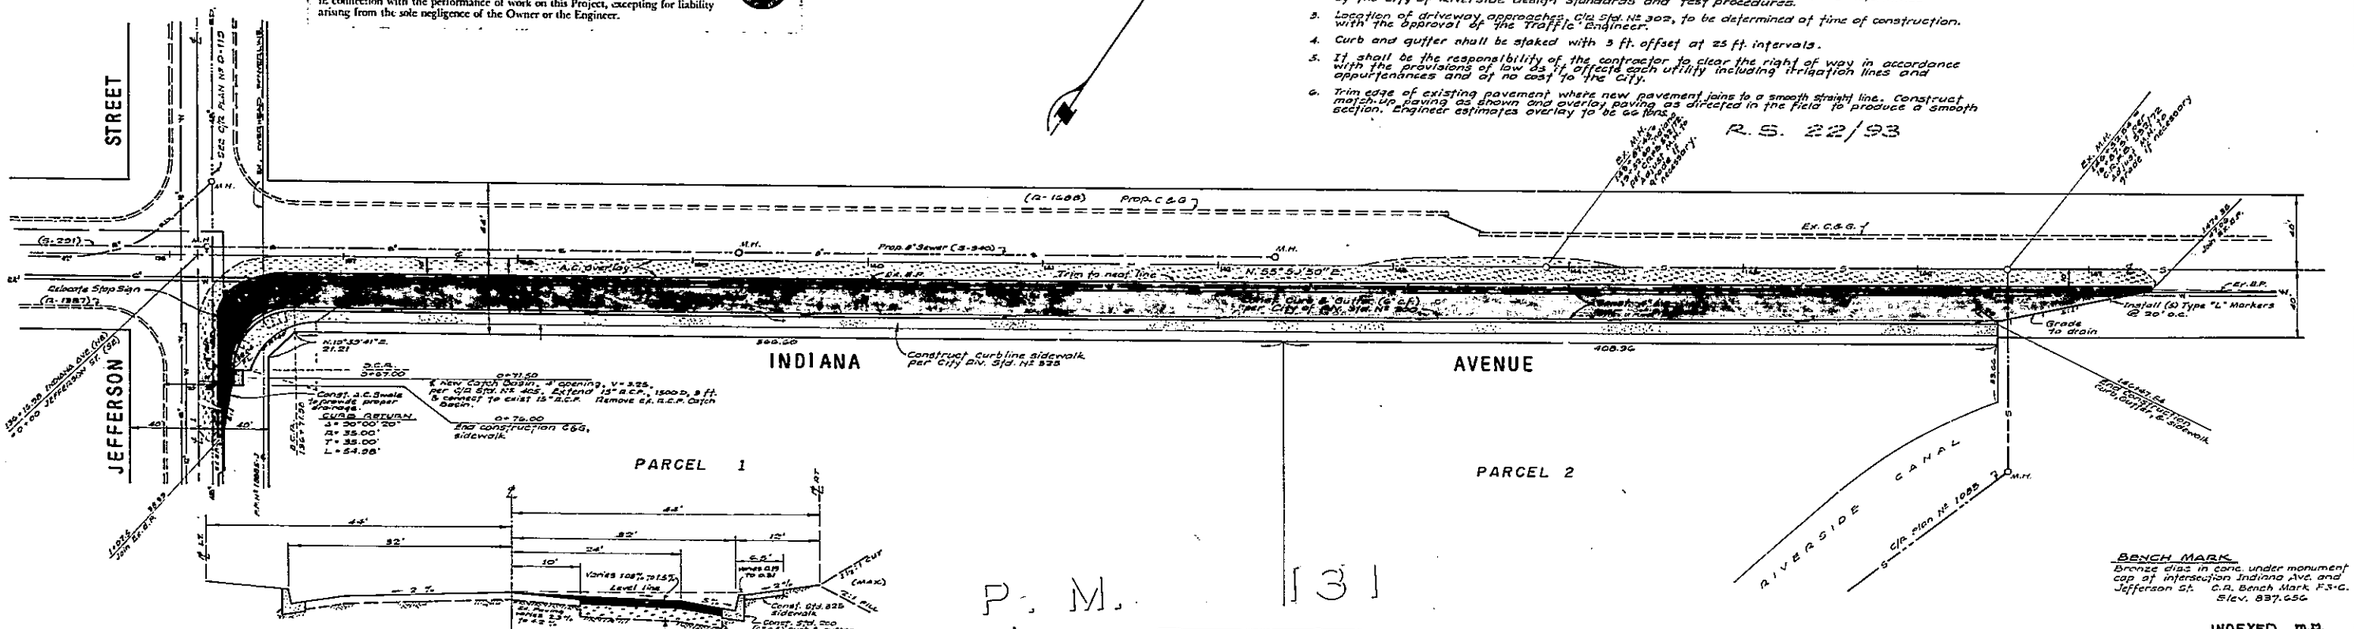

TYPICAL SECTION - INDIANA ST.
136+71.98 TO 146+47.54
NO SCALE
T.I. = 7

S.R. 784
R-74

P. M. 131

BENCH MARK
Bronze disc in conc. under monument cap at intersection Indiana Ave. and Jefferson St. C.R. Bench Mark F.S.-C. Elev. 837.656

INDEXED m.p.

EBB ASSOCIATES ENGINEERS CALIFORNIA		CITY OF RIVERSIDE, CALIFORNIA DEPARTMENT OF PUBLIC WORKS	STREET PLAN & PROFILE
5/24/73 R.C.E. NO. 9876	⚠ Added Water M.H. & note 1.1.11	APPROVED BY / DIRECTOR OF PUBLIC WORKS	PARCEL MAP NO. 131
Dr. M.H. MacArthur F.B. 1029	MARK / REVISIONS / APPR. / DATE	DATE 8/10/73	INDIANA AVENUE 136+16.98 TO 147+40.00
	DESIGNED BY JNB DRAWN BY VS/JNB CHECKED BY RH		HORIZ. SCALE: 1" - 40' VERT. SCALE: 1" - 4'

PROJECT NO. 71-279

R-1683

SHEET 1 OF 1

FILE NO. 71-279