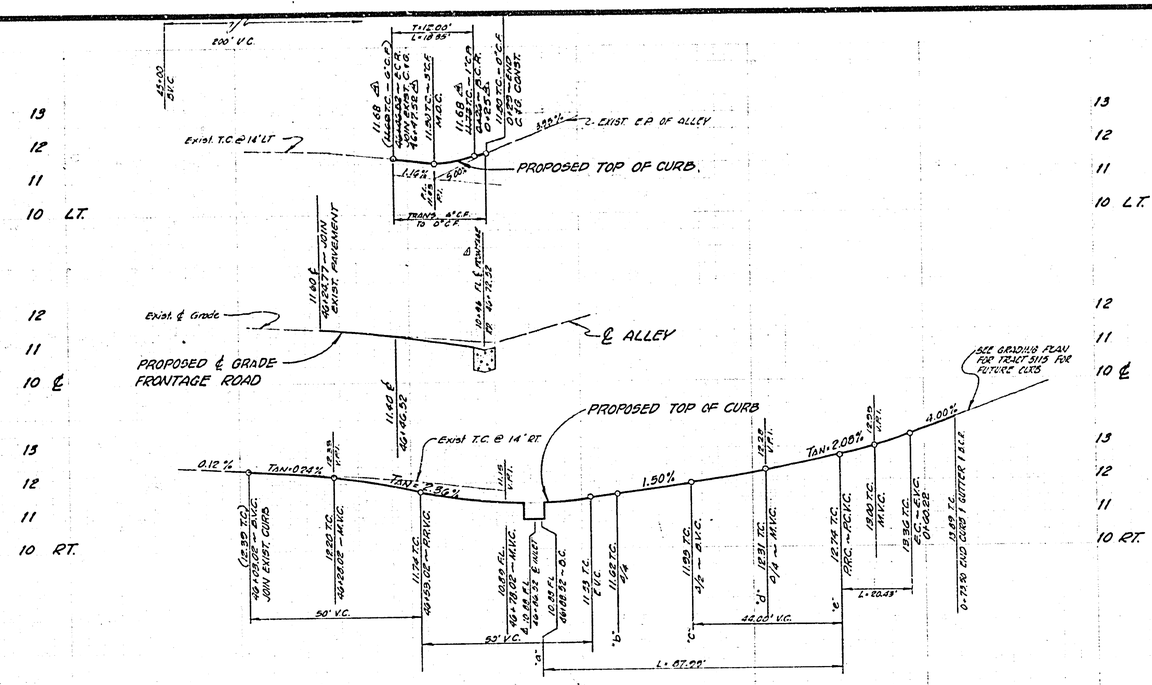

BENCH MARK: CITY B.M. H-8-C
NAIL AND TAG IN THE BASE OF LIGHT STANDARD AT THE M.O.C. OF THE SOUTHWEST CORNER OF CANYON CREST DR. AND CENTRAL AVE.
ELEV. : 1103.51

CONSTRUCTION NOTES:

1. CONSTRUCT CURB AND GUTTER PER CITY OF RIVERSIDE STD. Nº 200 (6" C.F.).
2. CONSTRUCT CURB SIDEWALK PER CITY OF RIVERSIDE STD Nº 325.
3. CONSTRUCT CROSS GUTTER AND APRON PER CITY OF RIVERSIDE STD Nº 220. (8' WIDE)
4. CONSTRUCT 0.5' A.C. OVER 0.38' D.G. OR 0.38' FULL DEPTH A.C. OVER COMPACTED NATIVE SOIL.
5. CONSTRUCT 6' WIDE DRAIN CHANNEL PER DETAIL HEREON.
6. REMOVE EXISTING CURB, GUTTER AND D/W DEPRESSION BET. STA. 46+46.52 AND 46+78.52.
7. REMOVE EXISTING SIDEWALK AND DRIVE APPROACH.
8. REMOVE EXISTING CURB BET. STA 46+03.02 AND 46+78.52
9. REMOVE EXISTING A.C. PAVEMENT.
10. CONSTRUCT PROPERTY LINE SIDEWALK PER CITY OF RIVERSIDE STD Nº 325.
11. REMOVE EXISTING REDWOOD HEADER AND BARRICADE.

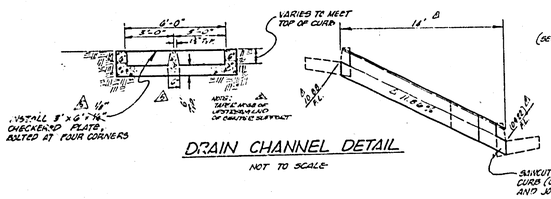

DRAIN CHANNEL DETAIL
NOT TO SCALE

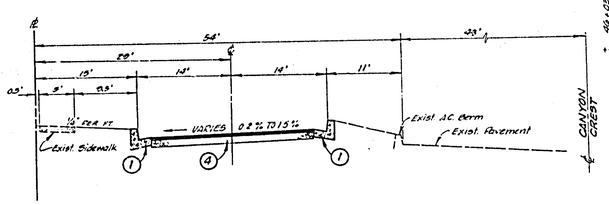

TYPICAL SECTION
FRONTAGE ROAD
NOT TO SCALE
T.I. = 5.0

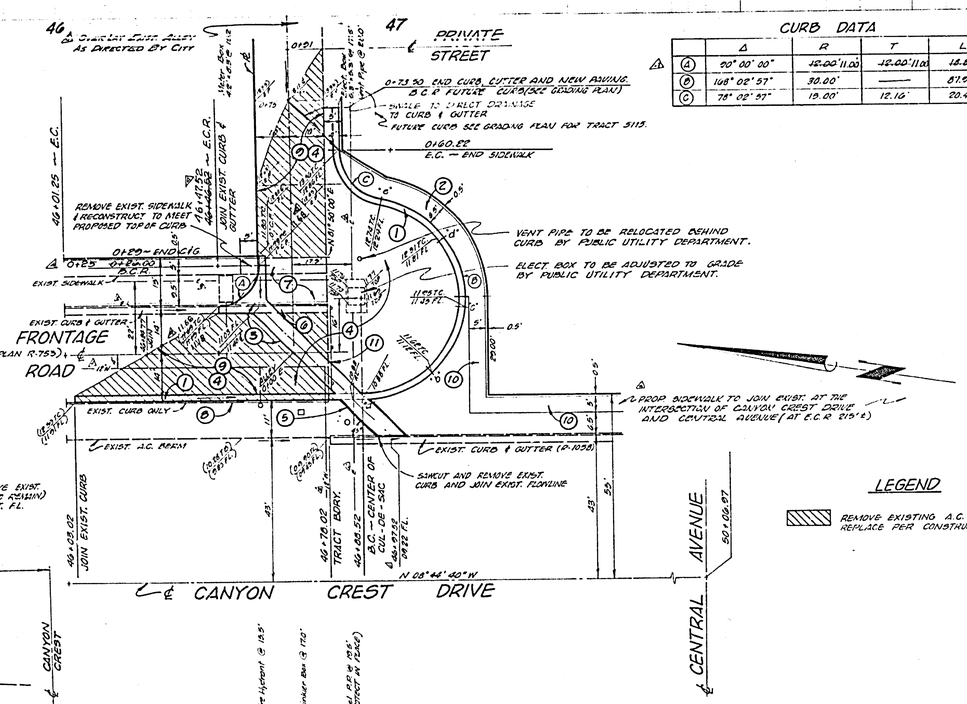

CURB DATA

	Δ	R	T	L
(A)	20° 00' 00"	12.00'±1.00	12.00'±1.00	16.85'±1.00
(B)	148° 02' 57"	30.00'	——	87.99'
(C)	78° 02' 57"	15.00'	12.16'	20.43'

GENERAL NOTES:

1. It shall be the responsibility of the contractor to clear the right of way in accordance with the provisions of law and to protect each utility including irrigation lines and appurtenances and at no cost to the City.
2. Construction shall be in accordance with the City of Riverside, Department of Public Works, Standard Drawings and the Standard Specifications, for Public Works Construction, 1973 Edition.
3. Prime coat, seal coat, and paint binder are required.
4. Trim edge of existing pavement where new pavement joins existing pavement to a smooth straight line. Construct matchup paving as shown and overlay paving as directed in the field to produce a smooth section. Engineer estimates available to be 2 tons.
5. CURB AND GUTTER TO BE STAKED AT 5' OFFSETS AND 25' INTERVALS.

LEGEND

REMOVE EXISTING A.C. PAVEMENT AND REPLACE PER CONSTRUCTION NOTE 4.

Contractor agrees that he shall assume sole and complete responsibility for job site conditions during the course of construction of this Project, including safety of all persons and property; that this requirement shall apply continuously and not be limited to normal working hours; and that the Contractor shall defend, indemnify and hold the Owner and the Engineer harmless from any and all liability, real or alleged, in connection with the performance of work on this Project, excepting for liability arising from the sole negligence of the Owner or the Engineer.

J. F. DAVIDSON ASSOCIATES
CIVIL ENGINEERS · SURVEYORS · PLANNERS
RIVERSIDE, CALIFORNIA
APPROVED BY Robert S. Kopin DATE 7-25-73
R.E. No. 18893
W.O. 3724 FOR: FOUNDERS Mortgage Co. F.B. 1079/40-49

MARK	REVISIONS	APPR.	DATE
3	RELOCATED L GUTTER & DRAIN CHANNEL DUE TO PP 2W	RFD	7/31/73
2	ADDED UTILITIES	RFD	8/16/73
1	ADDED SW NOTE &	RFD	9/18/73
4	REV. C.R. A FROM R=12' TO R=11' MIN.	RFD	4/10/74
5	ADDED CBR SURVEY FOR PAVEMENT	RFD	8/16/74
6	ADD C STANDARD DRAWING	RFD	8/16/74

DESIGNED BY R.G. DRAWN BY R.G. CHECKED BY

CITY OF RIVERSIDE, CALIFORNIA
DEPARTMENT OF PUBLIC WORKS

APPROVED BY	BY	DATE
OFFICE ENGINEER		8/24
PARK DEPARTMENT	—	—
TRAFFIC DIVISION		8-27-73
ASSISTANT CITY ENG.		8-27

APPROVED BY DIRECTOR OF PUBLIC WORKS
DATE 8/27/73

S.R.º 477 R-45
STREET PLAN & PROFILE
FRONTAGE ROAD
TRACT 5115
HORIZ. SCALE: 1" - 20' VERT. SCALE: 1" - 2'

PROJECT NO. R-1706
SHEET 1 OF 1
FILE NO. 4464