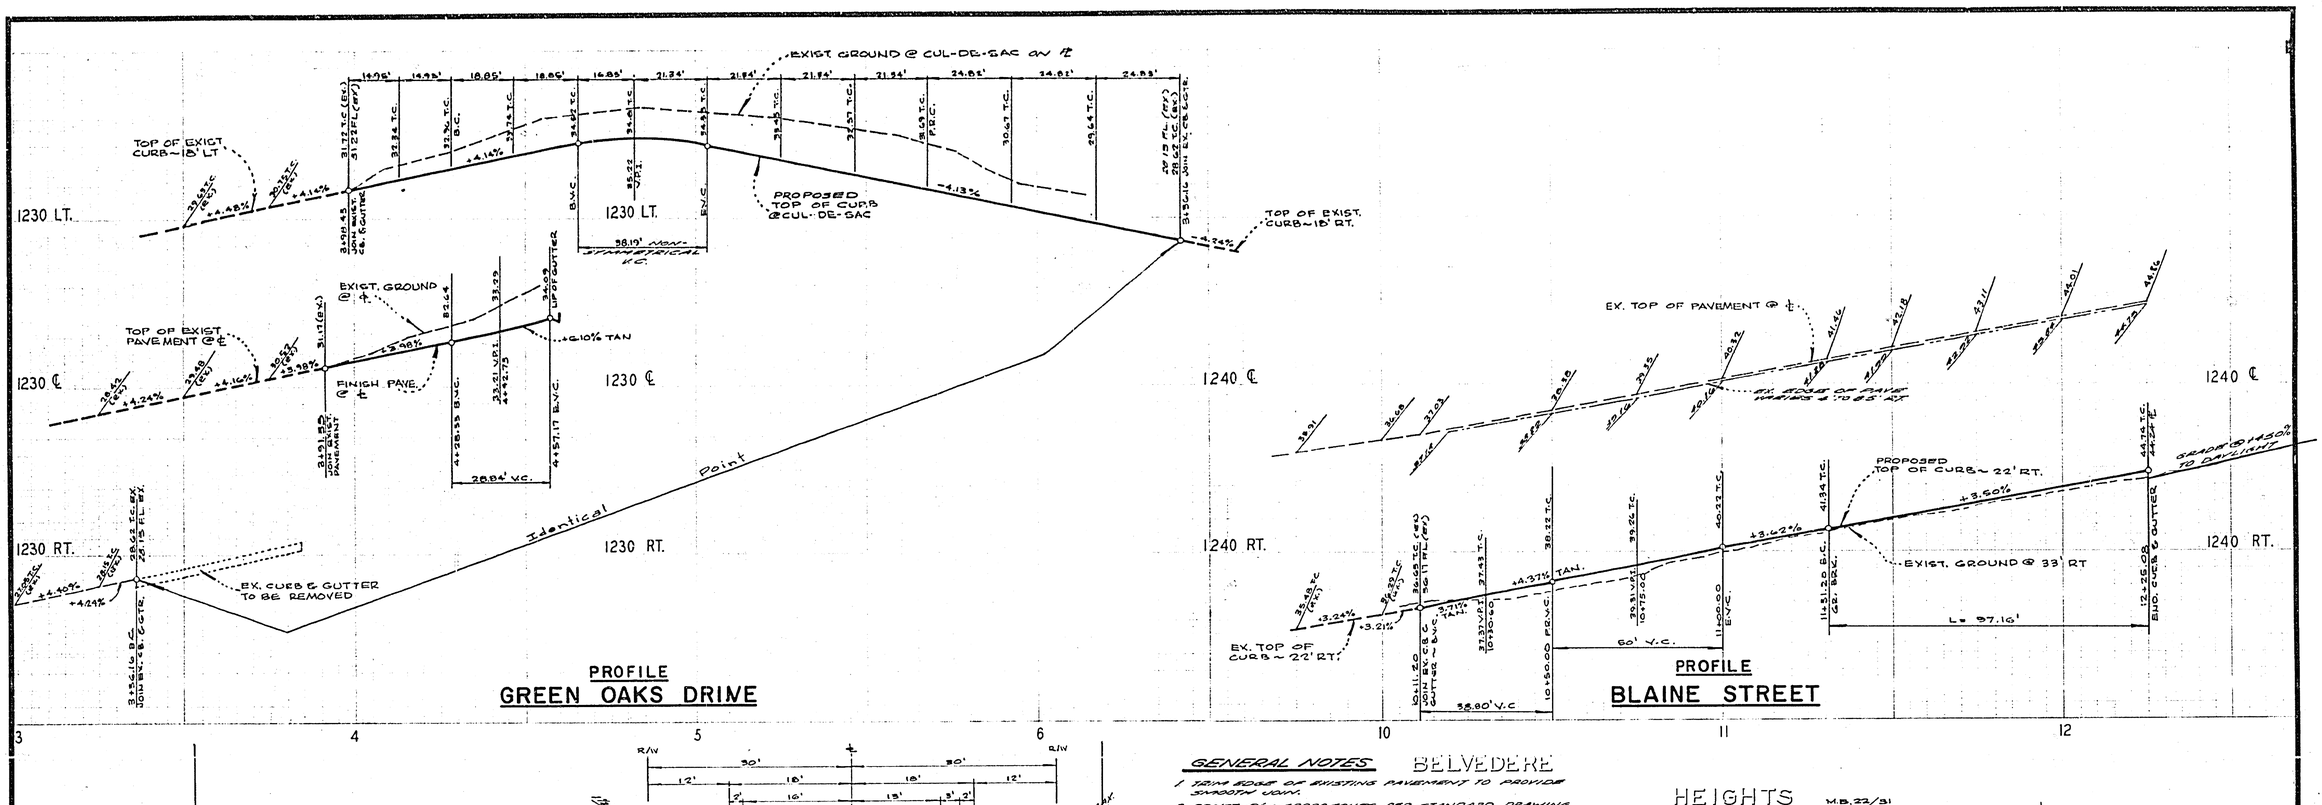

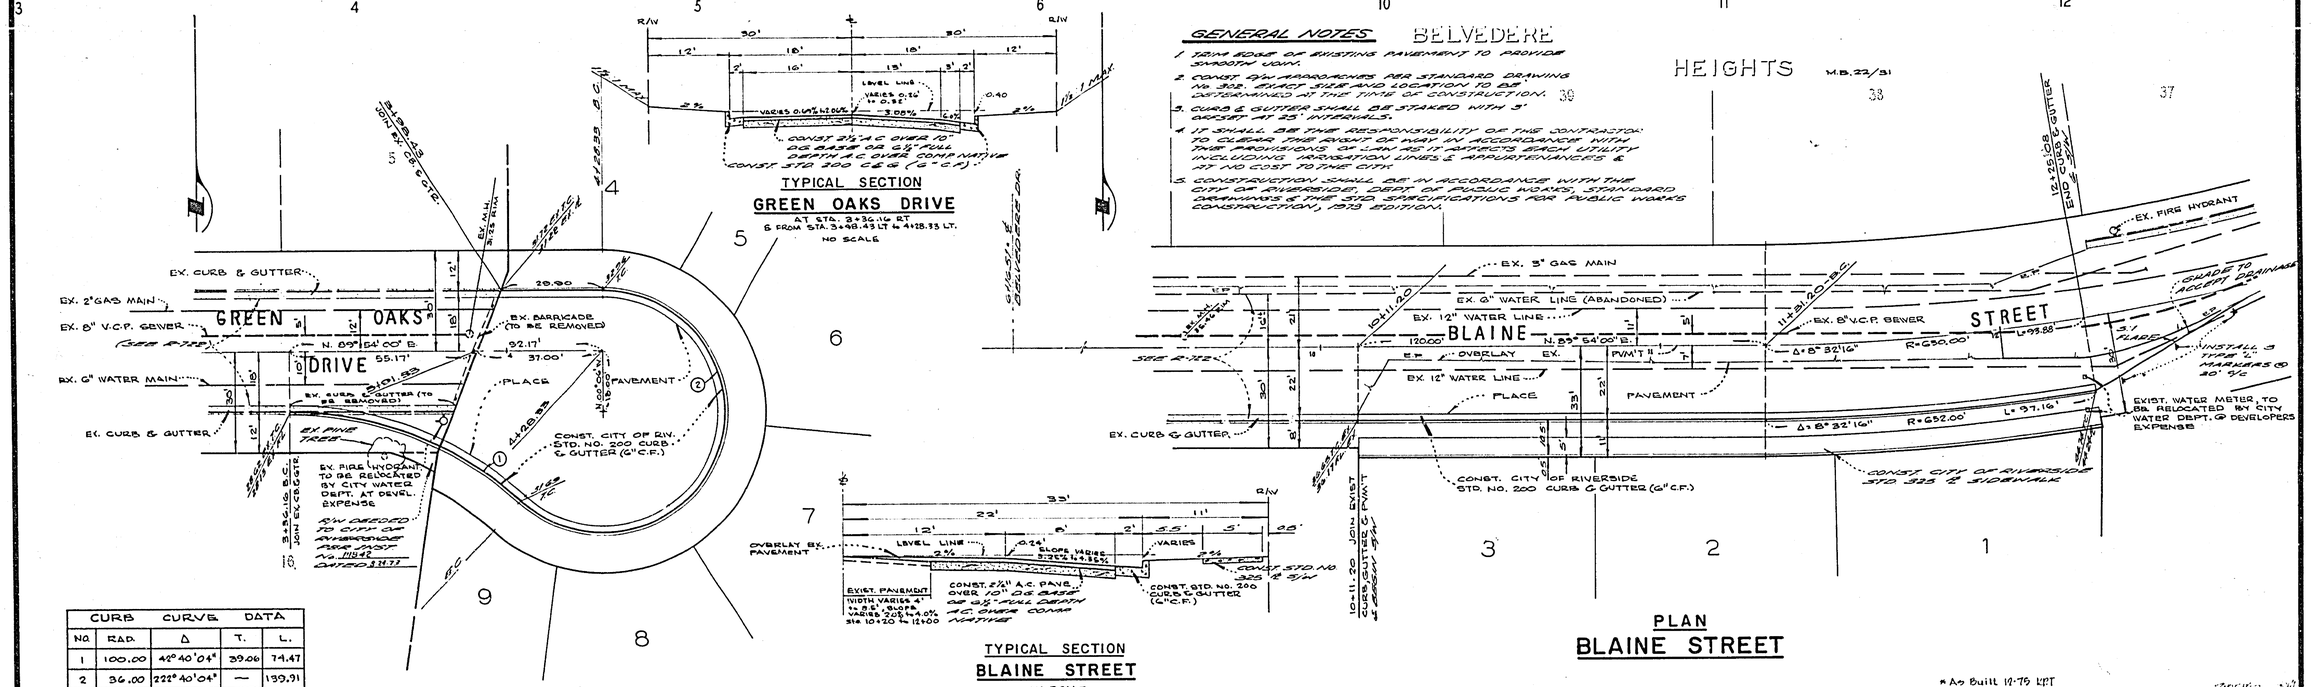

CURB CURVE DATA				
NO.	RAD.	Δ	T.	L.
1	100.00	42° 40' 04"	39.00	74.47
2	36.00	222° 40' 04"	—	139.91

Bench Mark

P.K. NAIL AT WEST B.C.R. OF S.W. CURB RETURN AT BLAINE STREET & MARICOPA DRIVE (P.B. M-1/72). ELEV. 1214.77

ALBERT A. WEBB ASSOCIATES
CIVIL ENGINEERS
RIVERSIDE, CALIFORNIA
APPROVED BY L.A. Warnick DATE 8-20-73
R.E. No. 10056

W.O. 72-283 FOR: GEORGE WEIDE — F.B. 1029 — DESIGNED BY P.W. — DRAWN BY W.J.K. CHECKED BY B.K.

MARK	REVISIONS	APPR.	DATE

CITY OF RIVERSIDE, CALIFORNIA
PUBLIC WORKS DEPARTMENT

APPROVED BY	BY	DATE
PRINCIPAL ENGINEER		
PARK DEPARTMENT		
TRAFFIC DIVISION		
CHIEF PUB. WKS. ENGR.		

APPROVED BY
DIRECTOR OF PUBLIC WORKS
DATE 9-14-73

TRACT NO. 4783
STREET PLAN AND PROFILE
GREEN OAKS DRIVE
BLAINE STREET
SCALES: 1" = 20' HORIZ.; 1" = 4' VERT.

ACCOUNT No 72-283
DRAWING NUMBER R-1712
SHEET 1 OF 1
72-283-A

* As Built 12-75 KPT