SCALE
Horizontal 1" = 40'
Vertical 1" = 4'

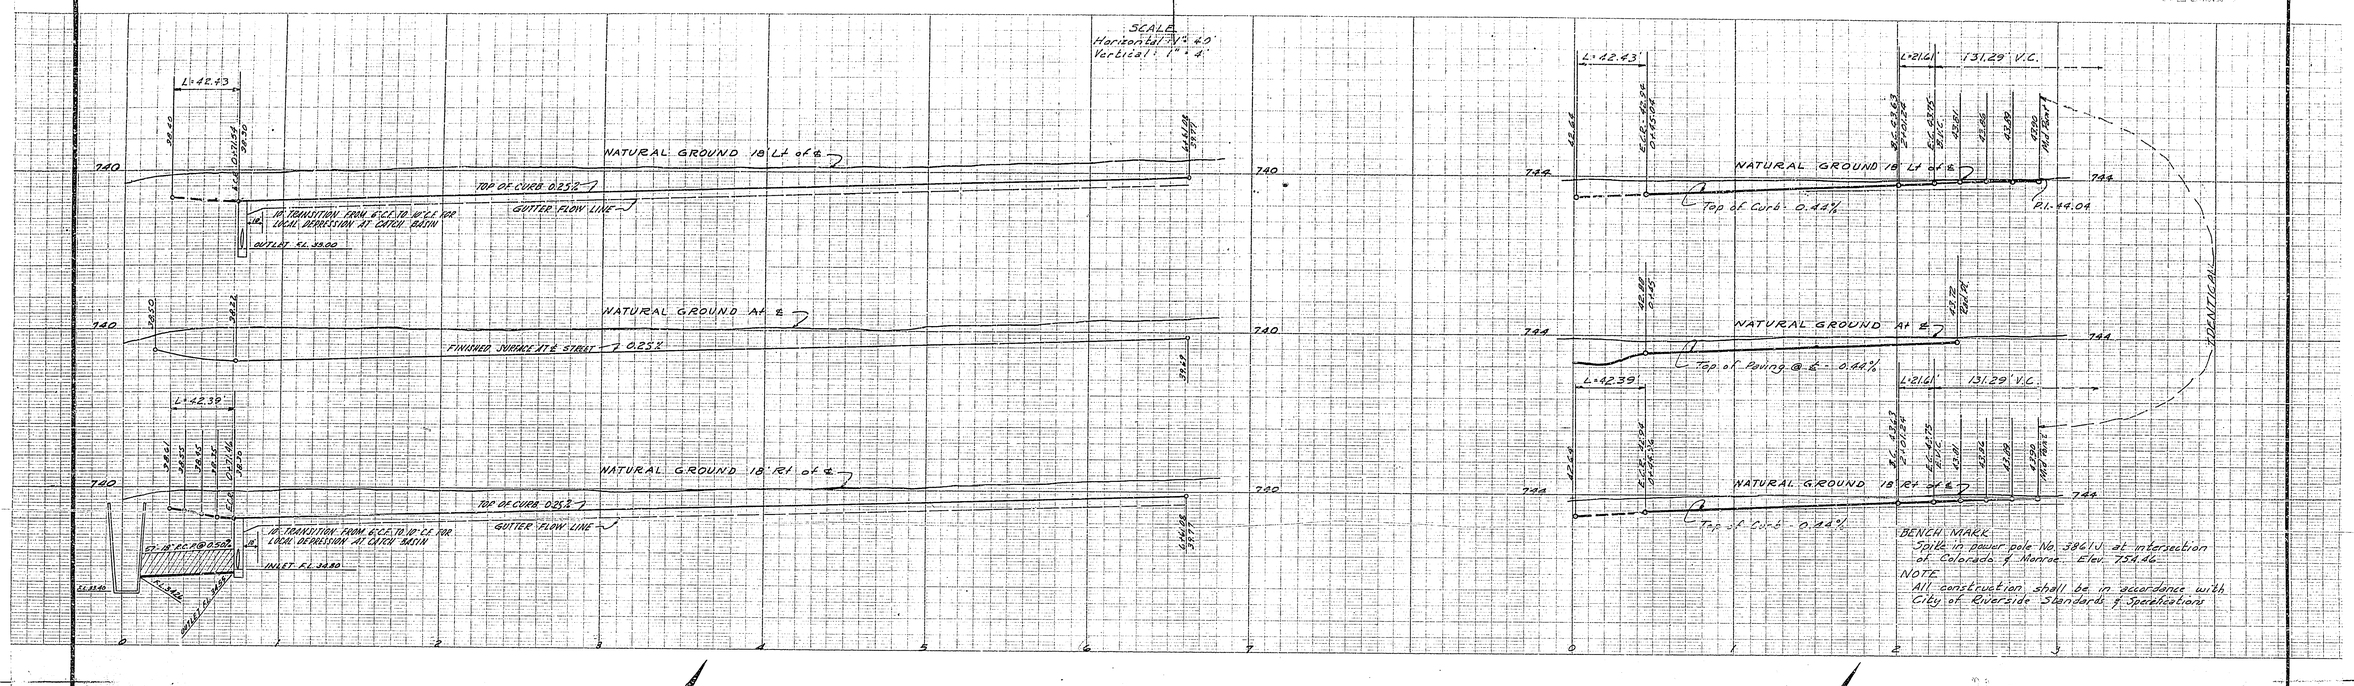

BENCH MARK
Spike in power pole No. 3861U at intersection of Colorado & Monroe. Elev. 754.46

NOTE
All construction shall be in accordance with City of Riverside Standards & Specifications

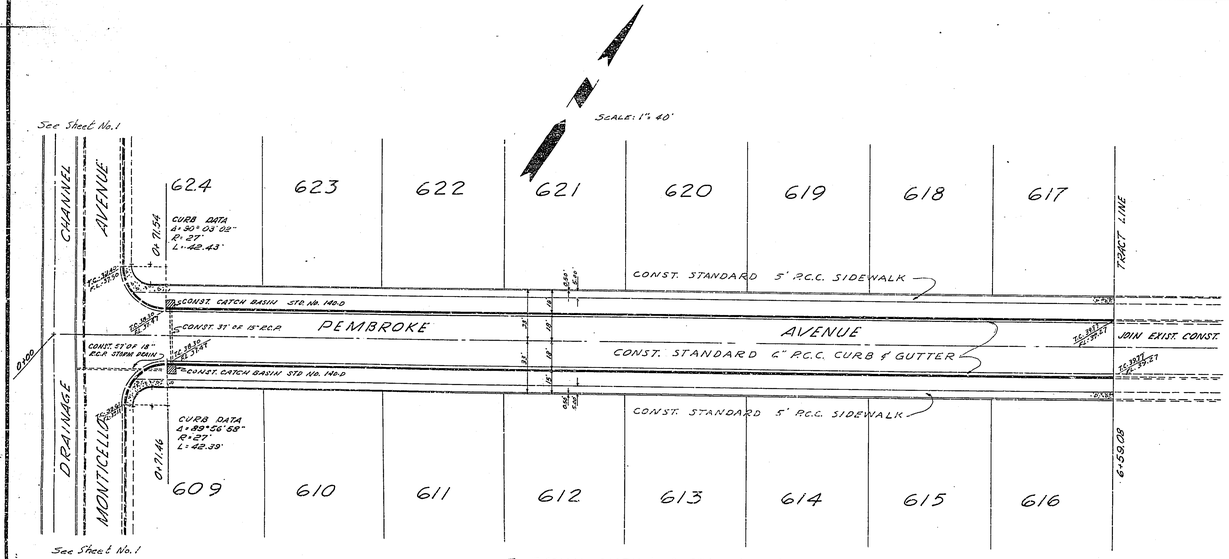

For TYPICAL SECTION of PEMBROKE AVE.
See Sheet 3

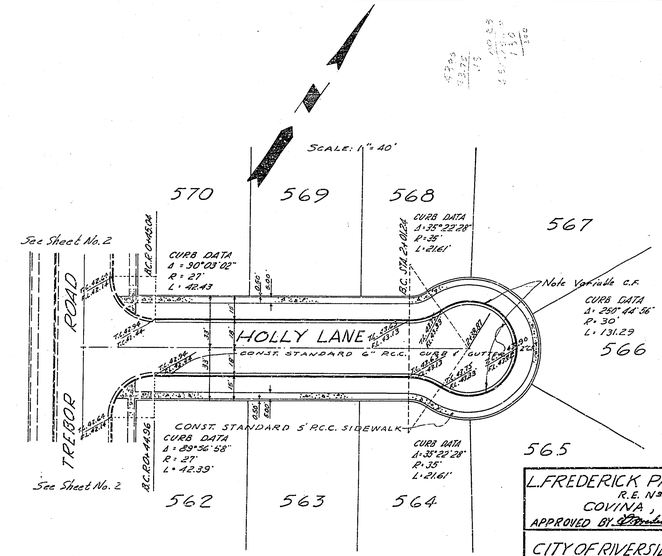

For TYPICAL SECTION of HOLLY LANE
See Sheet 3

L. FREDERICK PACK-CIVIL ENGR.
R.E. Nº 7448
COVINA, CALIFORNIA
APPROVED BY L. Frederick Pack DATE 12-3-57

CITY OF RIVERSIDE, CALIFORNIA
DEPARTMENT OF PUBLIC WORKS

STREET PLAN & PROFILE
BROCKTON HEIGHTS Nº 9

PEMBROKE AVE - HOLLY LANE

HORIZ. SCALE 1" = 40' VERT. SCALE 1" = 4'

APPROVED BY
DIRECTOR of PUBLIC WORKS
DATE 1/16/58

NO. R-173
SHEET 5 OF 5

J.B.

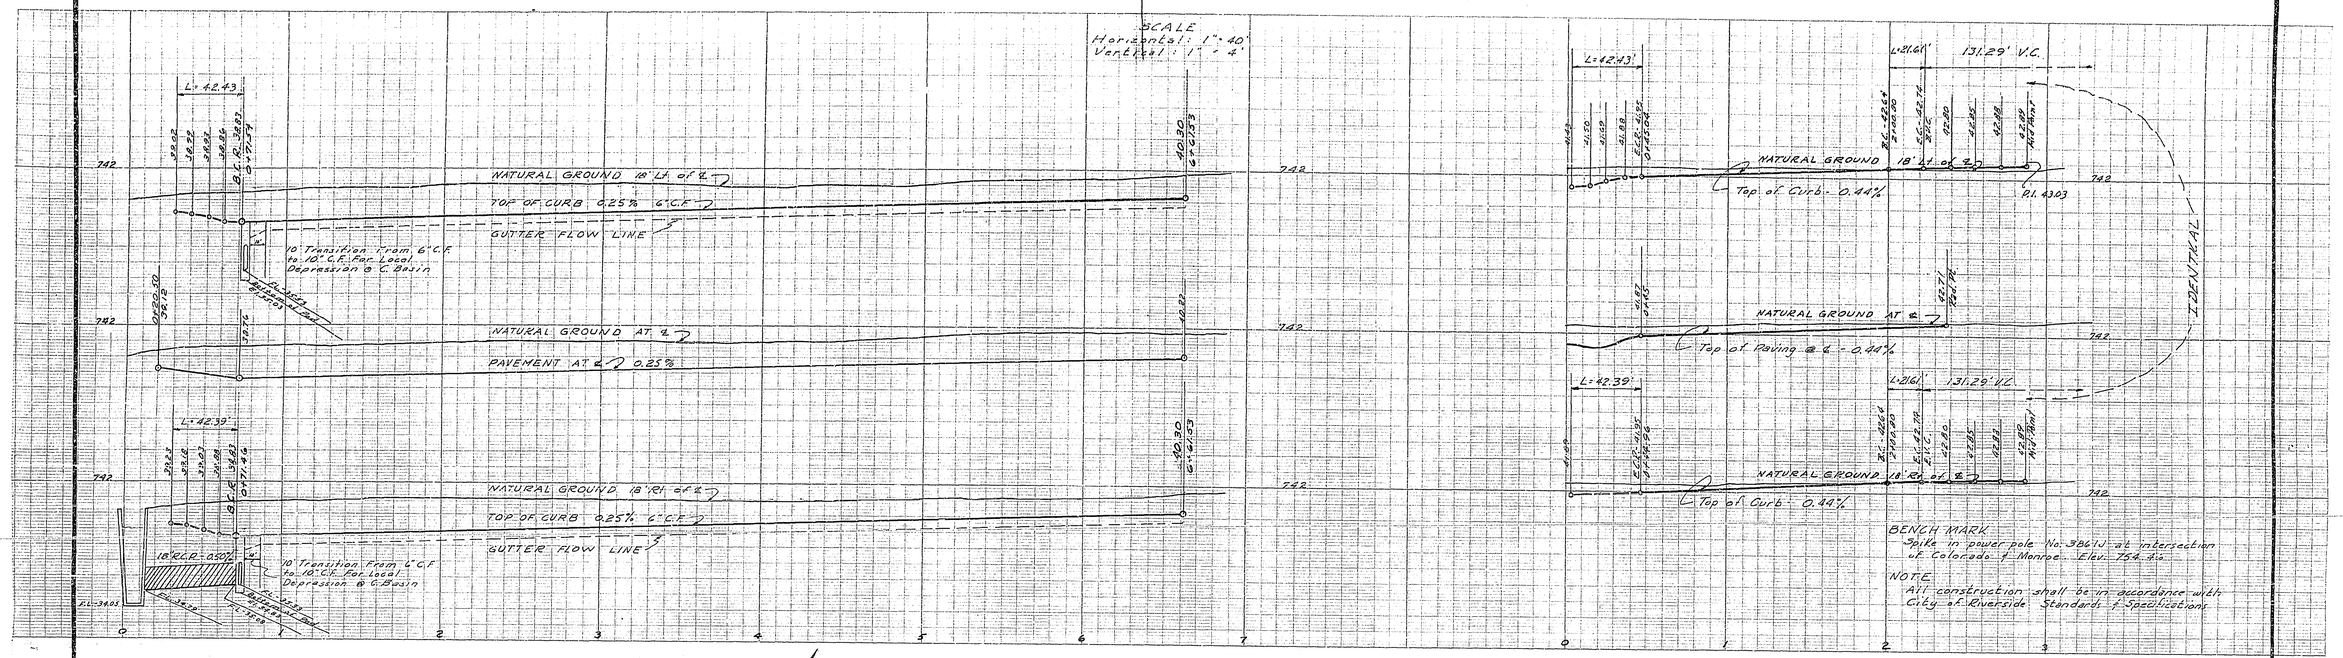

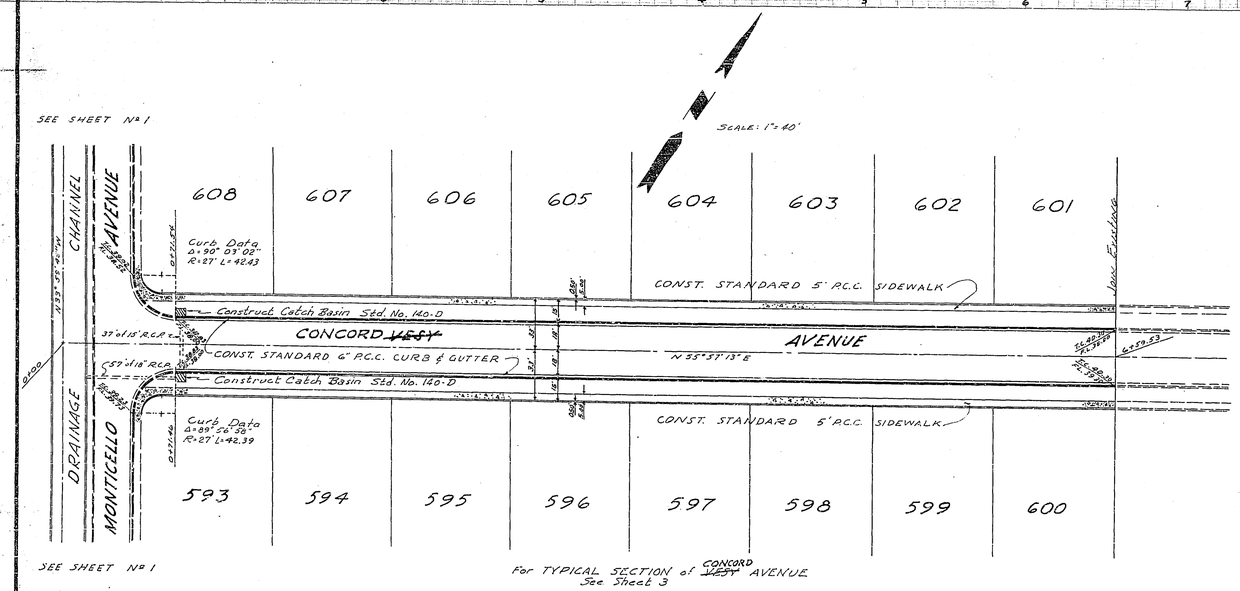

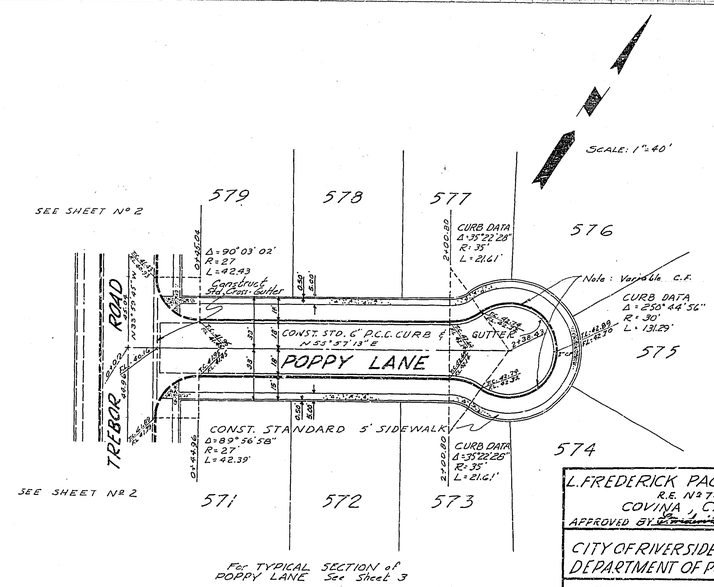

L. FREDERICK PACK CIVIL ENGR.
R.E. Nº 7448
COVINA, CALIFORNIA
APPROVED BY ~~[illegible]~~ DATE 12-3-57

CITY OF RIVERSIDE, CALIFORNIA
DEPARTMENT OF PUBLIC WORKS

STREET PLAN & PROFILE
BROCKTON HEIGHTS Nº 9
CONCORD ~~VEST~~ AVE. & POPPY LANE

HORIZ. SCALE 1" = 40' VERT. SCALE 1" = 4'

APPROVED BY
DIRECTOR of PUBLIC WORKS
DATE 1/16/58

NO. R-173
SHEET 4 OF 5

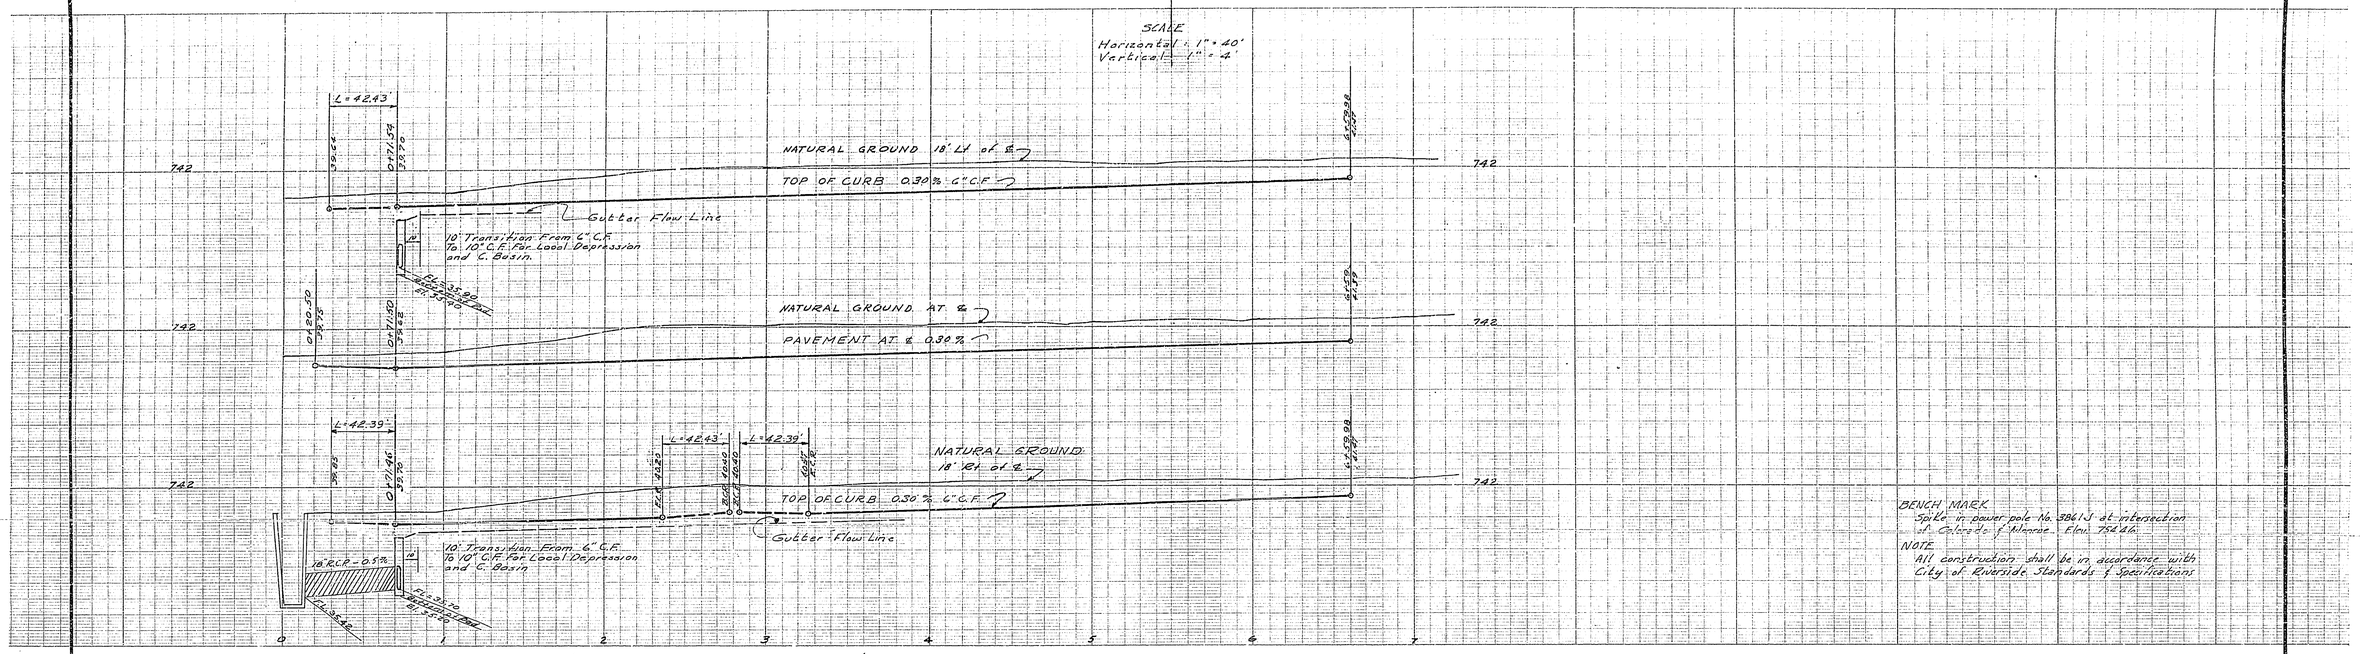

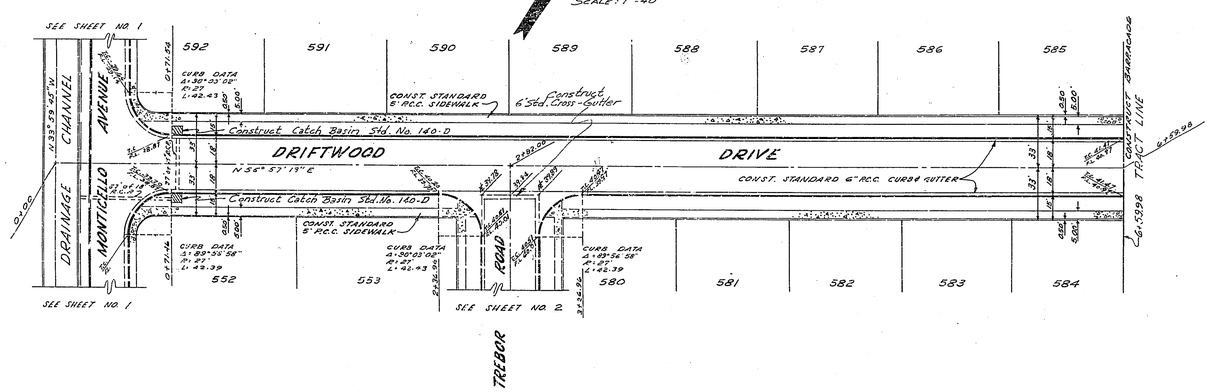

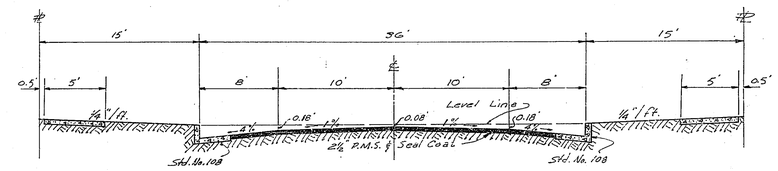

TYPICAL SECTION

	TREBOR ROAD	SHEET 2
	DRIFTWOOD DRIVE	SHEET 3
CONCORD	~~WEST~~ AVENUE	SHEET 4
	POPPY LANE	SHEET 4
	PEMBROKE AVENUE	SHEET 5
	HOLLY LANE	SHEET 5

No Scale

L. FREDERICK PACK-CIVIL ENGR.
R.E. No 7448
COVINA, CALIFORNIA
APPROVED BY L. Frederick Pack DATE 12-3-57

CITY OF RIVERSIDE, CALIFORNIA
DEPARTMENT OF PUBLIC WORKS

STREET PLAN & PROFILE
BROCKTON HEIGHTS No 9

DRIFTWOOD DRIVE

HORIZ. SCALE 1" = 40' VERT. SCALE 1" = 4'

APPROVED BY
DIRECTOR OF PUBLIC WORKS
DATE 1/16/58

NO. R-173
SHEET 3 OF 5

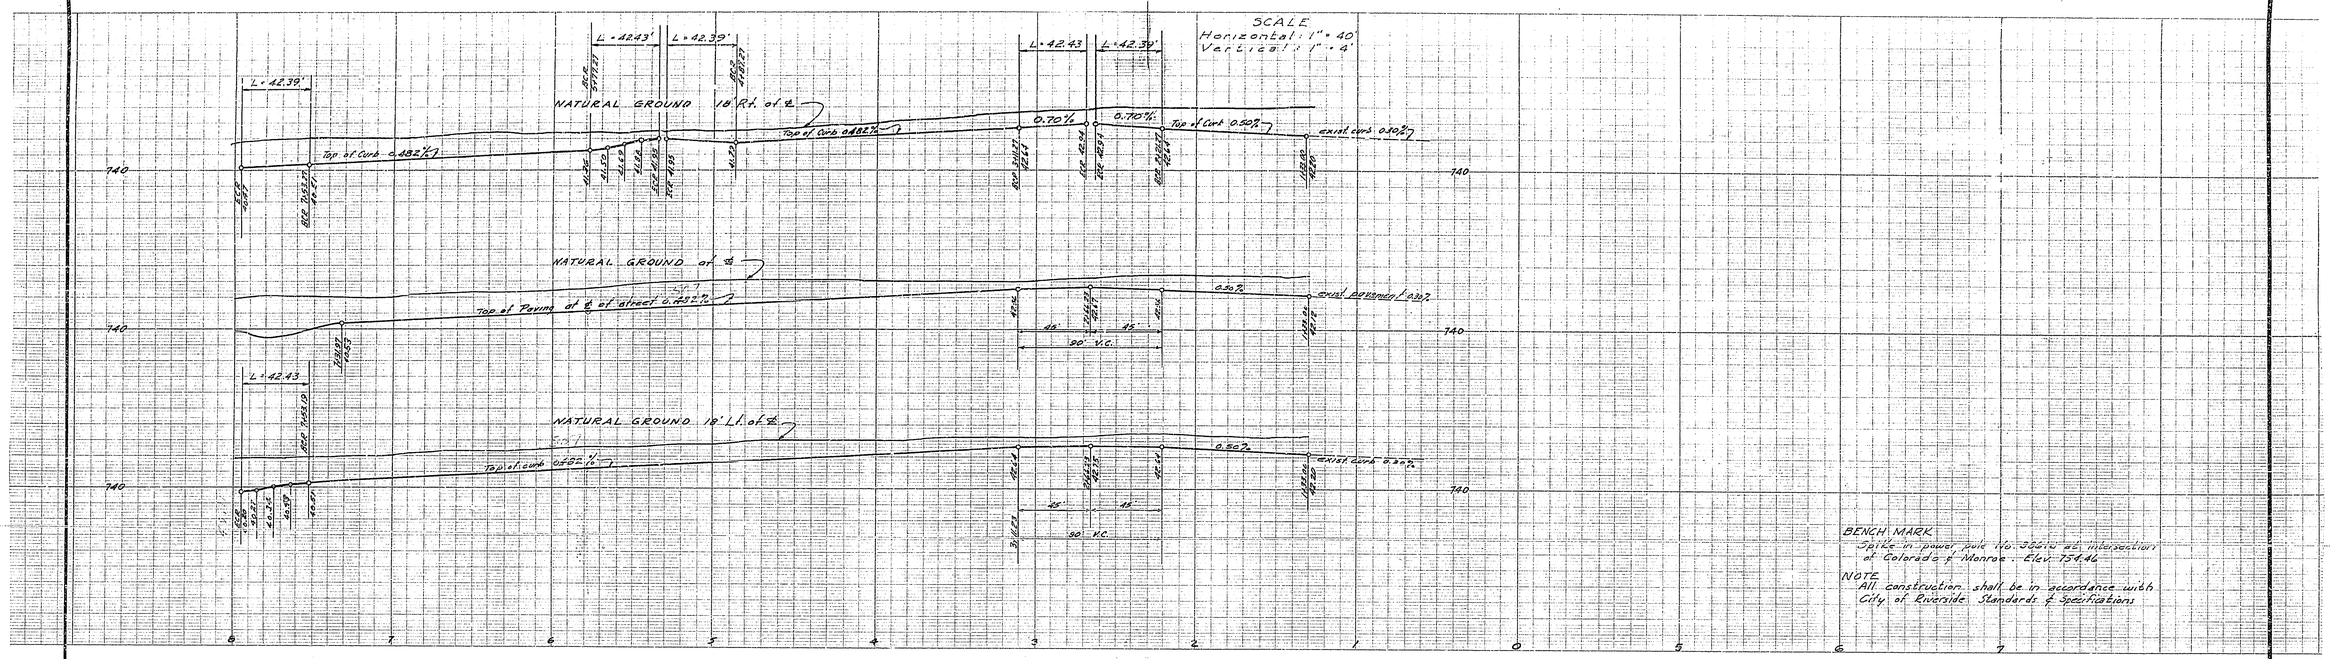

BENCH MARK
Spike in power pole No. 3661W at intersection of Colorado & Monroe - Elev. 754.46

NOTE
All construction shall be in accordance with City of Riverside Standards & Specifications

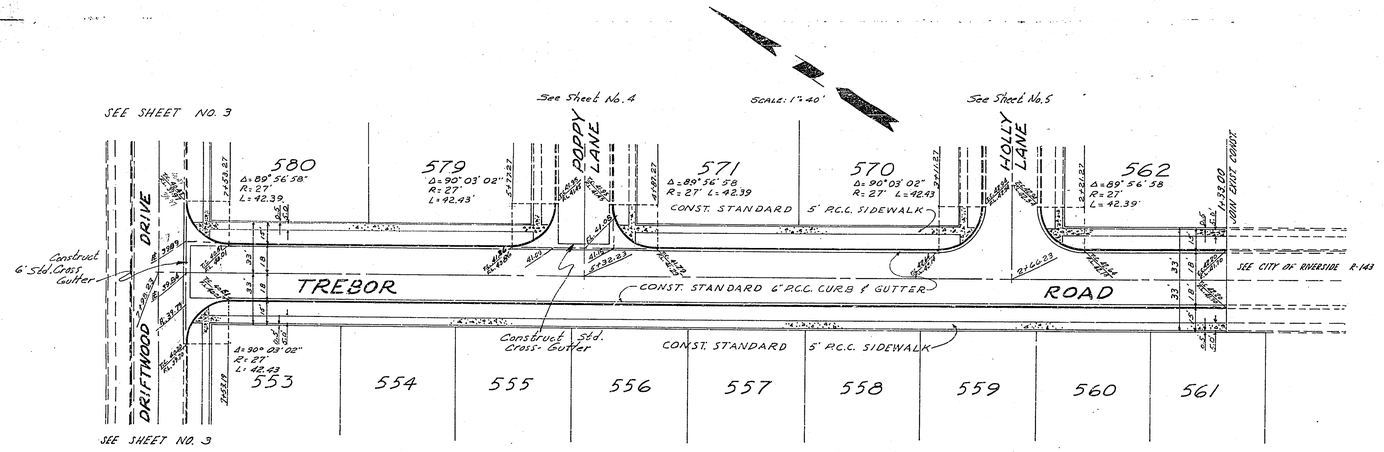

For TYPICAL SECTION of TREBOR ROAD
See Sheet 3

L. FREDERICK PACK-CIVIL ENGR.
R.E. No. 7448
COVINA, CALIFORNIA
APPROVED BY [illegible] DATE 12-3-57

CITY OF RIVERSIDE, CALIFORNIA
DEPARTMENT OF PUBLIC WORKS

STREET PLAN & PROFILE
BROCKTON HEIGHTS No. 9

TREBOR ROAD

HORIZ. SCALE 1" = 40' VERT. SCALE 1" = 4'

APPROVED BY [illegible]
DIRECTOR OF PUBLIC WORKS
DATE 1/16/58

NO. R-173
SHEET 2 OF 5

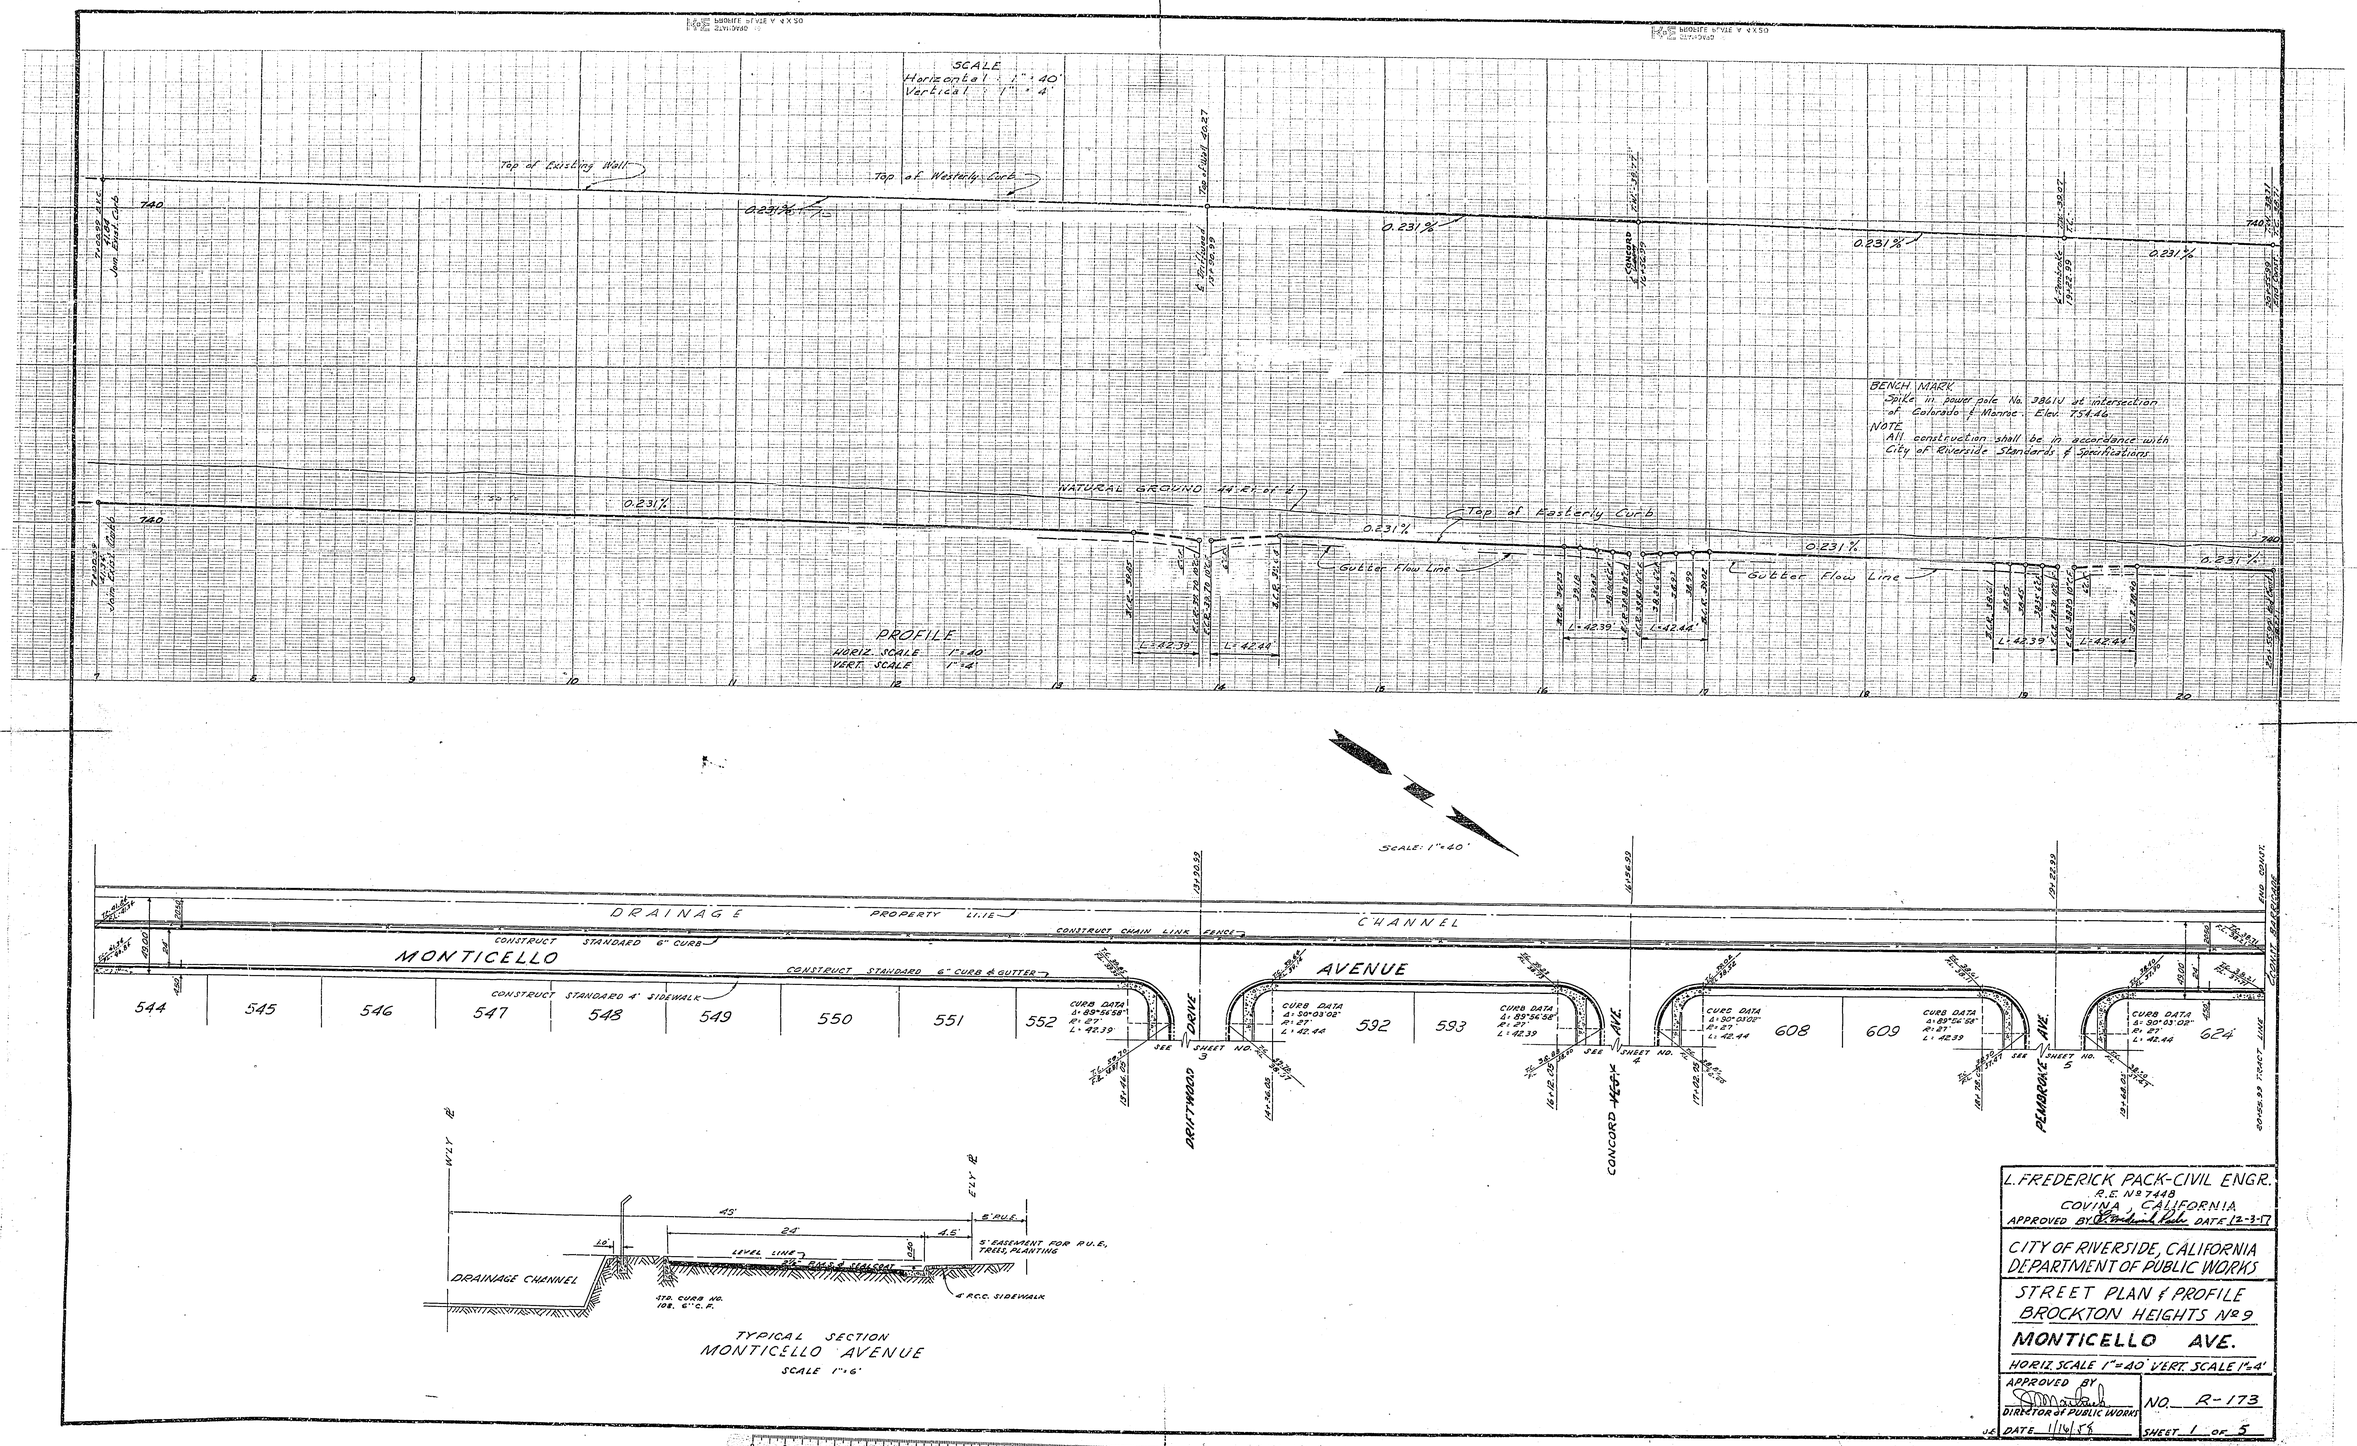

L. FREDERICK PACK-CIVIL ENGR.
R.E. No 7448
COVINA, CALIFORNIA
APPROVED BY [signature] DATE 12-3-57

CITY OF RIVERSIDE, CALIFORNIA
DEPARTMENT OF PUBLIC WORKS

STREET PLAN & PROFILE
BROCKTON HEIGHTS No 9

MONTICELLO AVE.

HORIZ. SCALE 1" = 40' VERT. SCALE 1" = 4'

APPROVED BY [signature]
DIRECTOR of PUBLIC WORKS
DATE 1/16/58

NO. R-173
SHEET 1 OF 5