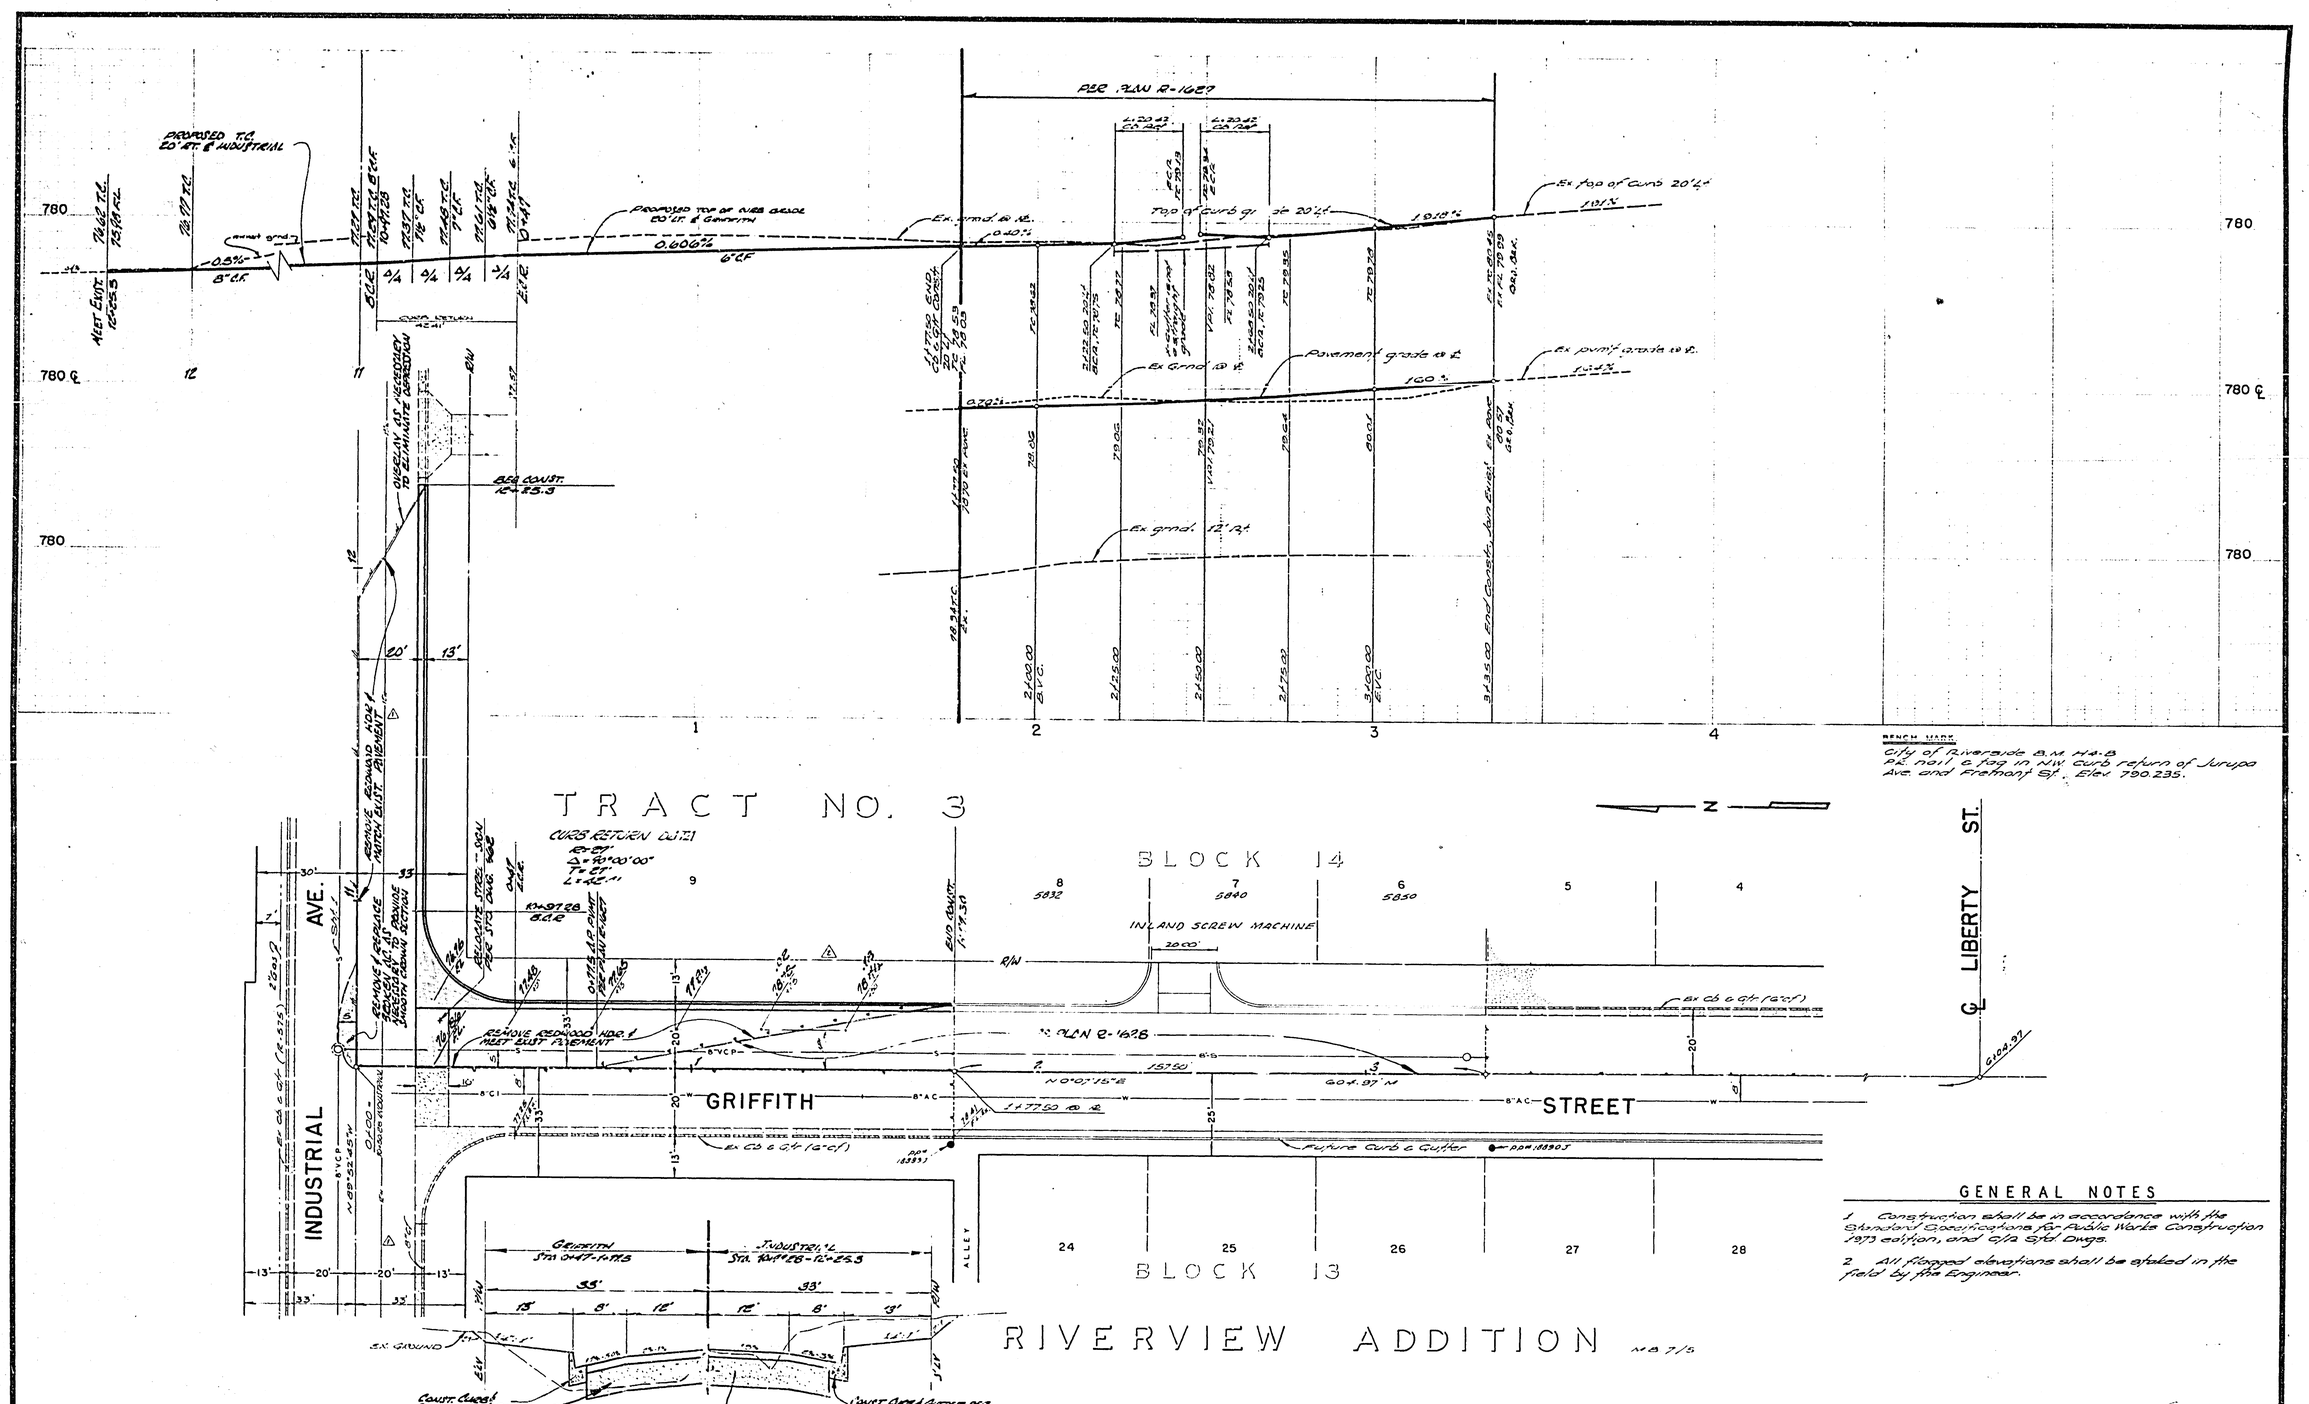

BENCH MARK
City of Riverside B.M. H4-B
PK nail & tag in NW curb return of Jurupa Ave and Fremont St. Elev 790.235.

NOTICE TO CONTRACTOR

The existence and location of any underground utility pipes or structures shown on these plans are obtained by a search of the available records. To the best of our knowledge, there are no existing utilities except as shown on these plans.

The Contractor is required to take due precautionary measures to protect the utility lines shown and any other lines not of record or not shown on these plans.

GENERAL NOTES

1. Construction shall be in accordance with the Standard Specifications for Public Works Construction 1973 edition, and c/a Std Dwgs.
2. All flagged elevations shall be staked in the field by the Engineer.

SR 87 R-38

MARK	REVISIONS	APPR.	DATE
	ADDED 12" WATER LINE IN INDUSTRIAL		

DESIGNED BY ___ DRAWN BY ___ CHECKED BY ___

CITY OF RIVERSIDE, CALIFORNIA
PUBLIC WORKS DEPARTMENT

APPROVED BY	BY	DATE
PRINCIPAL ENGINEER		
PARK DEPARTMENT		
TRAFFIC DIVISION		
CHIEF PUB. WKS. ENGR.		

APPROVED BY
DIRECTOR OF PUBLIC WORKS
DATE

STREET PLAN AND PROFILE
6158 - 6190
INDUSTRIAL AVE.

SCALE: HORIZ. 1" = 20' VERT. 1" = 4'

ACCOUNT No.
DRAWING NUMBER R-1732
SHEET 1 OF 1
72-321-A

ADOPTED FROM PLAN NO. R-1628