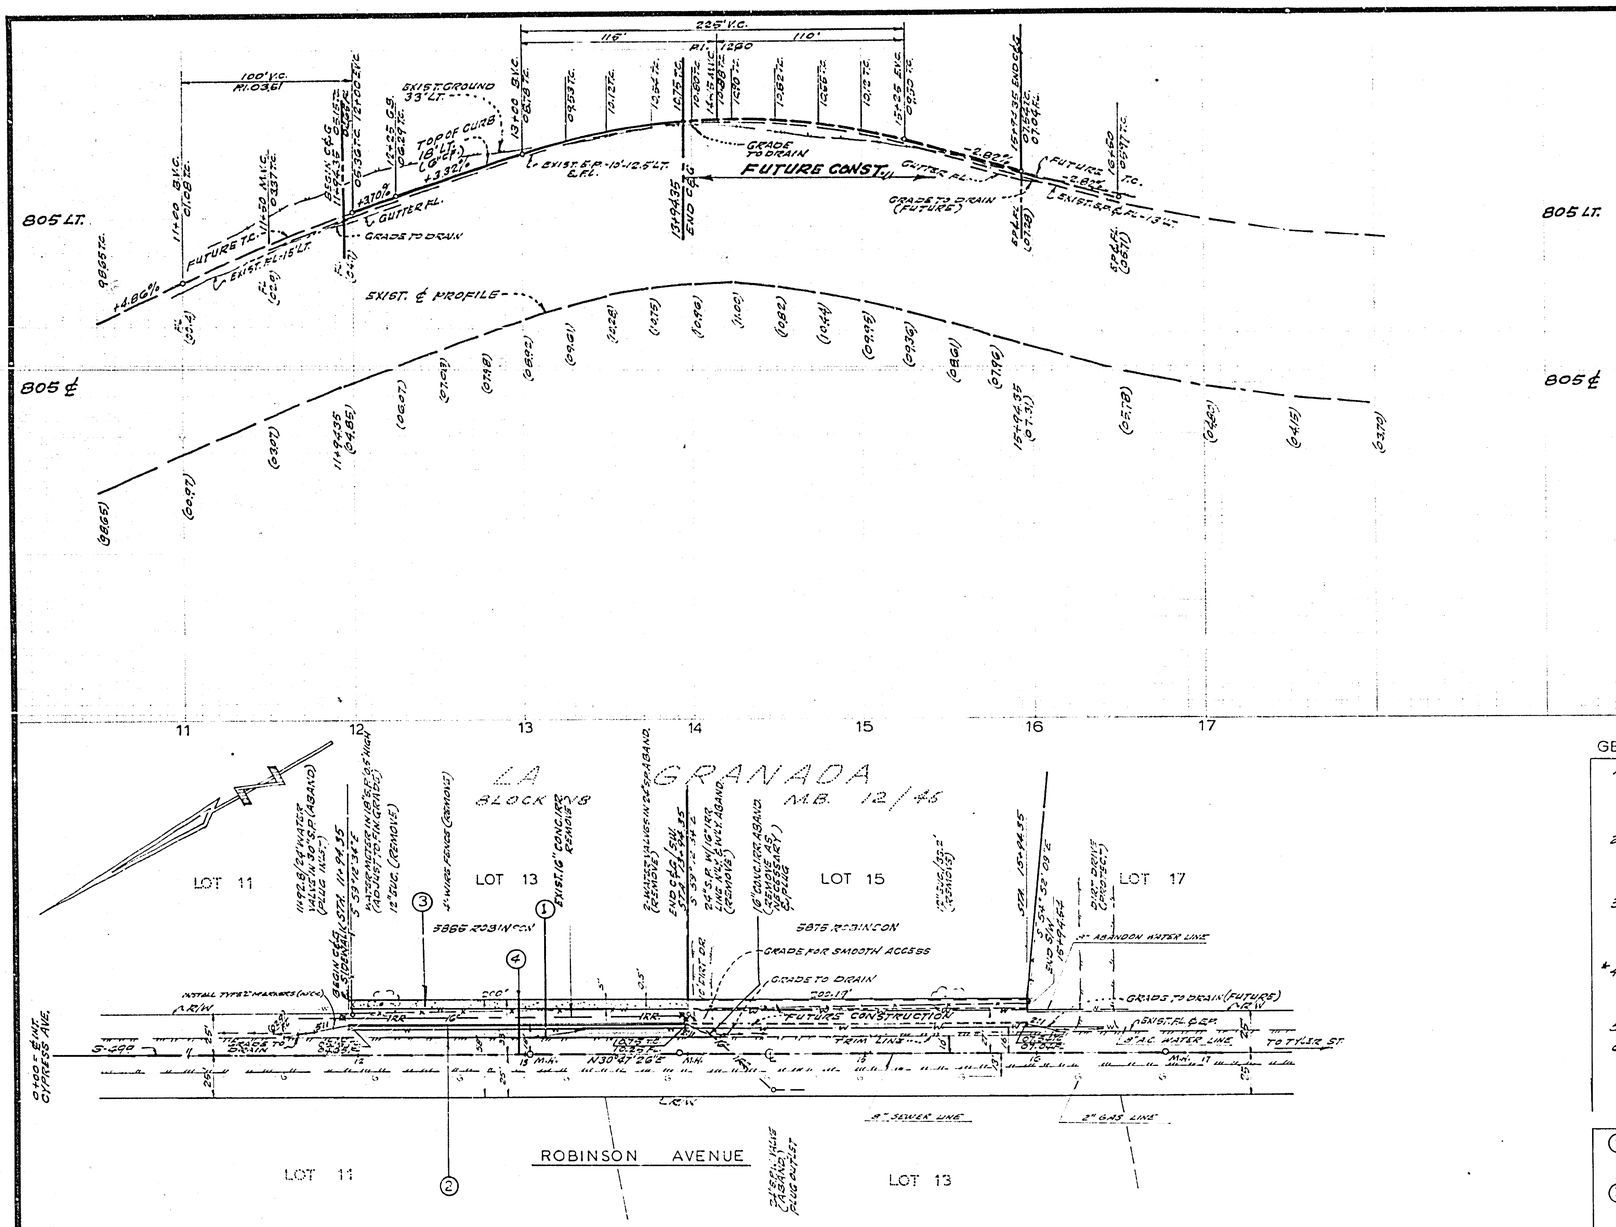

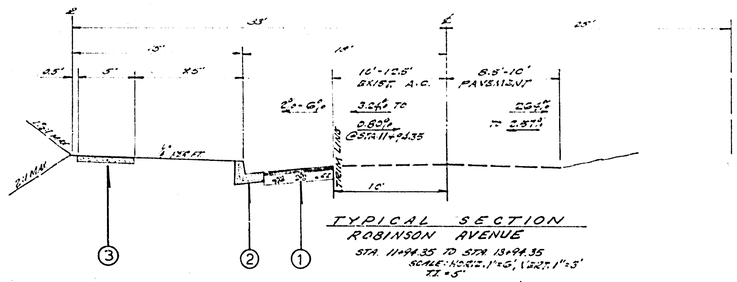

GENERAL NOTES

1. IT SHALL BE THE RESPONSIBILITY OF THE CONTRACTOR TO CLEAR THE RIGHT OF WAY IN ACCORDANCE WITH THE PROVISIONS OF LAW AS IT AFFECTS EACH UTILITY INCLUDING IRRIGATION LINES AND APPURTENANCES AND AT NO COST TO THE CITY.
2. CONSTRUCTION SHALL BE IN ACCORDANCE WITH THE CITY OF RIVERSIDE, DEPARTMENT OF PUBLIC WORKS STANDARD DRAWINGS AND PER STANDARD SPECIFICATION FOR PUBLIC WORKS CONSTRUCTION, 1973.
3. TRIM EDGE OF EXISTING PAVEMENT WHERE NEW PAVING JOINS EXISTING PAVEMENT, TO A CLEAN STRAIGHT LINE. CONSTRUCT MATCH-UP PAVING, AS SHOWN AND OVERLAY AS DIRECTED IN THE FIELD TO PRODUCE A SMOOTH CROWN SECTION.
4. *DRIVEWAY LOCATIONS TO BE DETERMINED AT THE TIME OF CONSTRUCTION AND CONSTRUCTION SHALL BE IN ACCORDANCE WITH THE TRAFFIC ENGINEER AND STANDARD DRAWING 302.
5. CURB TO BE STAKED WITH 3' OFF-SET AT 25' INTERVALS.
6. THE DEVELOPER SHALL ARRANGE FOR A SOIL TEST AT SUB-GRADE LEVEL BY A SOILS ENGINEER. THICKNESS OF PAVEMENT AND TYPE OF AGGREGATE BASE SHALL BE DETERMINED BY SOILS ENGINEER AND SUBMITTED TO THE CITY OF RIVERSIDE FOR APPROVAL PRIOR TO CONSTRUCTION.

CONSTRUCTION NOTES

1. CONST. 2½" A.C. OVER 8" D.G. OR 6" A.C. OVER COMPACTED NATIVE. △
2. CONST. TYPE I CURB & GUTTER (6" C.F.) PER STD. No 200.
3. CONST. PROPERTY LINE SIDEWALK PER STD. No 325.
4. CONST. 4" V.C.P. SEWER LATERAL PER STD. NO. 562, LOCATIONS TO BE DETERMINED BY OWNER.

Contractor agrees that he shall assume sole and complete responsibility for job site conditions during the course of construction of this Project, including safety of all persons and property; that this requirement shall apply continuously and not be limited to normal working hours; and that the Contractor shall defend, indemnify and hold the Owner and the Engineer harmless from any and all liability, real or alleged, in connection with the performance of work on this Project, excepting for liability arising from the sole negligence of the Owner or the Engineer.

*as built C.J.K. 3/75

S.R. 838
R-23

BENCHMARK: G2-F
P.K. NAIL & TAG IN CTR. OF NW CURB RET. @ TYLER ST. AND CAMPBELL AVE. R8.739/60 ELEV. 780.144

IRRIGATION LINE APPROVAL
APPROVED BY
William F. Montigel
ARLINGTON MUTUAL WATER CO. DATE 3-6-74

HAWKINS, ROBERTSON & ASSOC.
Engineers & Surveyors
Riverside California
Dale G. Gladden 1-18-74
R.C.E. NO. 17055 Date

MARK	REVISIONS	APPR.	DATE
△	ADDED STRUCTURAL SECTION PER SOILS TEST		

DESIGNED BY G.H. DRAWN BY G.H. CHECKED BY

CITY OF RIVERSIDE, CALIFORNIA
DEPARTMENT OF PUBLIC WORKS

APPROVED BY	BY	DATE
OFFICE ENGINEER		3/8
PARK DEPARTMENT		3-7
TRAFFIC DIVISION		3-7
ASSISTANT CITY ENG.		3-26

APPROVED BY
DIRECTOR OF PUBLIC WORKS
DATE 9-16-74

STREET PLAN & PROFILE
ROBINSON AVENUE
NORTHEASTERLY SIDE
FROM 1194.35' TO 1394.35' S'LY. ℄ OF CYPRESS AVE.
BUILDING PERMIT 5885 ROBINSON AVE.
HORIZ. SCALE: 1" = 40' VERT. SCALE: 1" = 4'

PROJECT NO. R-1739
SHEET 1 OF 1
FILE NO. 74-2441