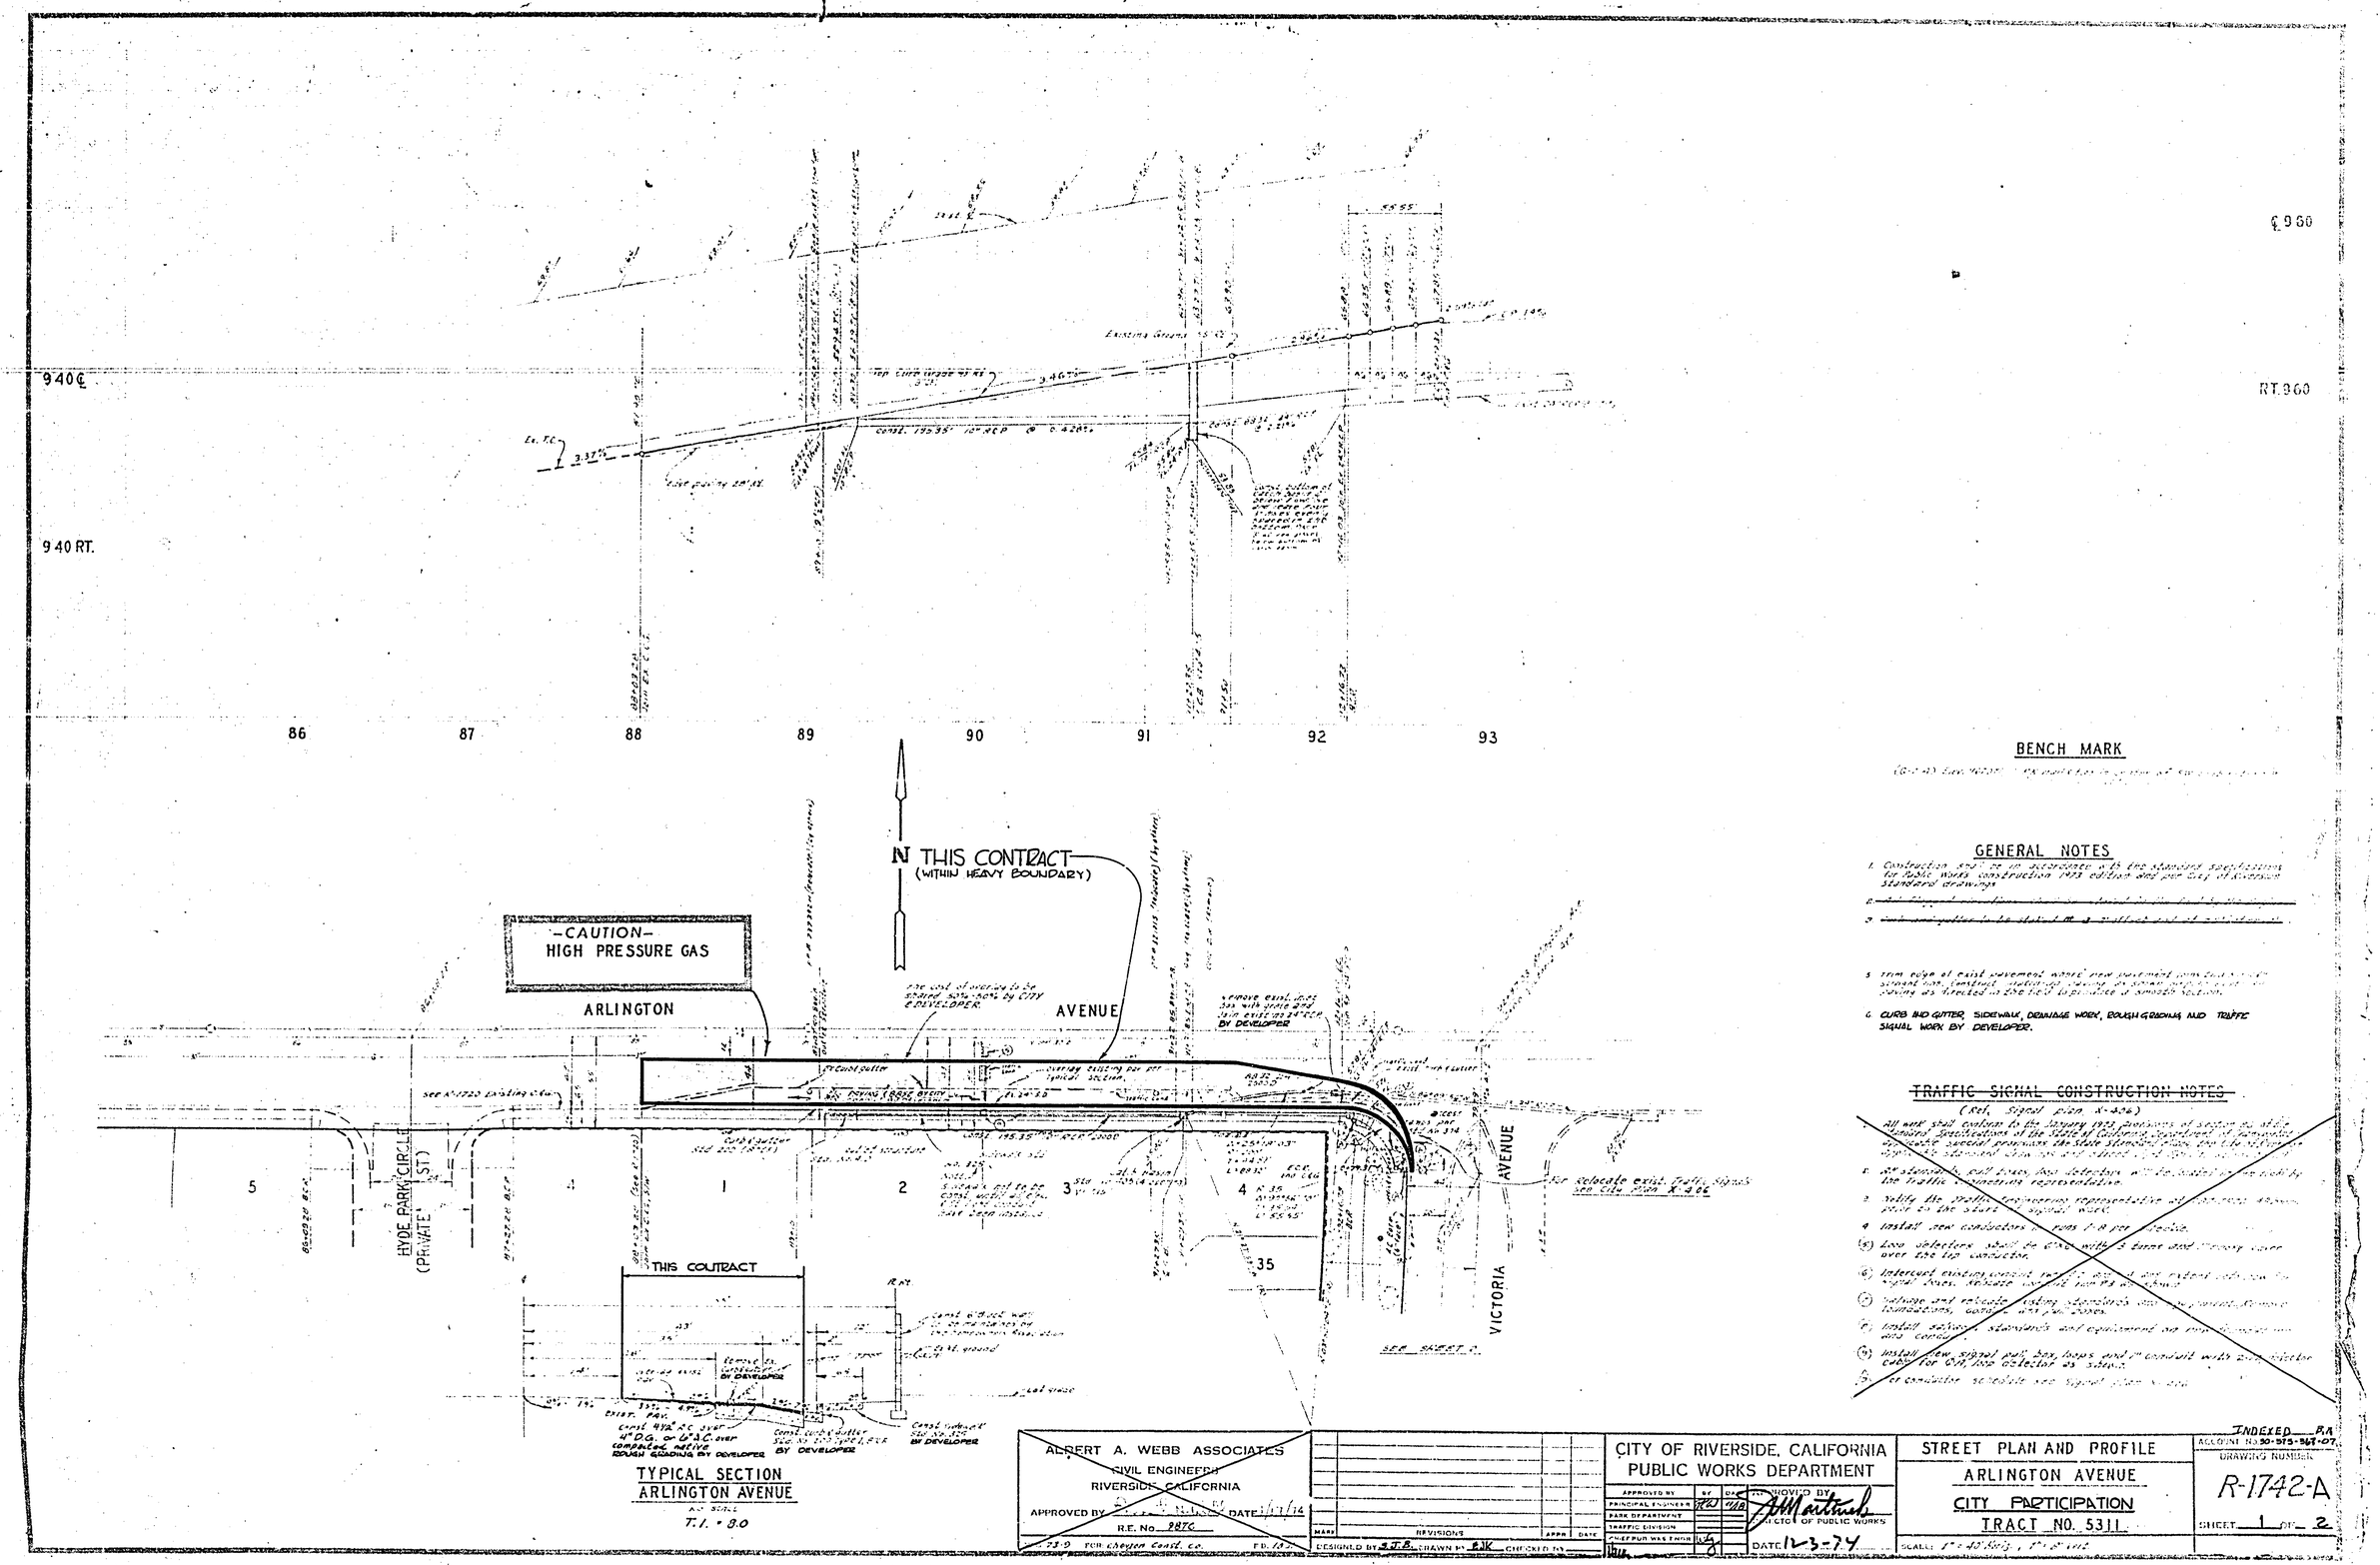

ADAPTED FROM PLAN NO. R-1742

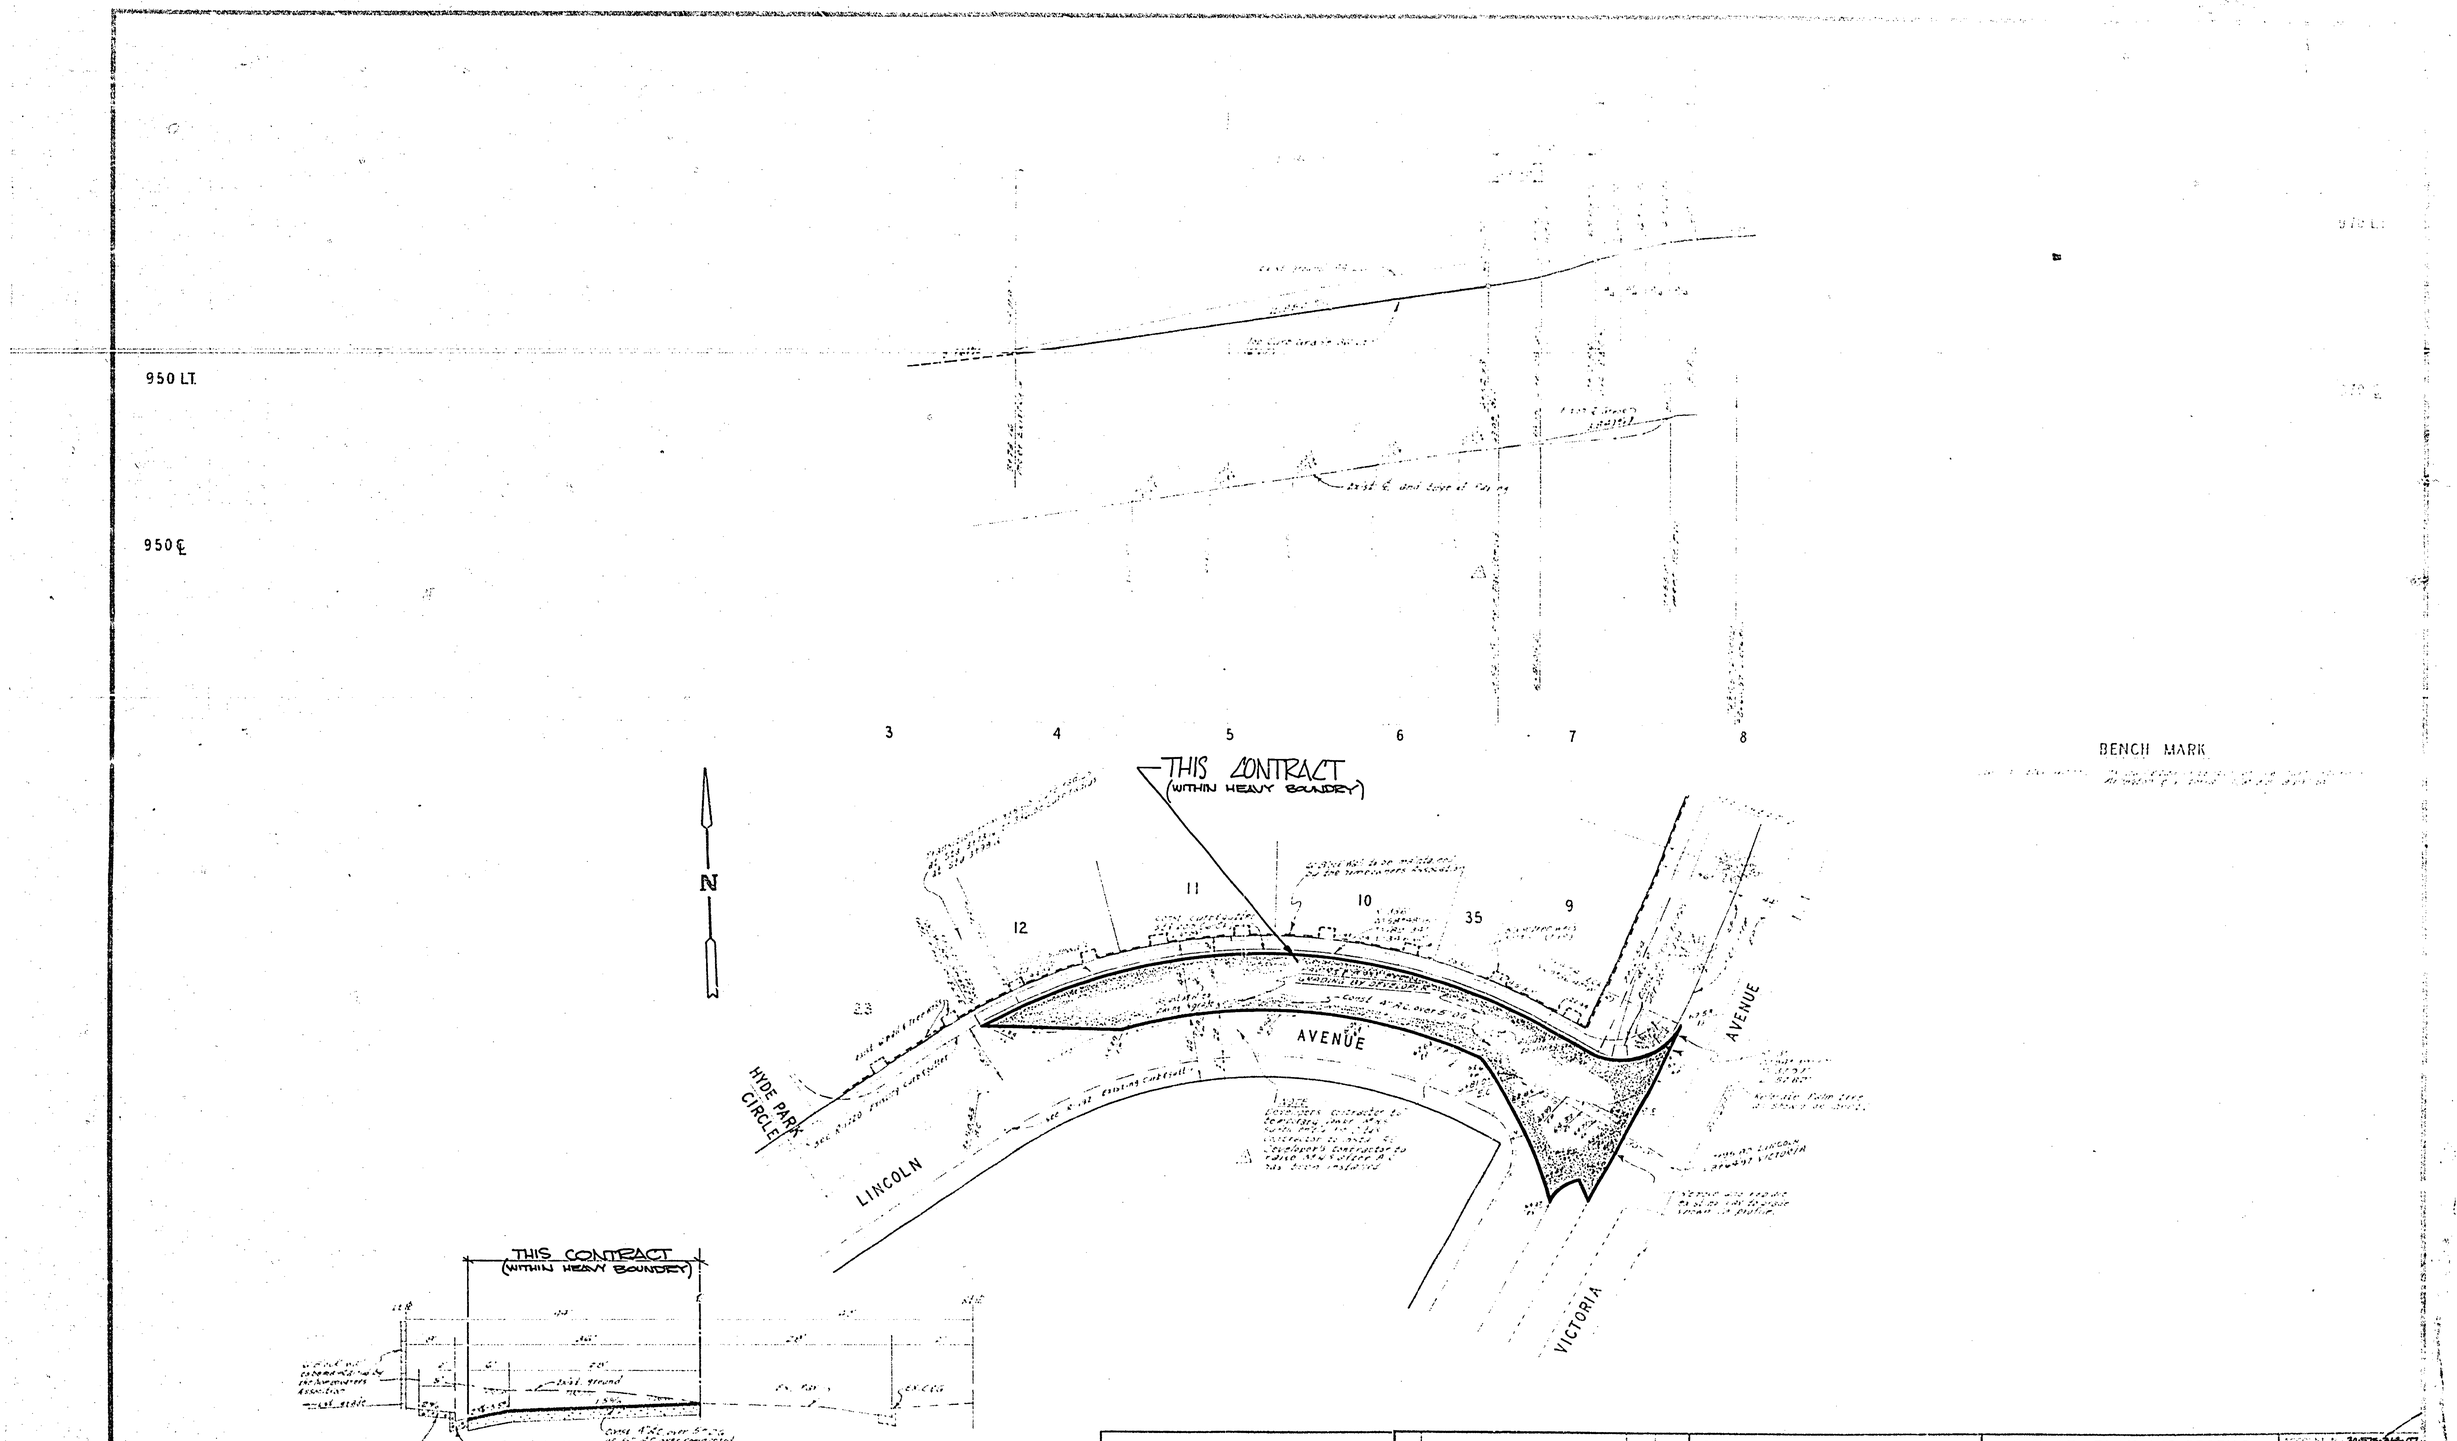

TYPICAL SECTION
LINCOLN AVENUE
NO SCALE

ALBERT A. WEBB ASSOCIATES CIVIL ENGINEERS RIVERSIDE, CALIFORNIA APPROVED BY [signature] DATE 9/16/76 R.E. No. 2876 W.O. 73-9 FOR: Chevron Const. Co. F.B. 1431	REVISIONS DESIGNED BY SFL DRAWN BY JEL CHECKED BY RA	CITY OF RIVERSIDE, CALIFORNIA PUBLIC WORKS DEPARTMENT APPROVED BY PRINCIPAL ENGINEER PARK DEPARTMENT TRAFFIC DIVISION DIVISION WAS ENGINEER APPROVED BY [signature] DIRECTOR OF PUBLIC WORKS DATE 1-27-76	STREET PLAN AND PROFILE LINCOLN AVENUE CITY PARTICIPATION TRACT NO. 5311 SCALE 1"=40' HOR. 1"=4' VERT.

ACCOUNT NO. 30-575-565-07
DRAWING NUMBER
R-1742A
SHEET 2 OF 2
73-9-A

ADAPTED FROM PLAN R-1742