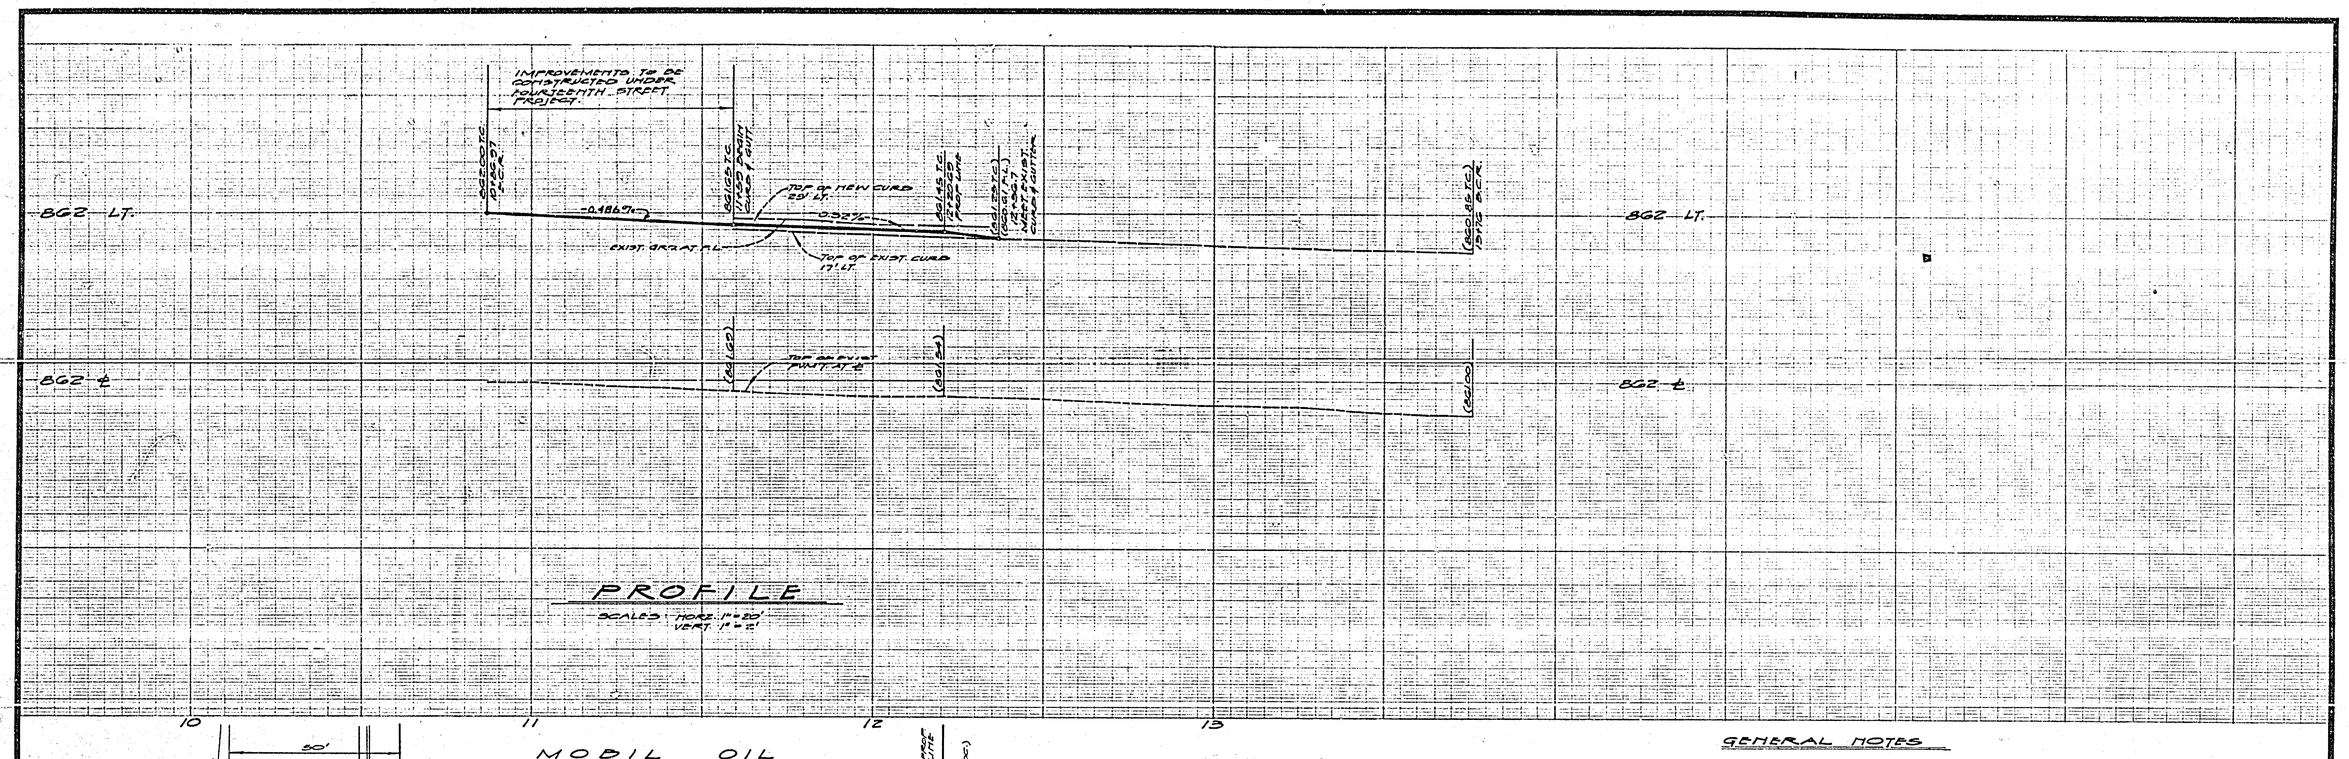

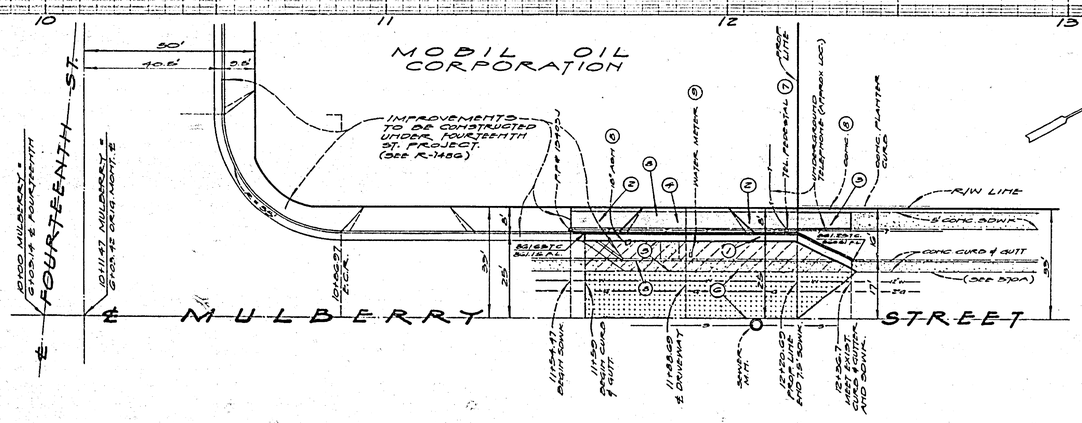

WARNING

NOTIFY PACIFIC TELEPHONE CO. AT 714-684-0071 BEFORE BEGINNING ANY EXCAVATION OR REMOVAL ON THIS PROJECT.

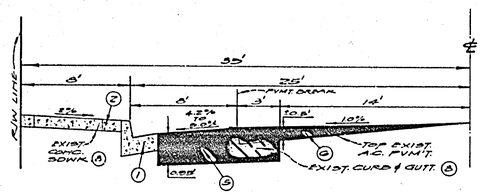

TYPICAL SECTION
MULBERRY STREET

SCALES: HORIZ. 1"=5'
VERT. 1"=2'

CONSTRUCTION NOTES - WORK TO BE PERFORMED BY MOBIL'S CONTRACTOR.

1. CONSTRUCT TYPE I CURB & GUTTER WITH 6" C.P. PER CITY OF R/V. STD. DRWG. NO. 200. PLACE 2 RONS OF #3 STEEL REINFORCING BARS IN GUTTER.
2. CONSTRUCT FULL PARKWAY (7.5 FT. WIDE) P.C.C. SIDEWALK PER CITY OF R/V. STD. DRWG. NO. 325.
3. CONSTRUCT 5 FT. WIDE P.C.C. SIDEWALK PER CITY OF R/V. STD. DRWG. NO. 325.
4. CONSTRUCT TYPE IV DRIVEWAY APPROACH, A=25' & D=35', PER CITY OF R/V. STD. DRWG. NO. 302.
5. PLACE 0.35 FT. COMPACTED THICKNESS OF ASPHALTIC CONCRETE OVER COMPACTED NATIVE MATERIAL.
6. PLACE OVERLAY OF VARIABLE THICKNESS OF ASPHALTIC CONCRETE OVER EXIST. PAVEMENT.
7. RELOCATE PEDESTAL AS DIRECTED BY PACIFIC TELEPHONE CO.
8. REMOVE EXISTING IMPROVEMENTS OR ITEMS AND DISPOSE OF FROM SITE.
9. CONTRACTOR TO MAKE FINANCIAL ARRANGEMENTS WITH CITY FOR REMOVAL BY CITY FORCES.

GENERAL NOTES

1. IT SHALL BE THE RESPONSIBILITY OF THE CONTRACTOR TO CLEAR THE RIGHT OF WAY IN ACCORDANCE WITH THE PROVISIONS OF LAW AS IT AFFECTS EACH UTILITY, INCLUDING IRRIGATION LINES AND APPURTENANCES, AND AT NO COST TO THE CITY.
2. CONSTRUCTION SHALL BE IN ACCORDANCE WITH THE CITY OF RIVERSIDE, DEPARTMENT OF PUBLIC WORKS, STANDARD DRAWINGS AND THE STANDARD SPECIFICATIONS FOR PUBLIC WORKS CONSTRUCTION, 1973 EDITION.
3. TRIM EDGE OF EXISTING PAVEMENT WHERE NEW PAVEMENT JOINS TO A SMOOTH STRAIGHT LINE. CONSTRUCT MATCH-UP PAVING AS SHOWN ON PLAN AND OVERLAY PAVING AS DIRECTED IN THE FIELD TO PRODUCE A SMOOTH SECTION.
4. CURB AND GUTTER SHALL BE STAKED WITH 5 FT. OFFSETS AT 12.5 FT. INTERVALS.
5. THE CONTRACTOR SHALL BE RESPONSIBLE FOR LOCATING AND PROTECTING ALL UTILITY LINES AND FACILITIES SHOWN OR NOT SHOWN ON THIS PLAN.
6. CONSTRUCTION SHALL BE DONE CONCURRENTLY WITH OR AFTER THE MULBERRY ST. WIDENING PORTION OF THE 14TH ST. UNDERPASS PROJECT.

BENCH MARK

P.K. NAIL IN CENTER OF S.W. CURB RETURN AT OLIVEWOOD & 14TH STS. PER C.R.P.D. 558/30. ELEV. 856.935.

*AS BUILT · 8-76 KPT

PREPARED BY:
J. RONALD WHITE & ASSOCIATES
558 W. 4TH ST., SUITE 202
P.O. BOX 1187
SAN BERNARDINO, CA. 92402. PH. 888-6711
R.C.E. 14562

MARK	REVISIONS	APPR.	DATE

DESIGNED BY ____ DRAWN BY ____ CHECKED BY ____

CITY OF RIVERSIDE, CALIFORNIA
DEPARTMENT OF PUBLIC WORKS

APPROVED BY	BY	DATE
OFFICE ENGINEER		
PARK DEPARTMENT		
TRAFFIC DIVISION		
ASSISTANT CITY ENG.		

APPROVED BY
DIRECTOR OF PUBLIC WORKS
DATE 5-15-74

MULBERRY STREET

STREET IMPROVEMENTS ON W'LY. SIDE, FROM 154' TO 237' N.E'LY OF 14TH ST.
ZONING CASE R-12-734

HORIZ. SCALE: 1" - 20' VERT. SCALE: 1" - 2'

PROJECT NO. R-1745
SHEET 1 OF 1
FILE NO.