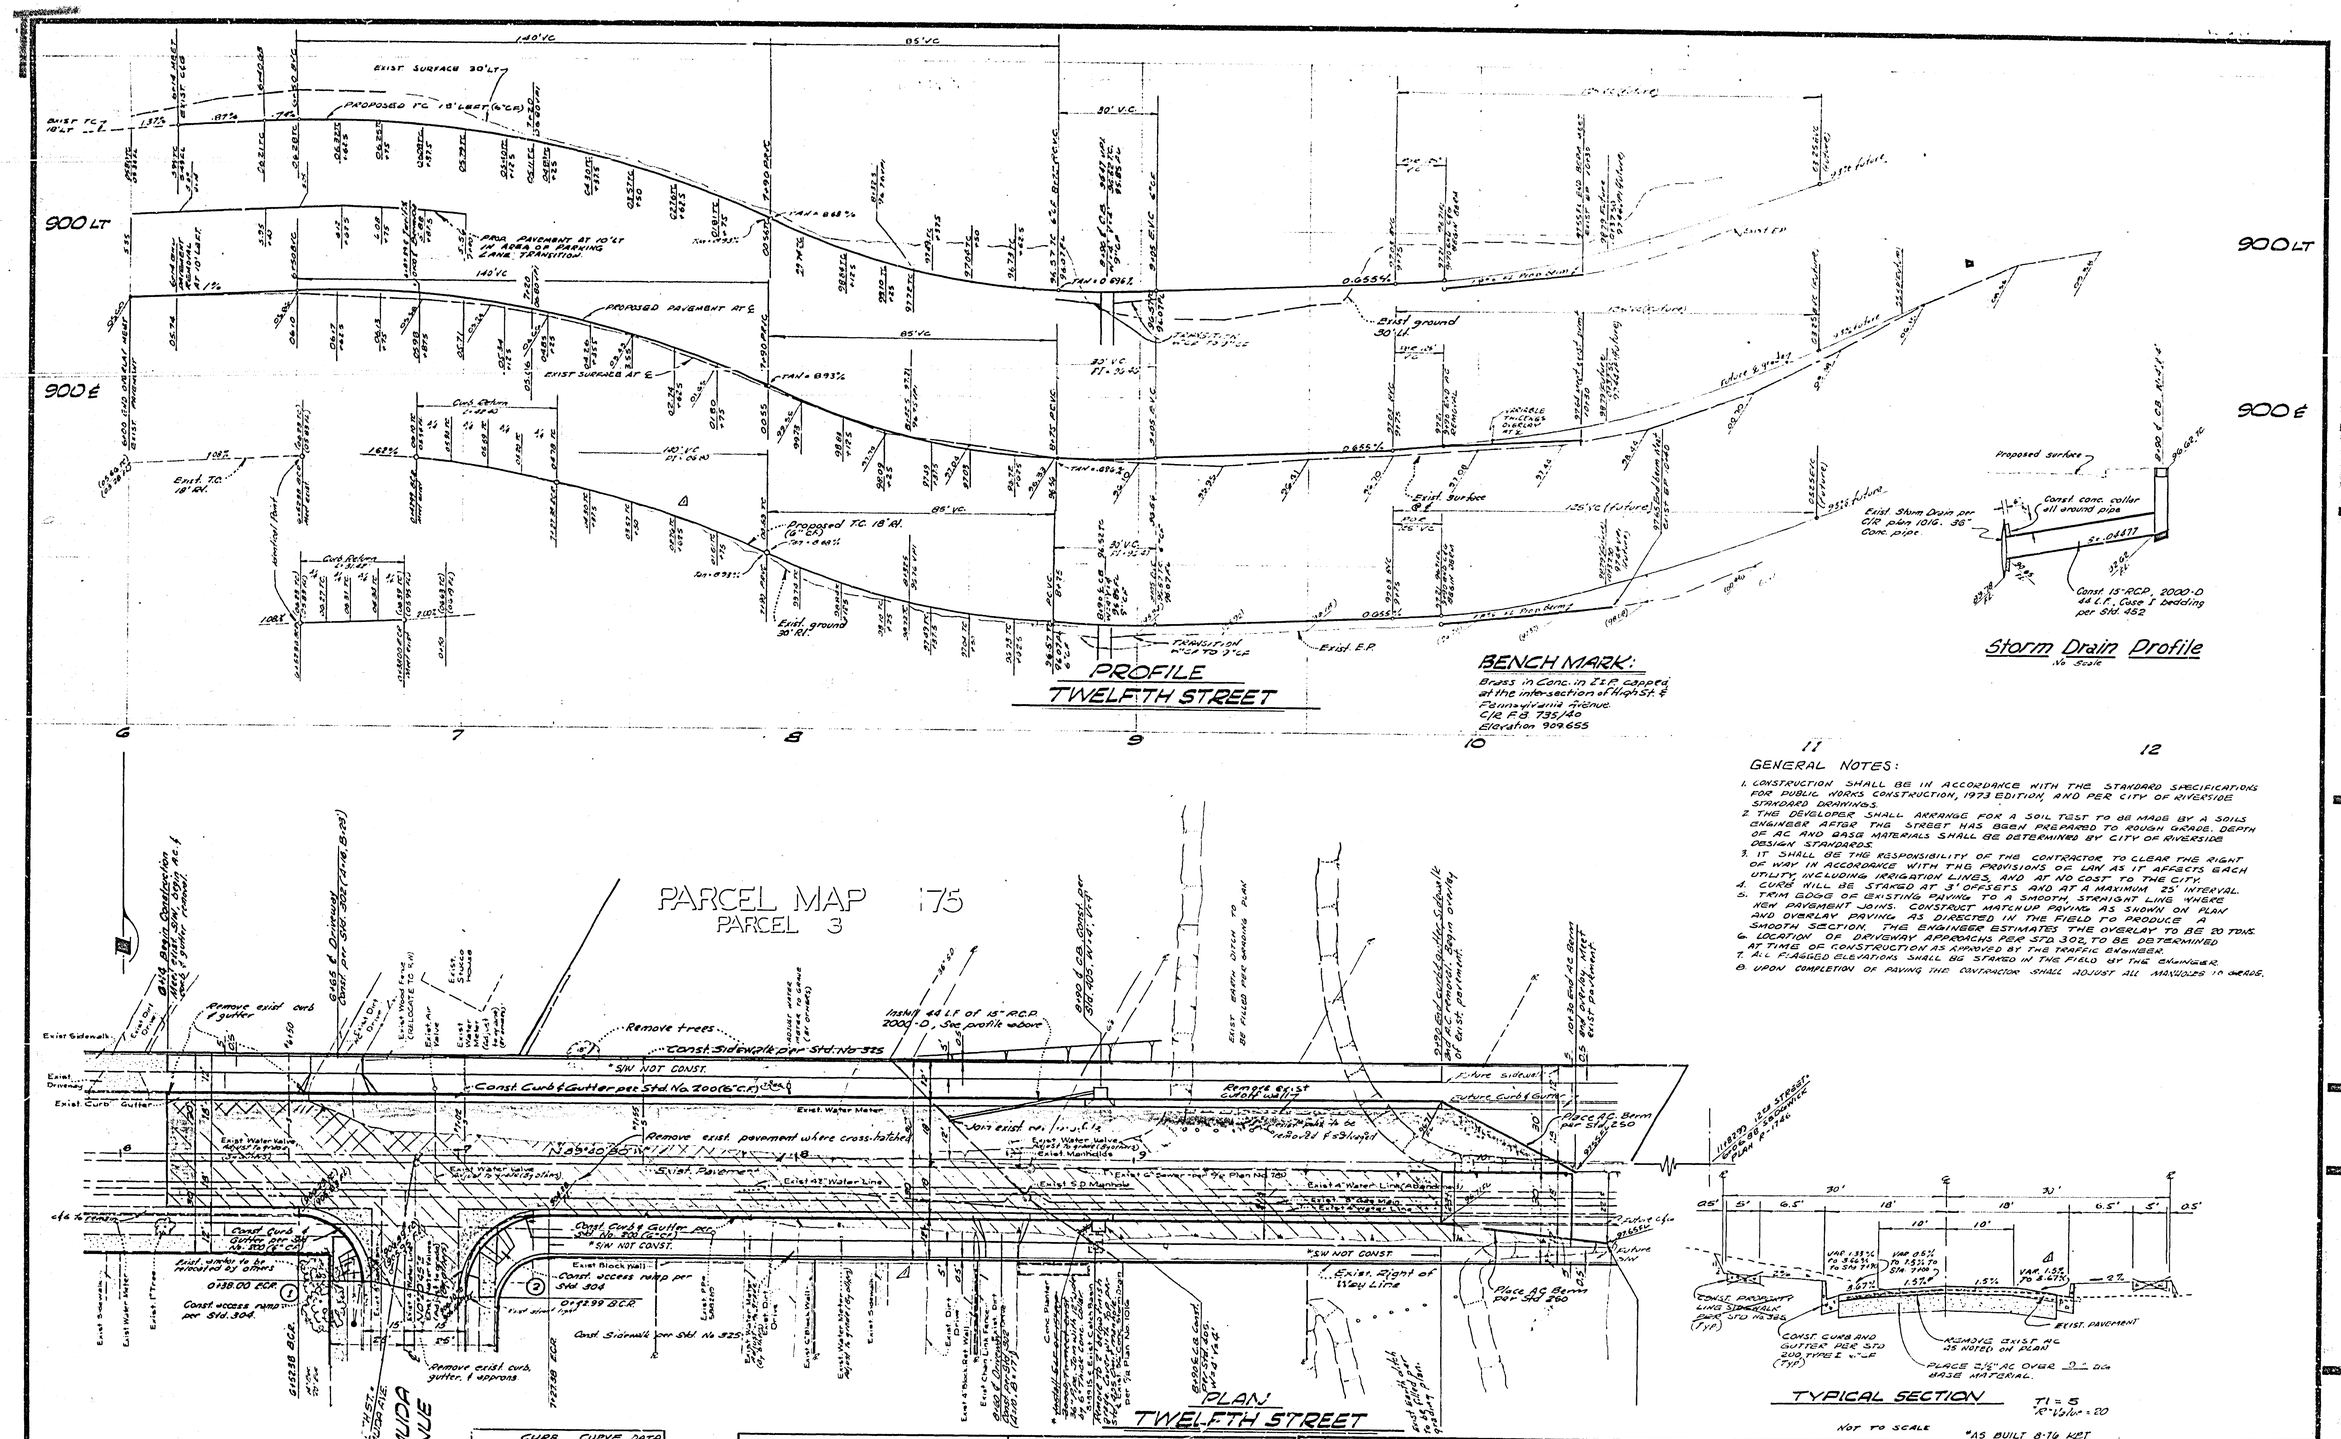

GENERAL NOTES:

1. CONSTRUCTION SHALL BE IN ACCORDANCE WITH THE STANDARD SPECIFICATIONS FOR PUBLIC WORKS CONSTRUCTION, 1973 EDITION, AND PER CITY OF RIVERSIDE STANDARD DRAWINGS.
2. THE DEVELOPER SHALL ARRANGE FOR A SOIL TEST TO BE MADE BY A SOILS ENGINEER AFTER THE STREET HAS BEEN PREPARED TO ROUGH GRADE. DEPTH OF AC AND BASE MATERIALS SHALL BE DETERMINED BY CITY OF RIVERSIDE DESIGN STANDARDS.
3. IT SHALL BE THE RESPONSIBILITY OF THE CONTRACTOR TO CLEAR THE RIGHT OF WAY IN ACCORDANCE WITH THE PROVISIONS OF LAW AS IT AFFECTS EACH UTILITY, INCLUDING IRRIGATION LINES, AND AT NO COST TO THE CITY.
4. CURB WILL BE STAKED AT 3' OFFSETS AND AT A MAXIMUM 25' INTERVAL.
5. TRIM EDGE OF EXISTING PAVING TO A SMOOTH, STRAIGHT LINE WHERE NEW PAVEMENT JOINS. CONSTRUCT MATCHUP PAVING AS SHOWN ON PLAN AND OVERLAY PAVING AS DIRECTED IN THE FIELD TO PRODUCE A SMOOTH SECTION. THE ENGINEER ESTIMATES THE OVERLAY TO BE 20 TONS.
6. LOCATION OF DRIVEWAY APPROACHS PER STD. 302, TO BE DETERMINED AT TIME OF CONSTRUCTION AS APPROVED BY THE TRAFFIC ENGINEER.
7. ALL FLAGGED ELEVATIONS SHALL BE STAKED IN THE FIELD BY THE ENGINEER.
8. UPON COMPLETION OF PAVING THE CONTRACTOR SHALL ADJUST ALL MANHOLES TO GRADE.

CURB CURVE DATA				
No.	Δ	R	L	T
1	90°01'15"	20'	31.42	20.01
2	89°58'45"	25'	39.26	24.99

REDEVELOPMENT AGENCY
APPROVAL FOR SCOPE & CONCEPT
APPROVED BY: [signature]
DATE [illegible]

ALBERT A. WEBB ASSOCIATES
CIVIL ENGINEERS
RIVERSIDE, CALIFORNIA
APPROVED BY [signature] DATE 5/9/74
R.E. No. 21884
W.O. 74-31 FOR: C. of R. REDEV. AGENCY F.B. 1013

MARK	REVISIONS	APPR.	DATE
1	General revision to plan & profile, added curb & gutter, to right side of street, etc.	[illegible]	12-12-75

DESIGNED BY P.H. BE DRAWN BY P.H. BE CHECKED BY [illegible]

CITY OF RIVERSIDE, CALIFORNIA
PUBLIC WORKS DEPARTMENT

APPROVED BY	BY	DATE
PRINCIPAL ENGINEER	[illegible]	[illegible]
PARK DEPARTMENT		
TRAFFIC DIVISION		
CHIEF PUB. WKS ENGR	[illegible]	6-5

APPROVED BY [signature]
DIRECTOR OF PUBLIC WORKS
DATE 6-5-74

STREET PLAN AND PROFILE
TWELFTH STREET
FROM BERMUDA AVE. TO 250' ± E'LS
NEIGHBORHOOD DEVELOPMENT PROGRAM No. 2
SCALE: HORIZ. 1"=20', VERT. 1"=4'

ACCOUNT No. 74-31
DRAWING NUMBER
R-1756
SHEET 1 OF 1
74-31