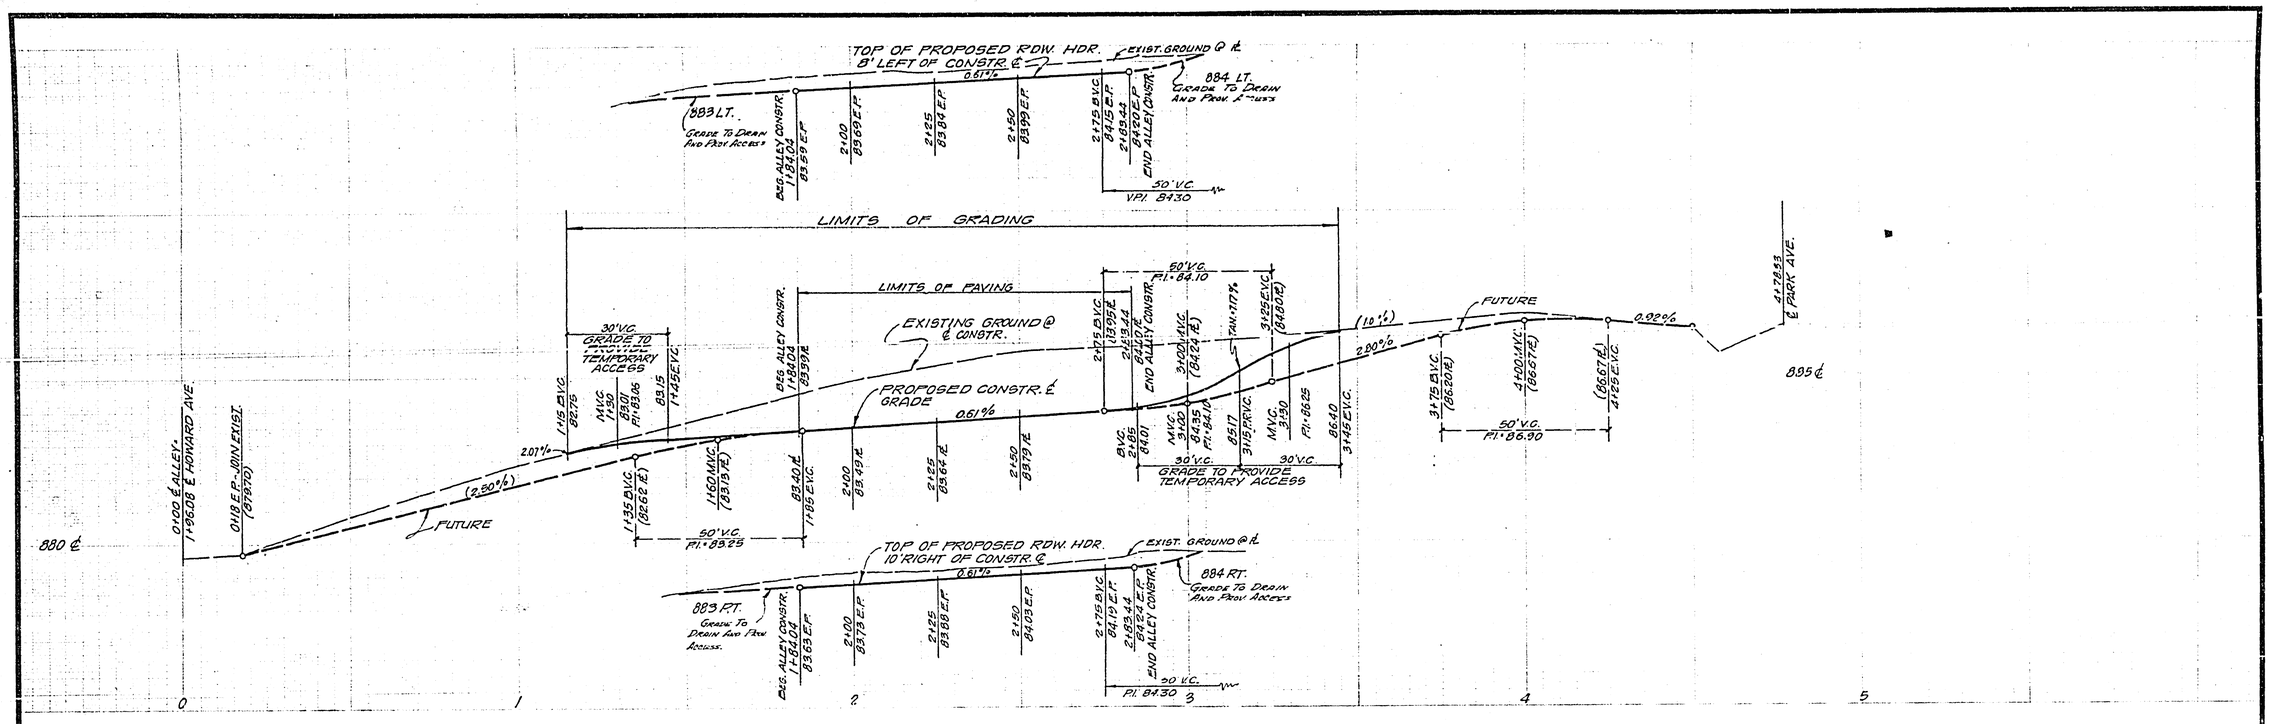

F.B. 968-28
ELEV. 878.83
B.M. PK. IN W'LY CURB HOWARD AVE. 130' N. OF ℄ 14th ST.

GENERAL NOTES:

1. It shall be the responsibility of the contractor to clear the right of way in accordance with the provisions of law as it affects each utility, including irrigation lines and appurtenances, and at no cost to the City.
2. Construction shall be in accordance with the City of Riverside, Department of Public Works, Standard Drawings and the Standard Specifications for Public Works Construction, 1973 Edition.
3. Prime coat, seal coat, and paint binder are required.
4. All flagged elevations shall be staked in the field by the Engineer.

Contractor agrees that he shall assume sole and complete responsibility for job site conditions during the course of construction of this Project, including safety of all persons and property; that this requirement shall apply continuously and not be limited to normal working hours; and that the Contractor shall defend, indemnify and hold the Owner and the Engineer harmless from any and all liability, real or alleged, in connection with the performance of work on this Project, excepting for liability arising from the sole negligence of the Owner or the Engineer.

* AS BUILT C.J.K. 5/76

S.R. 792 R=13

J. F. DAVIDSON ASSOCIATES
CIVIL ENGINEERS - SURVEYORS - PLANNERS
RIVERSIDE, CALIFORNIA
APPROVED BY Robert S. Lipper DATE 5-21-74
R.E. No. 13699
W.O. 4016 FOR: LEWIS WARE F.B.

MARK	REVISIONS	APPR.	DATE

DESIGNED BY DE DRAWN BY DE CHECKED BY DE

CITY OF RIVERSIDE, CALIFORNIA
DEPARTMENT OF PUBLIC WORKS

APPROVED BY	BY	DATE
OFFICE ENGINEER	[illegible]	6/3
PARK DEPARTMENT		
TRAFFIC DIVISION		
ASSISTANT CITY ENG.		

APPROVED BY [signature]
DIRECTOR OF PUBLIC WORKS
DATE 6-5-74

ALLEY
HOWARD AVE. TO PARK AVE.
196' ± NE'LY 14TH ST.
R-49-701

HORIZ. SCALE: 1" = 20' VERT. SCALE: 1" = 2'

PROJECT NO. R-1760
SHEET 1 OF 1
FILE NO. 4476