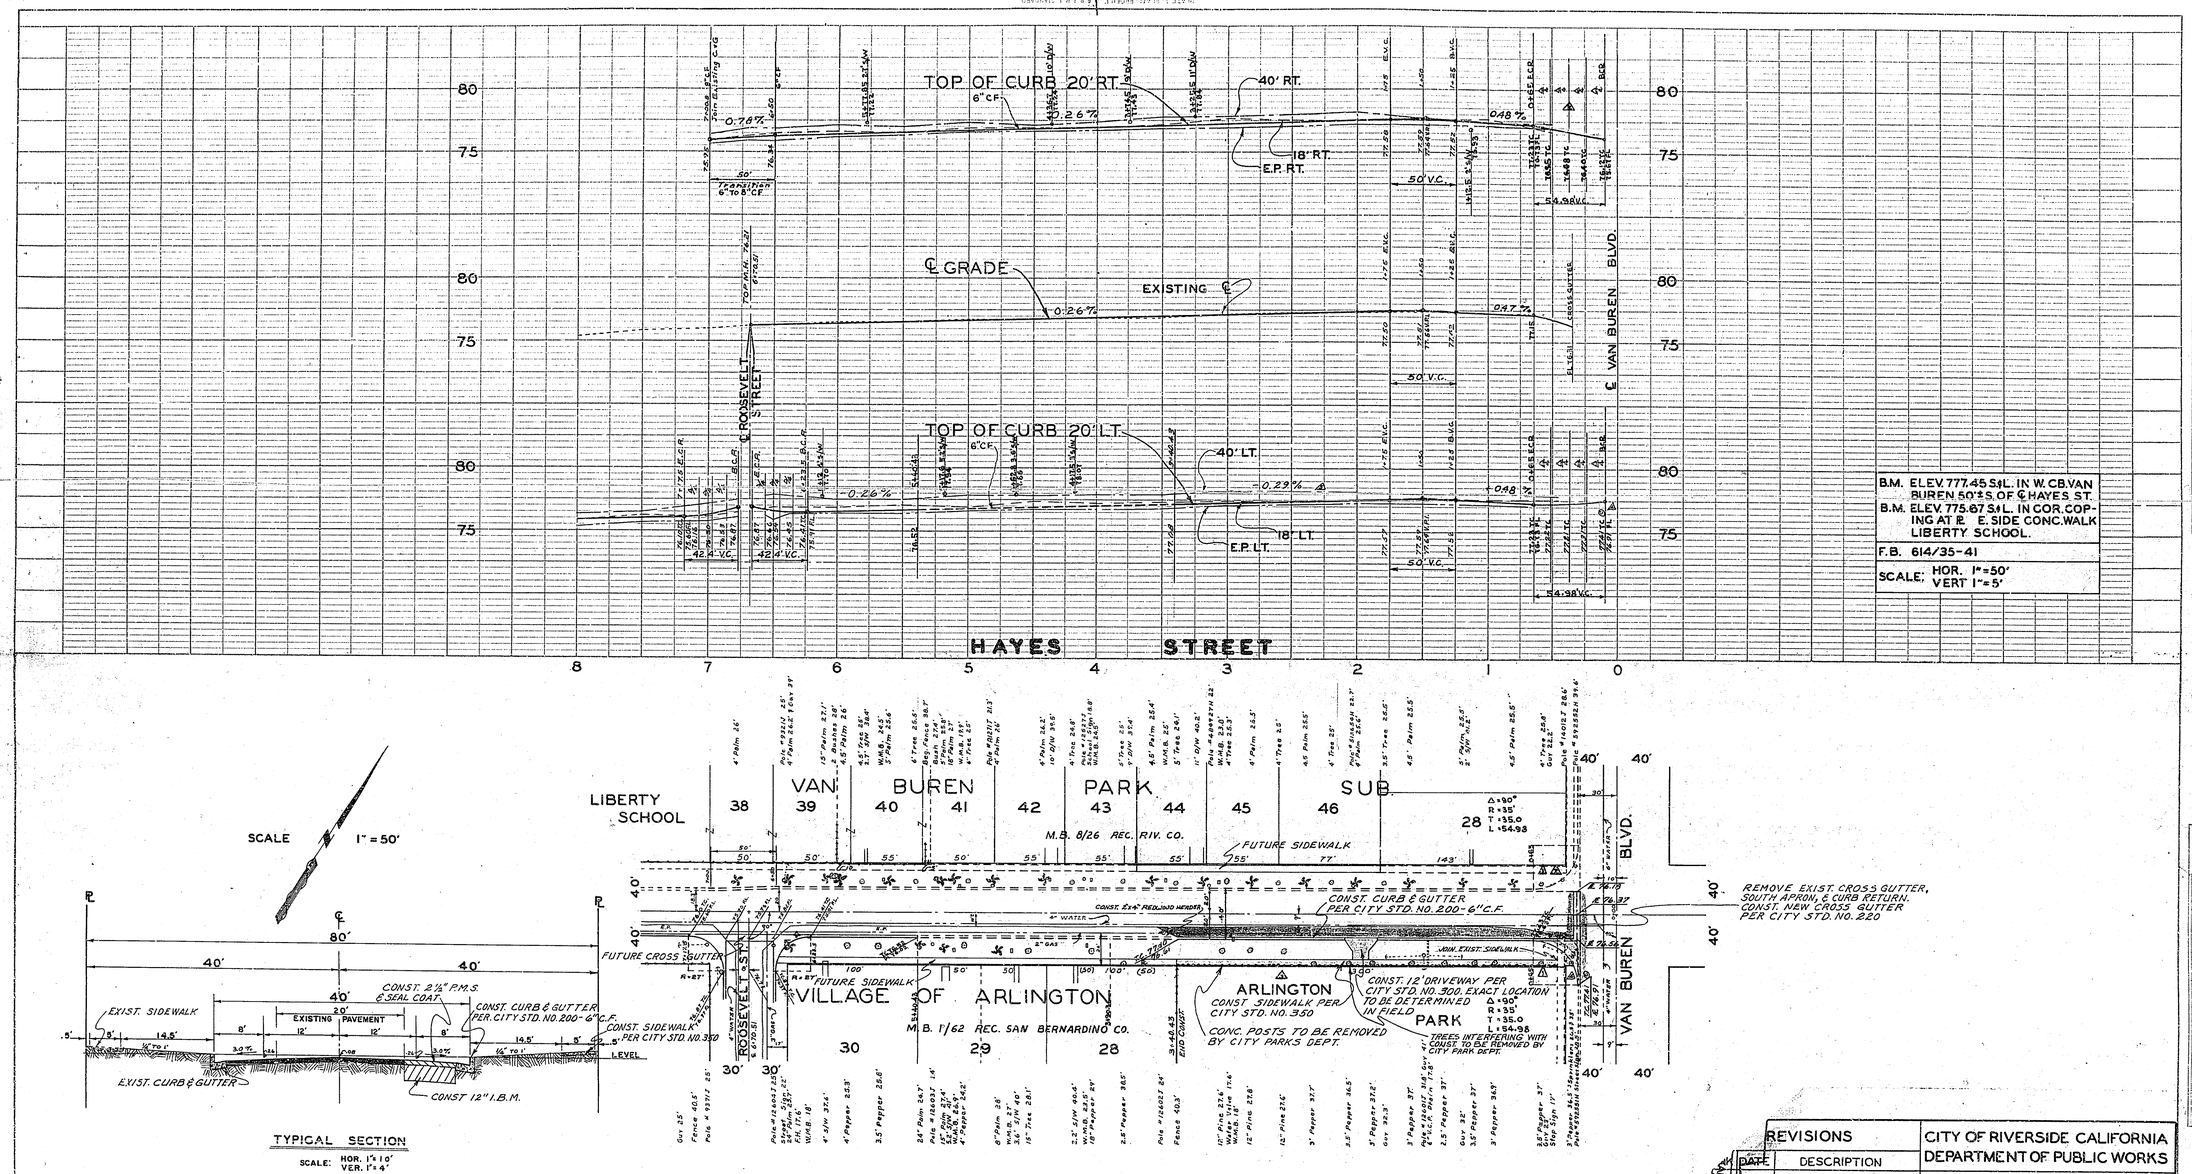

NOTE:
It shall be the responsibility of the Contractor to clear the right of way in accordance with the provisions of the law as it affects each utility including irrigation lines and appurtenances and at no extra cost to the City.

REVISIONS			
	DATE	DESCRIPTION	
4	5-21-58	REVISED CR RAD. TO 35'	AKJ
3	5-23-58	FIELD REVISION AS BUILT	AKJ
2	10-23-57	INDICATED IMPROVEMENT LIMITS FOR ARLINGTON PARK.	F.M.
1	12/17/59	REVISED C.R. ELEVATIONS	L.P.
1	12/17/59	REVISED CURB GRADE & ELEVS.	L.P.

CITY OF RIVERSIDE CALIFORNIA
DEPARTMENT OF PUBLIC WORKS

HAYES STREET IMPROVEMENT
CURB & GUTTER BET. VAN BUREN AND ROOSEVELT ST.

DESIGNED BY AKJ
CHECKED BY J.L.B.
DRAWN BY Boyd Low FM
RECOMMENDED BY Lewis F. Fulton ASSISTANT CITY ENGINEER
APPROVED BY Jon Mott DIRECTOR OF PUBLIC WORKS
DATE March 7, 1958

R-177

SHEET 1 OF 1

PROFILE
SUBMITTED
PLOTTED
NOTE BOOK
DATE CHECKED
NO.
B.M. & NO. NOTED
ERRORS OR OMISSIONS FOUND
BY
DATE

PLAN
SUBMITTED
PLOTTED
NOTE BOOK
DATE CHECKED
NO.
REF. OF WOT CHECKED
BY
DATE