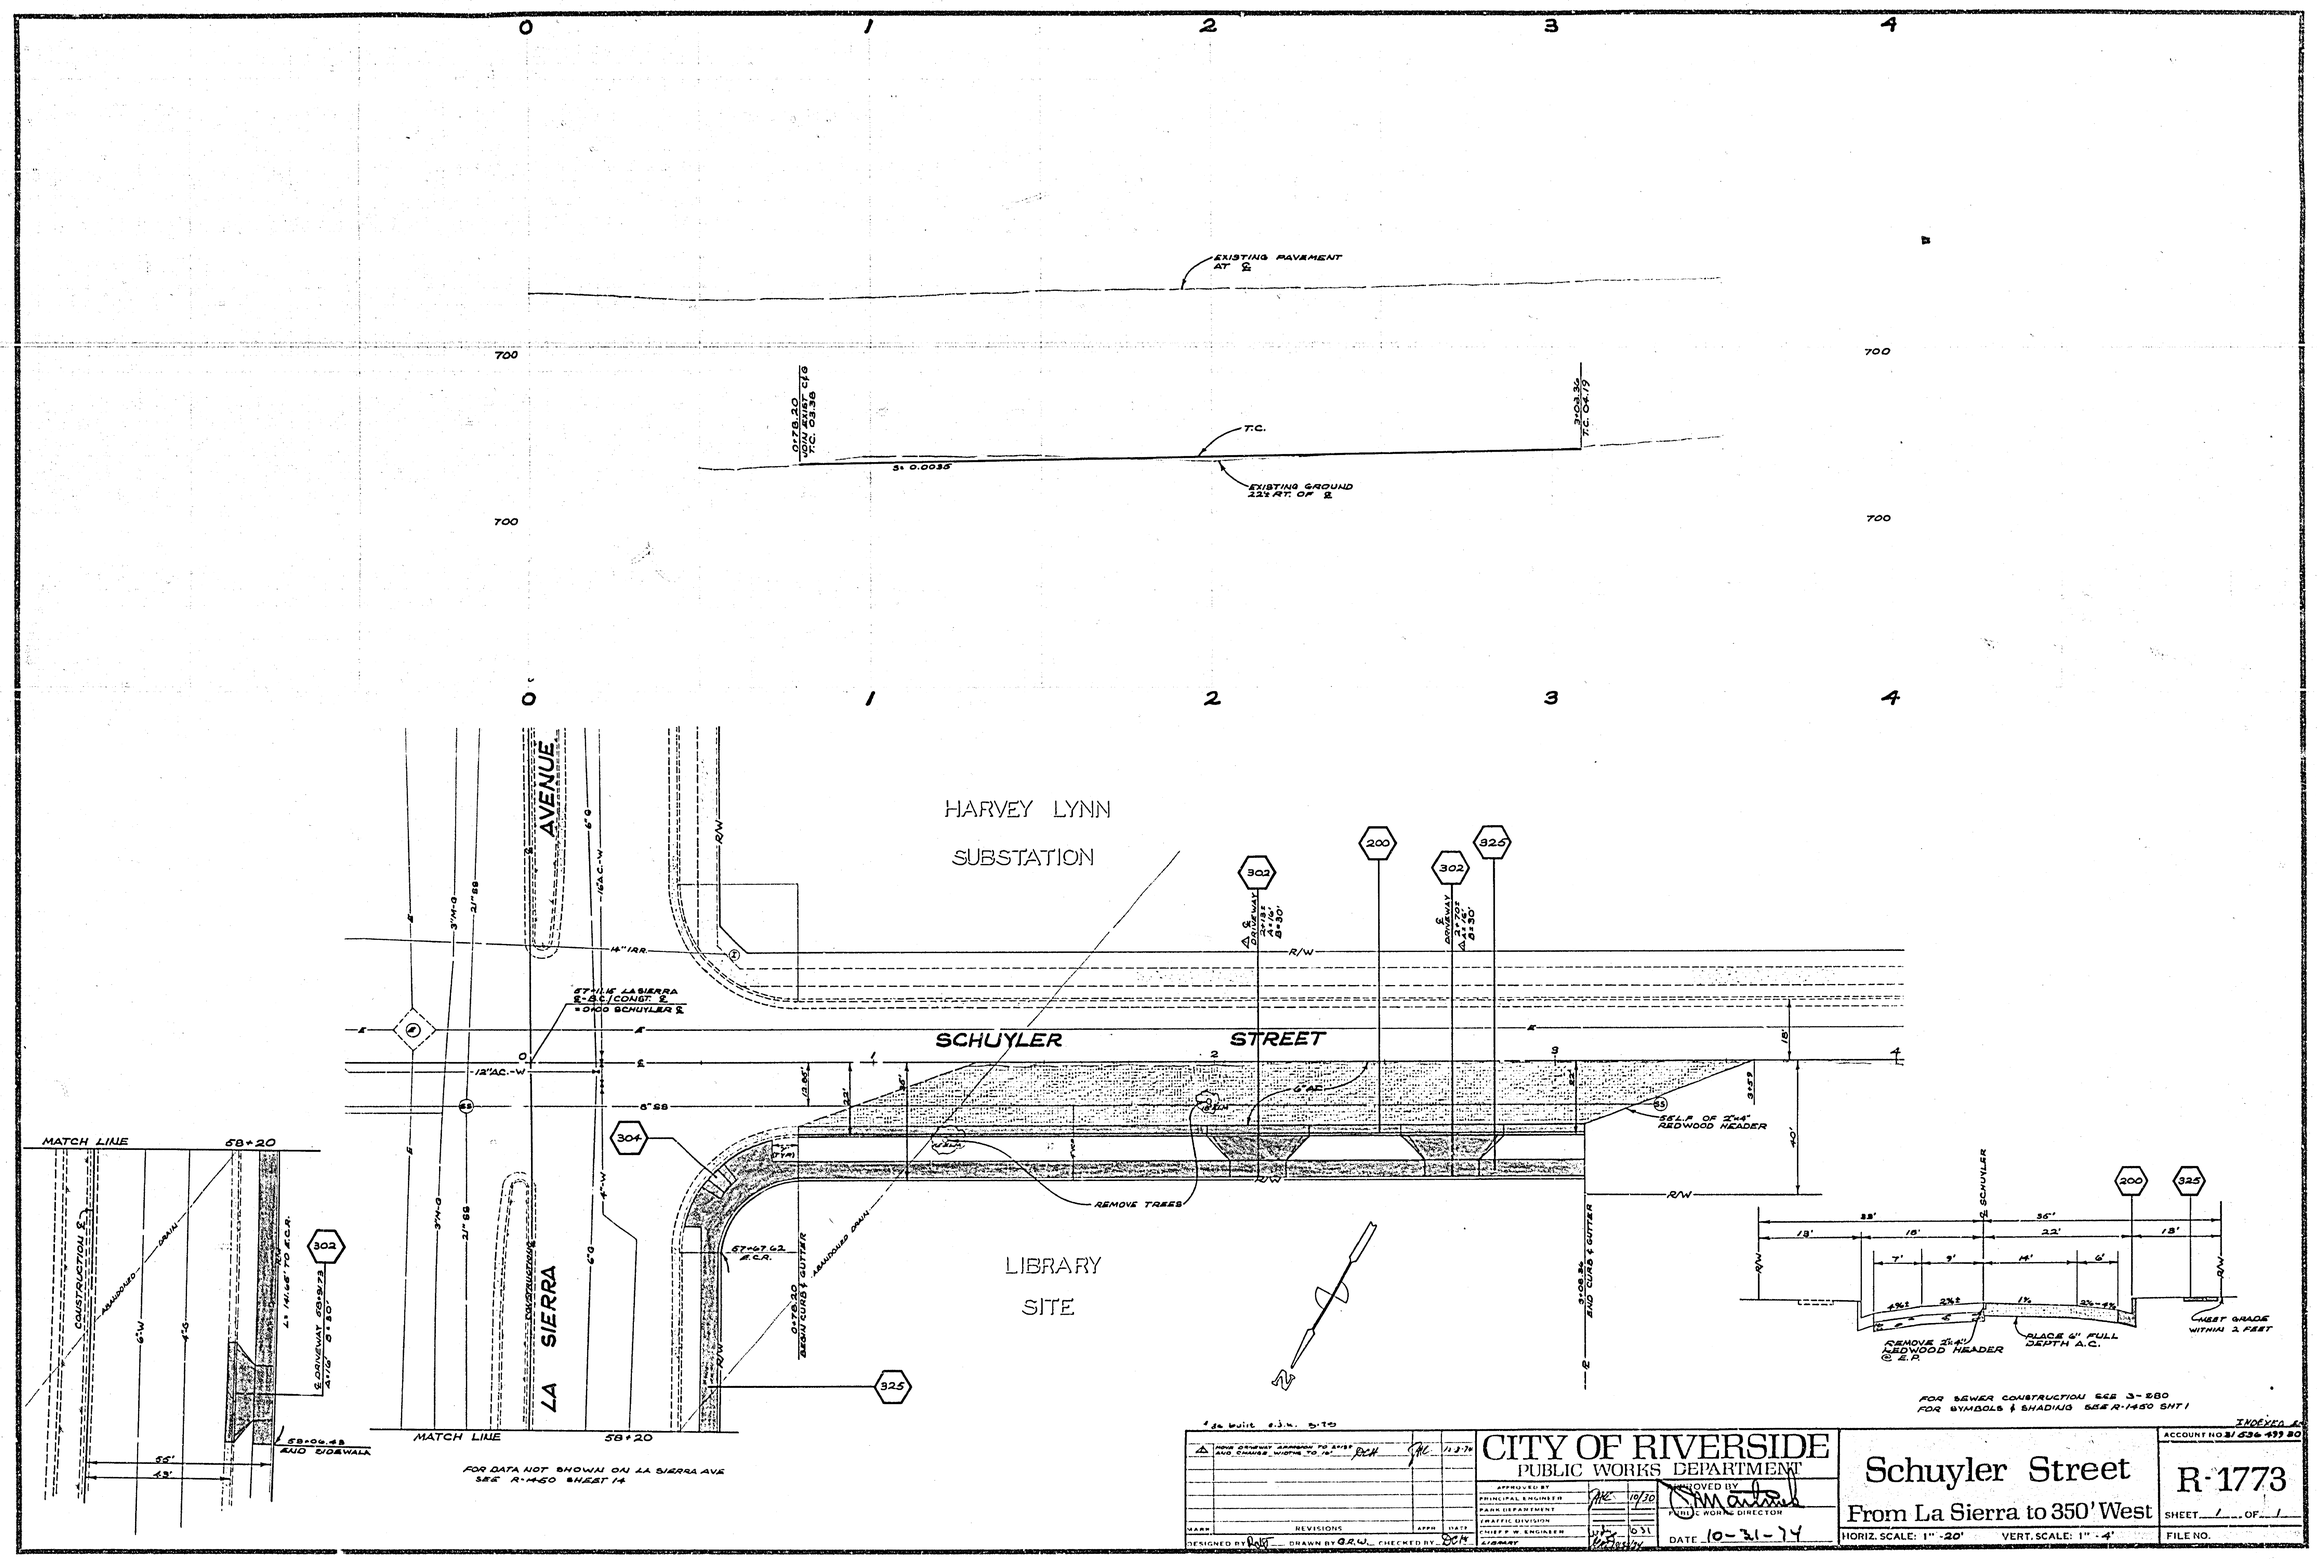

EXISTING PAVEMENT AT ℄
700
T.C.
EXISTING GROUND 22'± RT. OF ℄
S= 0.0035
HARVEY LYNN SUBSTATION
SCHUYLER STREET
LA SIERRA AVENUE
LIBRARY SITE
REMOVE TREES
MATCH LINE 58+20
FOR DATA NOT SHOWN ON LA SIERRA AVE SEE R-1450 SHEET 14
FOR SEWER CONSTRUCTION SEE 3-280
FOR SYMBOLS & SHADING SEE R-1450 SHT 1
CITY OF RIVERSIDE
PUBLIC WORKS DEPARTMENT
Schuyler Street
From La Sierra to 350' West
R-1773
SHEET 1 OF 1
HORIZ. SCALE: 1" -20'
VERT. SCALE: 1" -4'
DATE 10-31-74