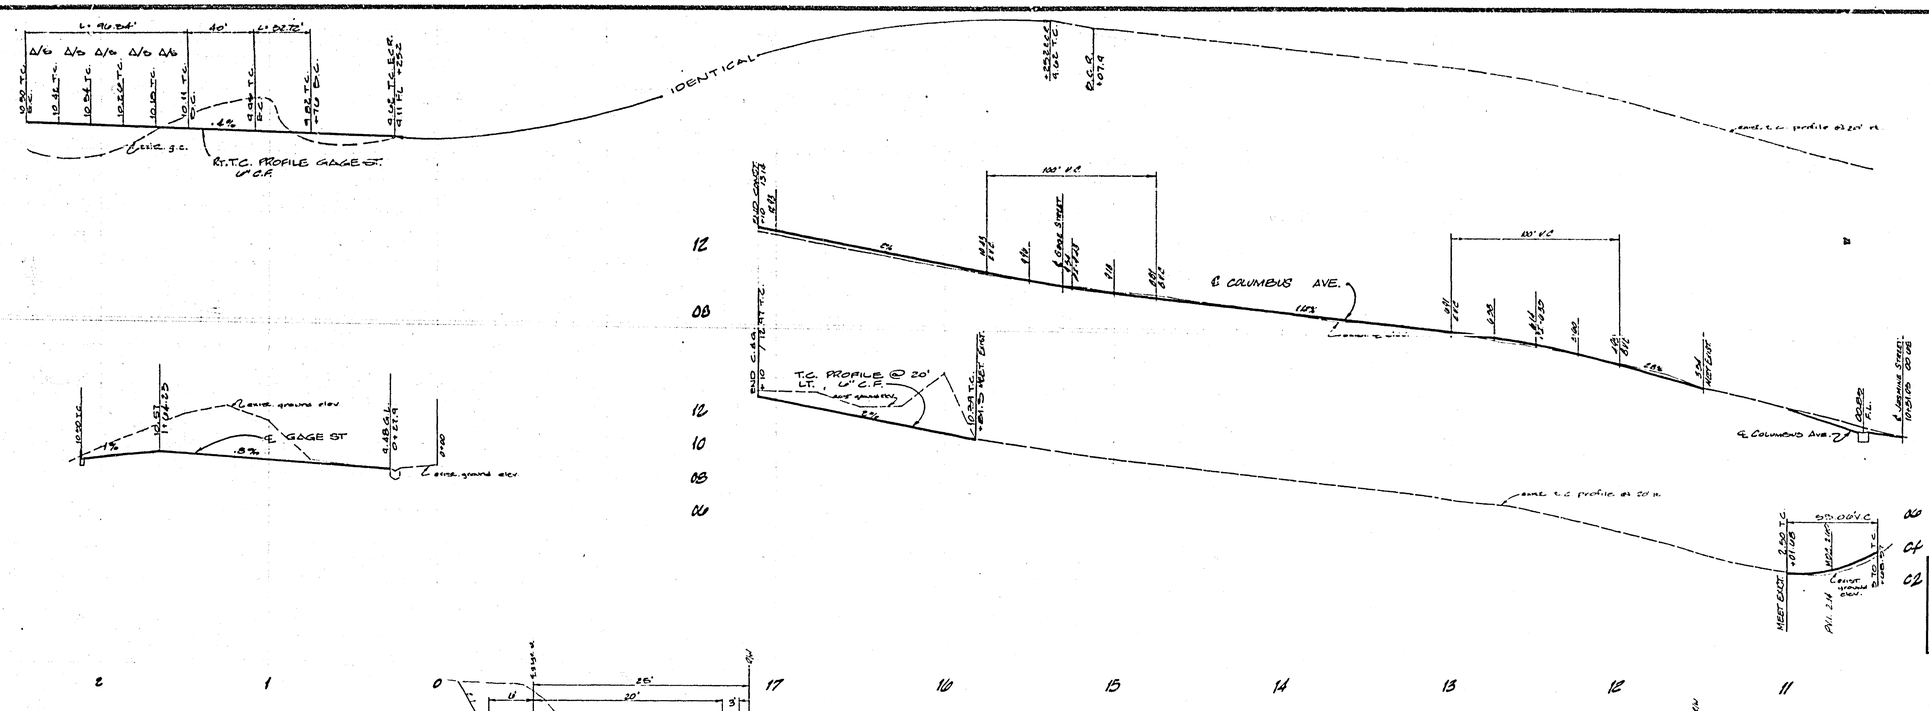

GENERAL NOTES

1. CONSTRUCTION TO BE IN ACCORDANCE WITH STANDARD SPECIFICATIONS FOR PUBLIC WORKS CONSTRUCTION, 1973 EDITION AND CITY OF RIVERSIDE STANDARD DRAWINGS.
2. THE CONTRACTOR SHALL BE RESPONSIBLE TO REPAIR OR REPLACE IN KIND AT HIS OWN EXPENSE ANY IMPROVEMENTS DAMAGED BY HIS OPERATIONS DURING CONSTRUCTION.
3. TRAFFIC SIGNS REMOVED DURING CONSTRUCTION SHALL BE SALVAGED BY THE CONTRACTOR AND RELOCATED AS DIRECTED BY THE INSPECTOR.
4. ALL SLOPES TO BE 2:1. SLOPES LESS THAN 2' HIGH ARE NOT NECESSARILY SHOWN ON THE PLAN.
5. TRANSITION NEW CONSTRUCTION TO MEET EXISTING FACILITIES AS DIRECTED BY THE INSPECTOR.
6. ADJUST ALL SEWER MANHOLES TO FINISHED GRADE.

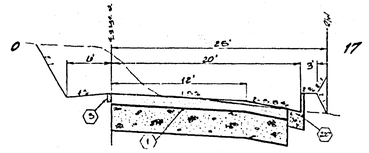

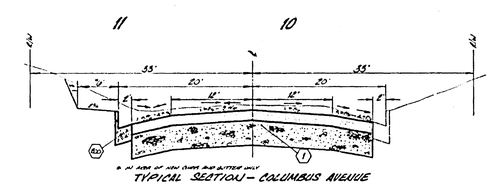

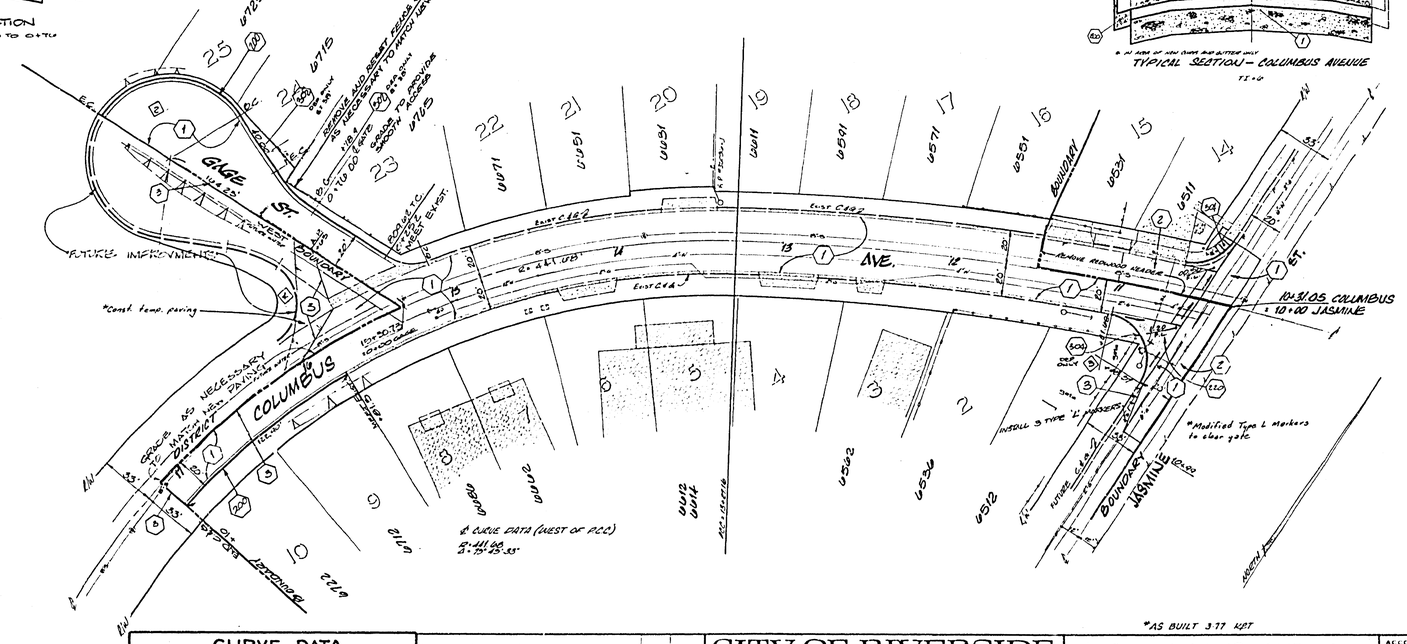

- CROSS GUTTER PER STD. DWG. 220
- CONST. WHEELCHAIR RAMP PER STD. DWG. 304
- CURB AND GUTTER PER STD. 200, TYPE I, 6" C.F.
- DRIVEWAY APPROACH PER STD. 302, (commercial), LOCATION BY OWNER.
- CONST. STRUCTURAL SECTION OF 0.25' A.C. OVER 0.25' D.G. BASE MATERIAL.
- EXIST. A.C. TO BE REMOVED PRIOR TO CONST. OF STRUCTURAL SECTION.
- CONST. 2" x 4" REDWOOD HEADER.

CURVE DATA

INDEX	R	Δ	T	L
1	75'	25° 00' 00"	16.63'	32.72'
2	45'	115° 00' 00"	75.54'	90.34'
3	27'	112° 55' 04"	40.46'	53.04'
4	27'	112° 55' 46"	40.48'	53.00'
5				
6				

MARK	REVISIONS	APPR	DATE

DESIGNED BY ___ DRAWN BY [illegible] CHECKED BY [illegible]

CITY OF RIVERSIDE
PUBLIC WORKS DEPARTMENT

APPROVALS BY		
PRINCIPAL ENGINEER	[illegible]	3/16
PARK DEPARTMENT		
TRAFFIC DIVISION	MS	4/11
CHIEF W. ENGINEER	[illegible]	6-3

APPROVED BY [signature] PUBLIC WORKS DIRECTOR

DATE 6-3-76

*AS BUILT 3-77 KPT

COLUMBUS AVENUE ASSESSMENT DISTRICT
CURB, GUTTER, AND PAVING

From Jasmine street to Gage street

HORIZ. SCALE: 1" = 40' VERT. SCALE: 1" = 4'

ACCOUNT NO. 84-451-049

R-1775

SHEET 1 OF 1

FILE NO.