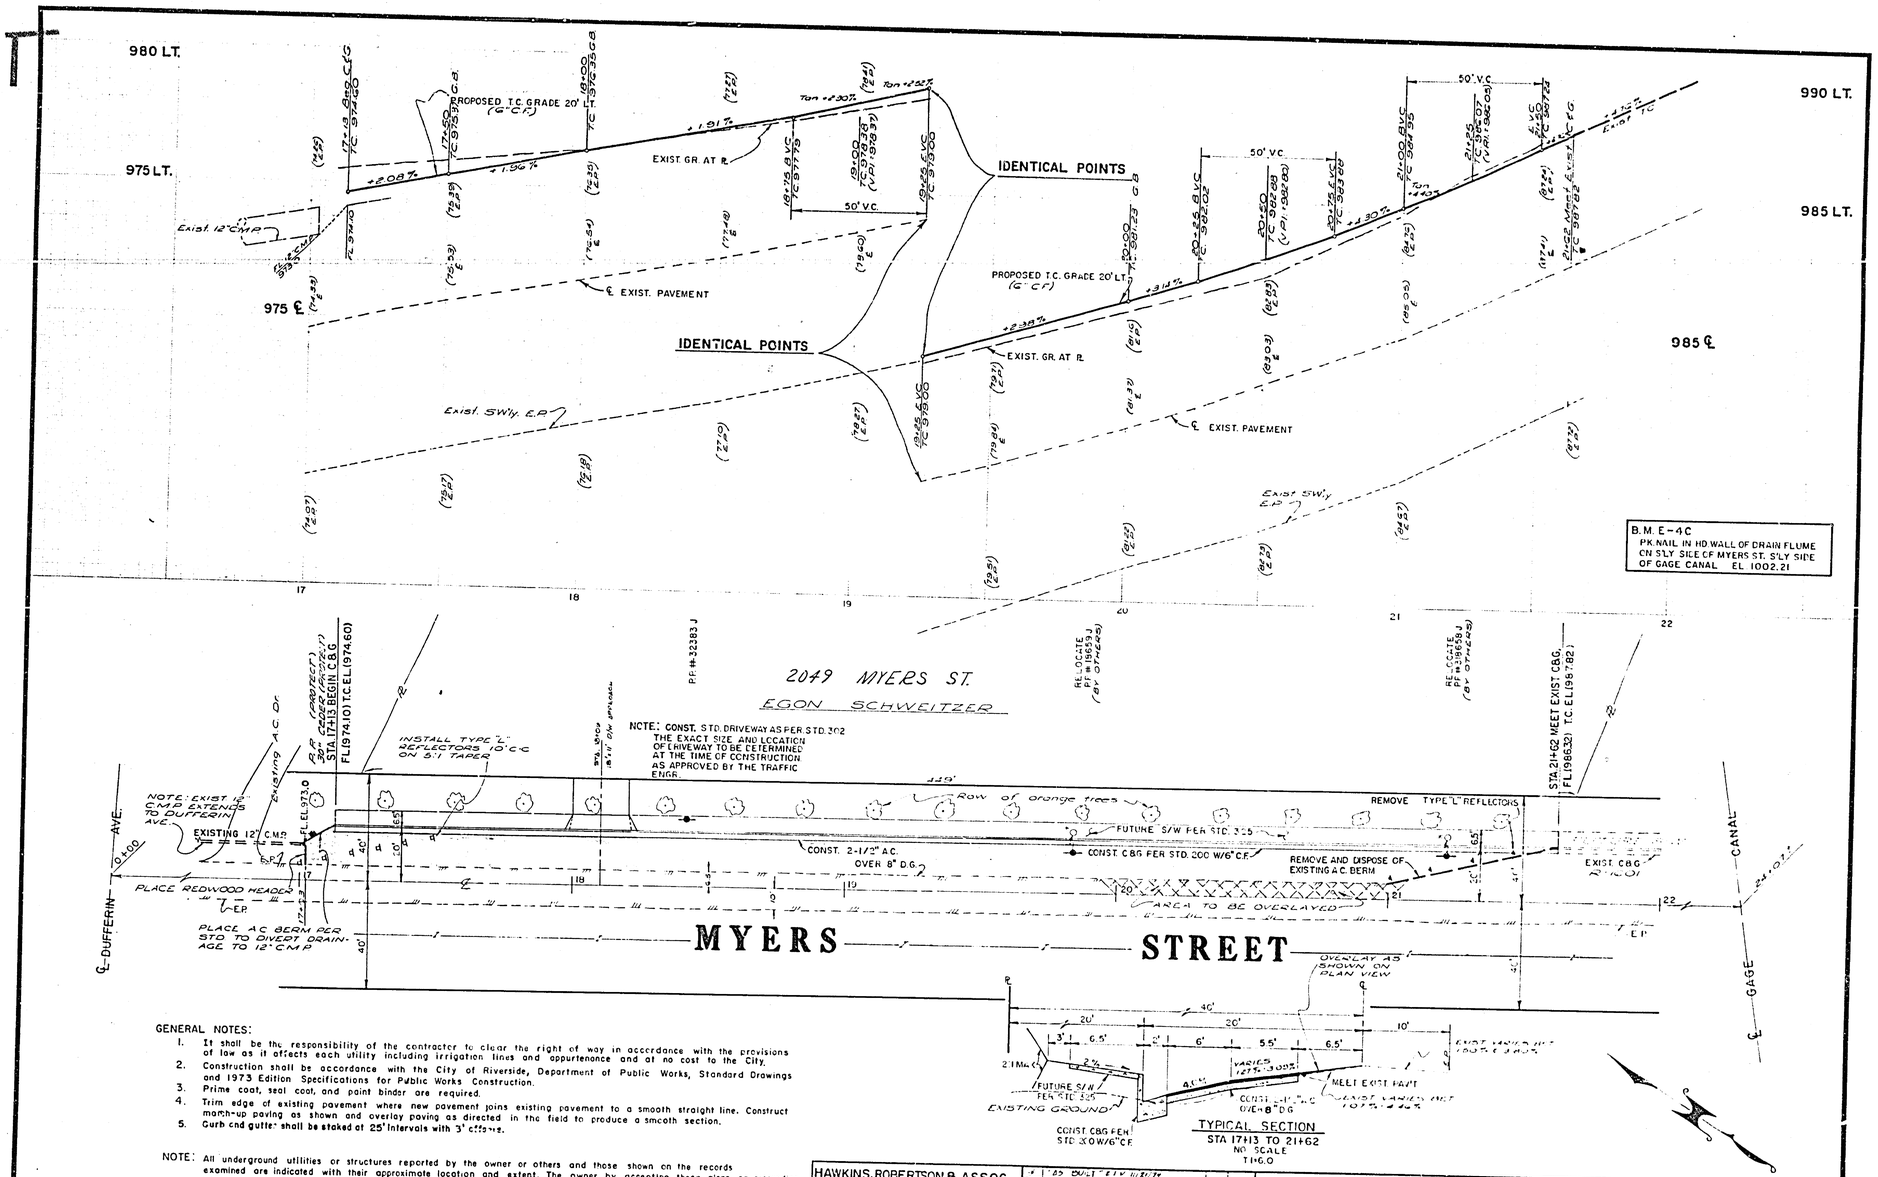

GENERAL NOTES:

1. It shall be the responsibility of the contractor to clear the right of way in accordance with the provisions of law as it affects each utility including irrigation lines and appurtenance and at no cost to the City.
2. Construction shall be accordance with the City of Riverside, Department of Public Works, Standard Drawings and 1973 Edition Specifications for Public Works Construction.
3. Prime coat, seal coat, and paint binder are required.
4. Trim edge of existing pavement where new pavement joins existing pavement to a smooth straight line. Construct match-up paving as shown and overlay paving as directed in the field to produce a smooth section.
5. Curb and gutter shall be staked at 25' intervals with 3' offsets.

NOTE: All underground utilities or structures reported by the owner or others and those shown on the records examined are indicated with their approximate location and extent. The owner by accepting these plans or proceeding with improvements pursuant thereto agrees to assume liability and to hold undersigned harmless for any damages resulting from the existence of underground utilities or structures not reported to the undersigned; not indicated on the public records examined; located at variance with that reported or shown on records examined.

HAWKINS, ROBERTSON & ASSOC.
ENGINEERS & SURVEYORS
RIVERSIDE, CALIFORNIA
R.C.E. 15016 DATE
FOR: EGON SCHWEITZER

CITY OF RIVERSIDE, CALIFORNIA
DEPARTMENT OF PUBLIC WORKS
APPROVED BY
DIRECTOR OF PUBLIC WORKS
DATE 9-3-74

STREET PLAN & PROFILE
MYERS STREET
EAST SIDE
1700' TO 2162' S'LY DUFFERIN
FOR
BUILDING PERMIT 2049 MYERS STREET
HORIZ. SCALE: 1" = 20' VERT. SCALE: 1" = 2'

PROJECT NO. R-1784
SHEET 1 OF 1
FILE NO. 74-2471