GENERAL CONSTRUCTION NOTES

1. CONSTRUCTION SHALL BE IN ACCORDANCE WITH STANDARD SPECIFICATIONS FOR PUBLIC WORKS CONSTRUCTION, 1997 EDITION, AND CITY OF RIVERSIDE STANDARD DRAWINGS.
2. THE CONTRACTOR SHALL BE RESPONSIBLE TO REPAIR OR REPLACE IN KIND AT HIS OWN EXPENSE ANY IMPROVEMENTS DAMAGED BY HIS OPERATIONS DURING CONSTRUCTION.
3. WHERE NEW CONSTRUCTION IS INDICATED:
   1 CLEAR & GRUB
   2 REMOVE EXISTING CURB, GUTTER & SIDEWALK
   3 REMOVE ALL SOFT A.C. PAVEMENT EXCEPT WHERE OVERLAY OF EXIST. PAVEMENT IS SHOWN ON THE PLAN.
   4 REMOVE ABANDONED CONC & RAIN. LIGHT BASES AND CONDUIT.
4. TRAFFIC SIGNS REMOVED DURING CONSTRUCTION SHALL BE SALVAGED BY THE CONTRACTOR AND REGRADED AS DIRECTED BY THE INSPECTOR.
5. CURB, GUTTER, & SIDEWALK REMOVAL SHALL BE TO THE LIMITS SHOWN ON THE PLAN. [illegible] JOINT BEYOND THE PLAN LIMITS AS DIRECTED BY THE INSPECTOR.
6. SLOPES LESS THAN 2' HIGH ARE NOT NECESSARILY SHOWN ON THE PLAN. ALL CUT SLOPES TO BE 2:1 OR FLATTER
7. TRANSITION NEW CONSTRUCTION TO MEET EXIST. FACILITIES AS DIRECTED BY THE INSPECTOR.
8. ADJUST SEWER MANHOLE TO FINISHED GRADE.
9. ALL ELEVATIONS SHOWN ON THE PLAN SHALL BE STAKED IN THE FIELD.
10. INSTALL NEW FENCE, TYPE ATD-6, WHERE REQUIRED ON PLAN.
11. ALL TRAFFIC WORK SHALL BE IN ACCORDANCE WITH STATE OF CALIFORNIA STANDARD SPECIFICATIONS AND TRAFFIC MANUAL, AND AS DIRECTED BY TRAFFIC DIVISION.
12. THE EXISTING FIVE PALM TREES SHALL BE TRANSPLANTED TO LOCATION SHOWN ON PLAN.

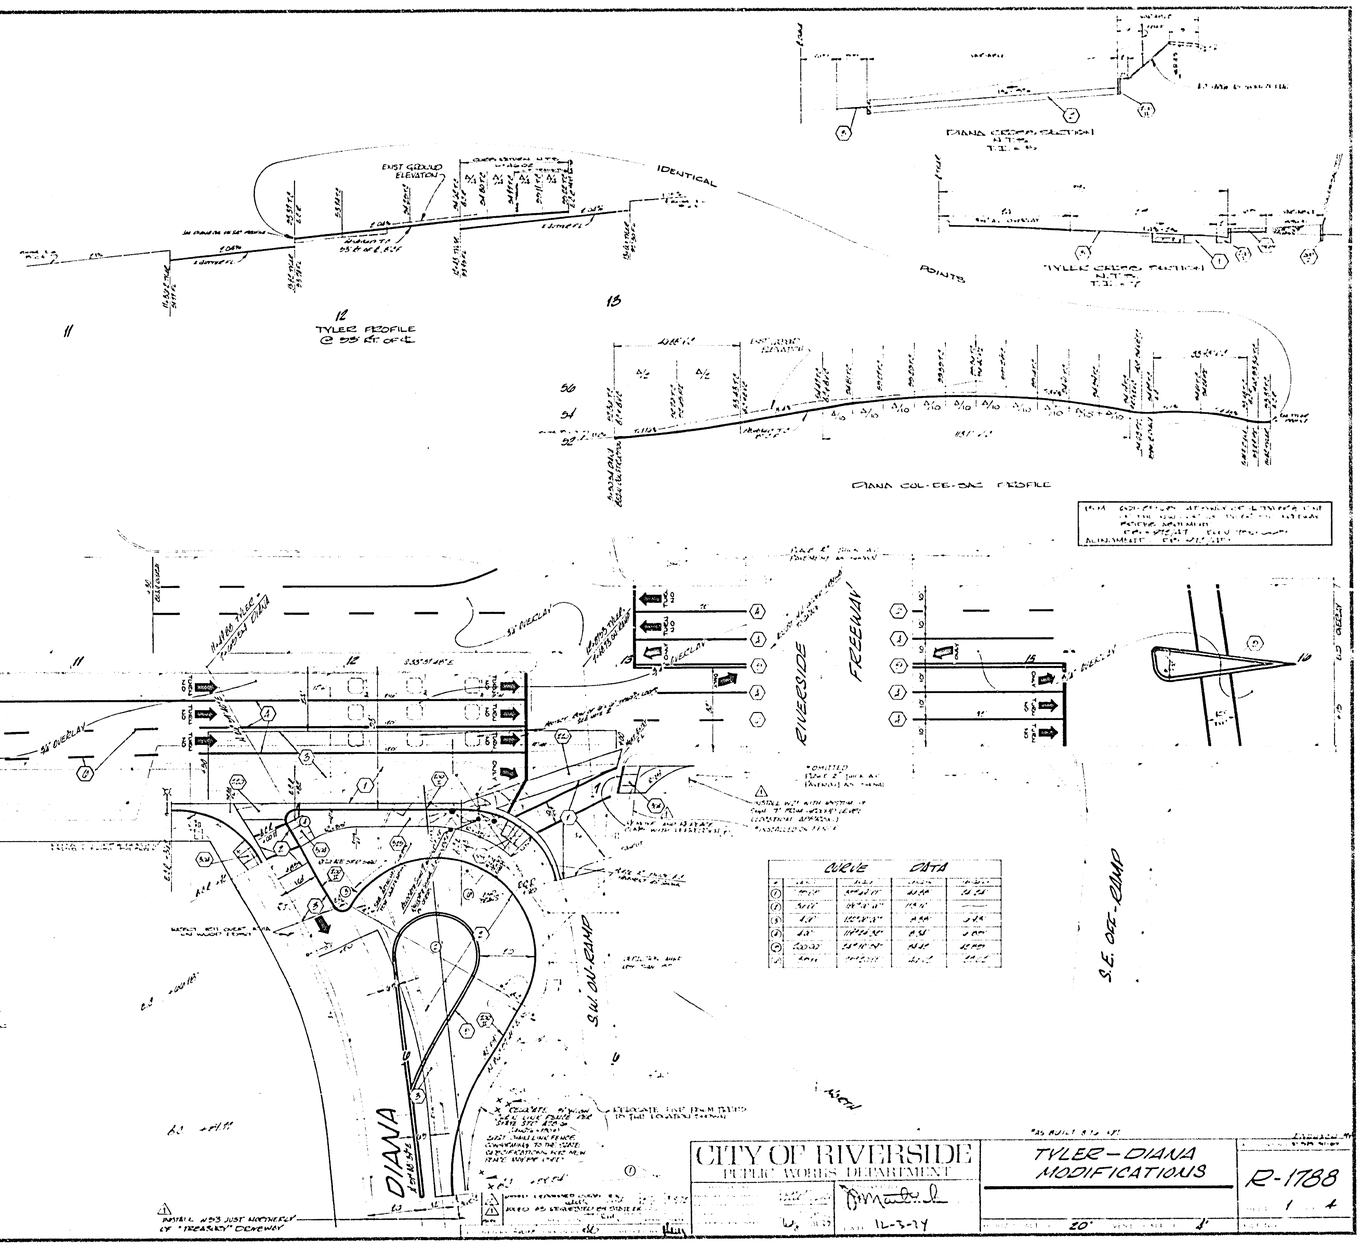

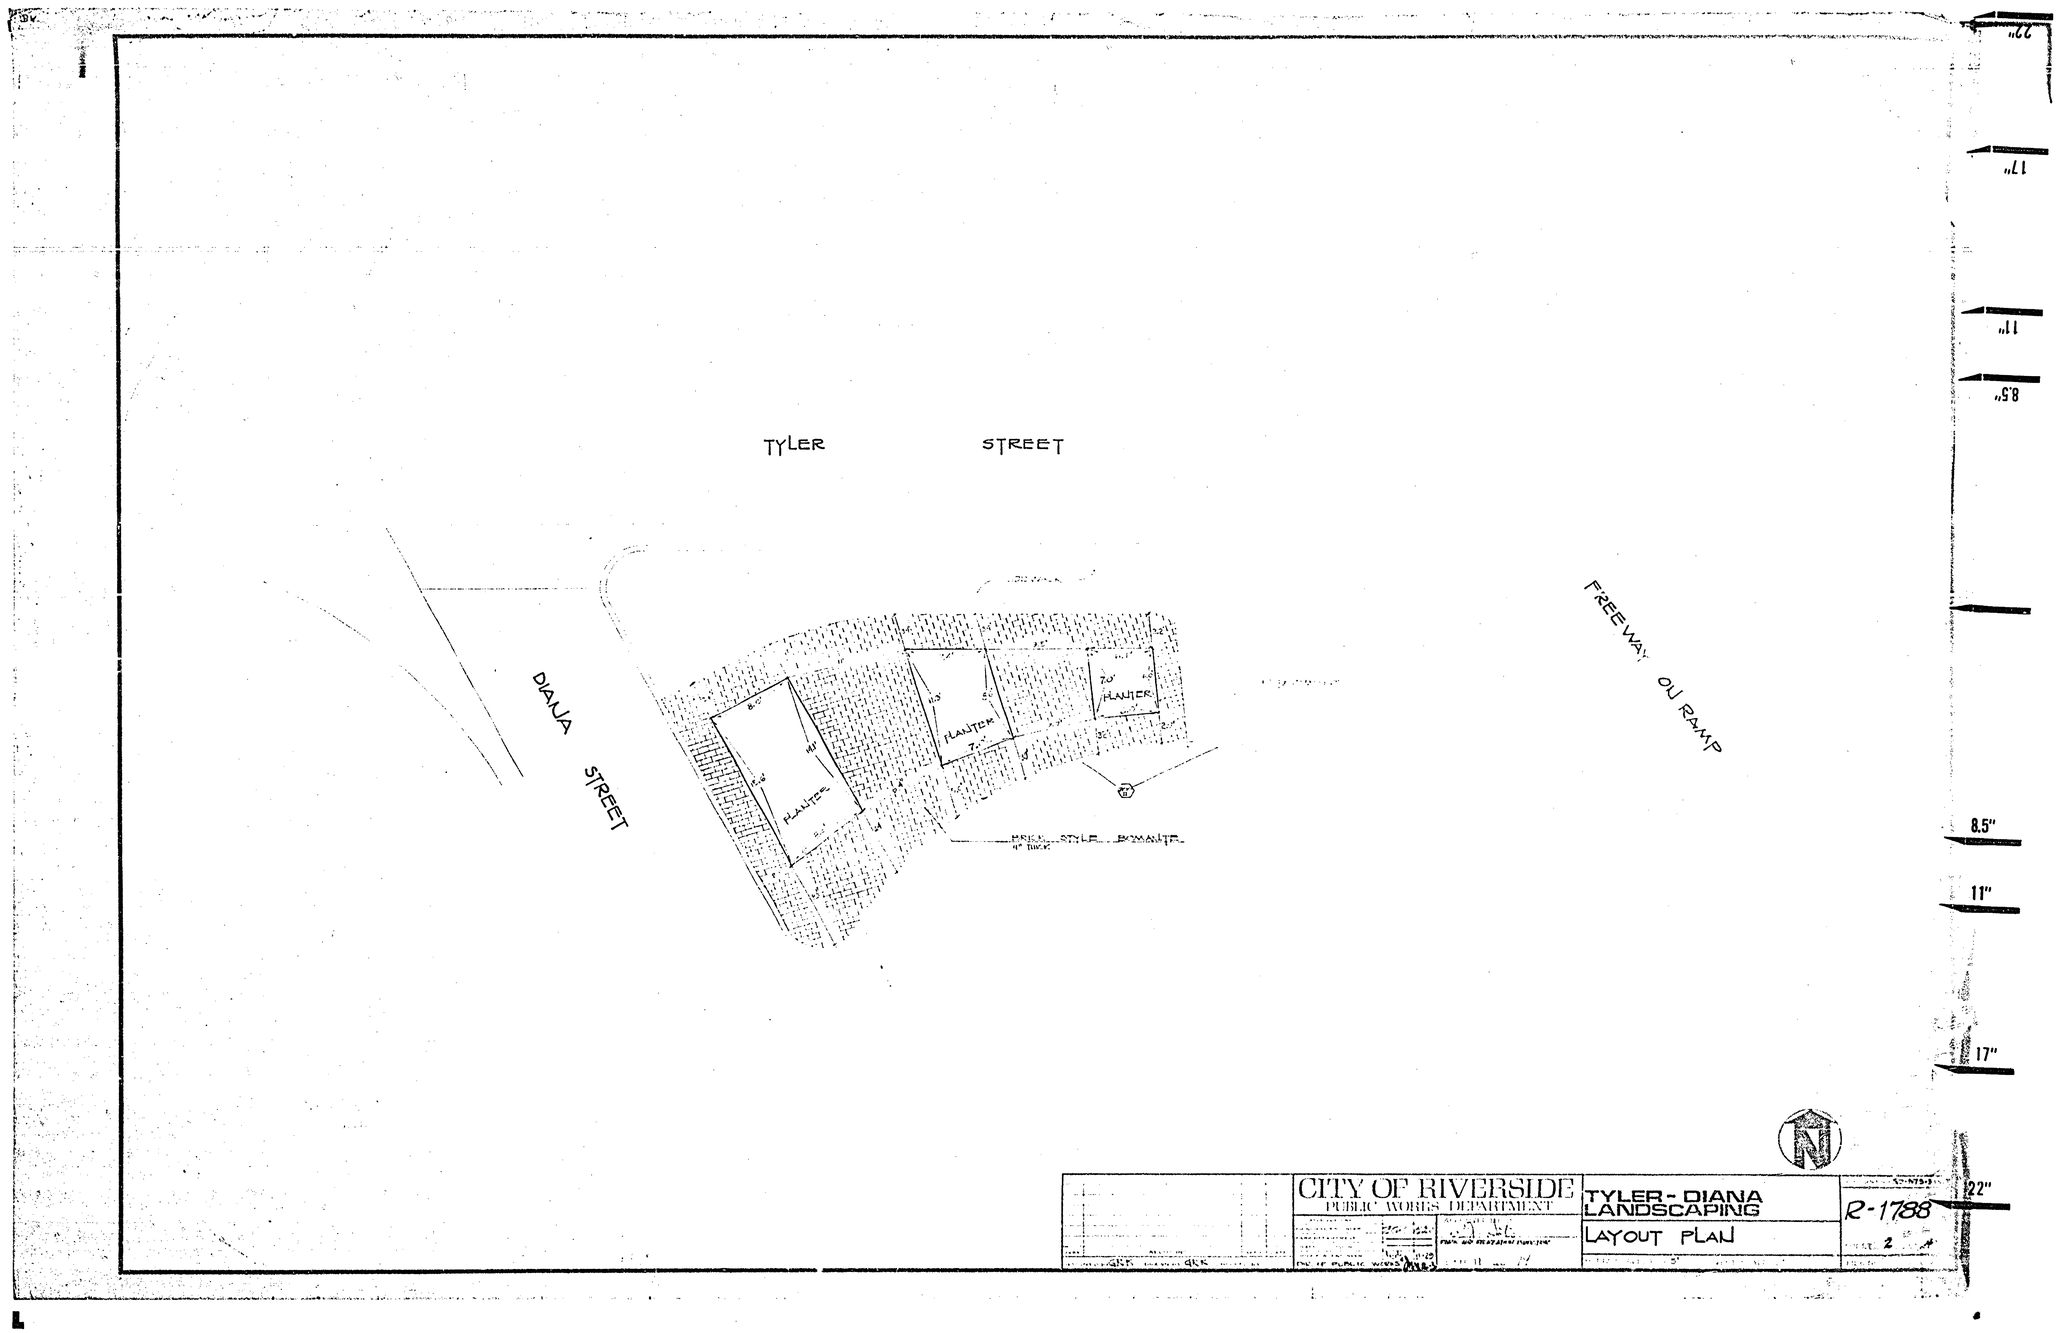
TYLER STREET
DIANA STREET
FREEWAY ON RAMP
PLANTER
PLANTER
PLANTER
BRICK STYLE BOMANITE
CITY OF RIVERSIDE
PUBLIC WORKS DEPARTMENT
TYLER - DIANA
LANDSCAPING
LAYOUT PLAN
R-1788
2

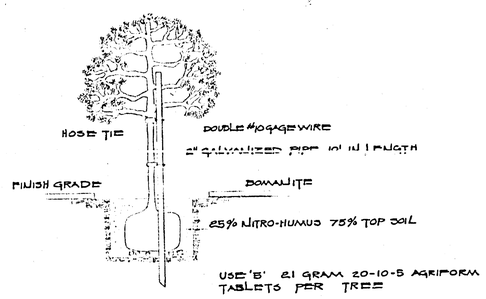

TYLER STREET

DIANA STREET

FREEWAY ON RAMP

CUPUNIA ANACARDIOIDES
24" BOX TREE

CROSSED HATCHED AREAS INDICATE WHERE "HEMEROCALLIS HYBRID ORANGE" SHALL BE PLANTED. THEY SHALL BE 1 GALLON IN SIZE AND BE PLANTED 18" ON CENTER. APPLY 1' 5 GRAM 20-10-5 AGRIFORM TABLET PER PLANT.

THERE SHALL BE 60 PLANTS IN THE LARGEST PLANTER, 40 PLANTS IN THE MIDDLE PLANTER & 25 PLANTS IN THE SMALLEST PLANTER.

	CITY OF RIVERSIDE PUBLIC WORKS DEPARTMENT	TYLER - DIANA LANDSCAPING	R-1788
		PLANTING PLAN	SHEET 3 OF 4

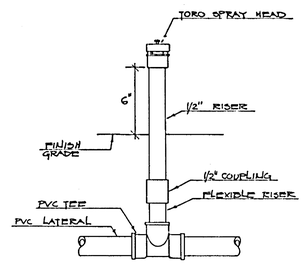

INSTALLATION DETAIL

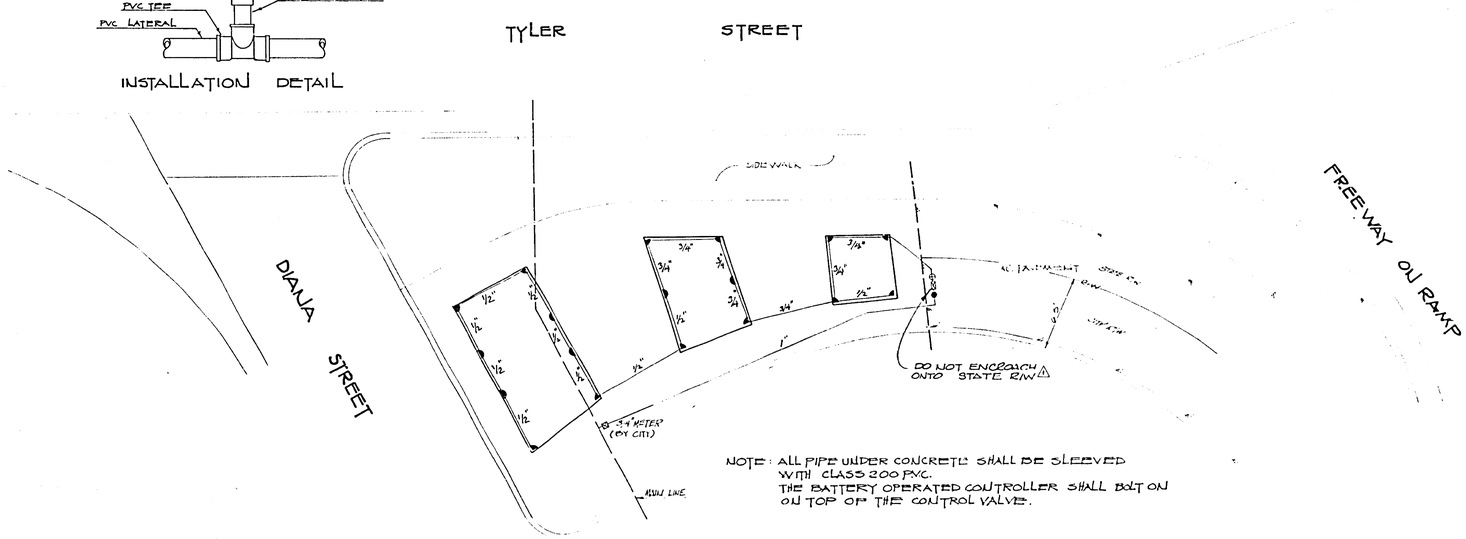

NOTE: ALL PIPE UNDER CONCRETE SHALL BE SLEEVED WITH CLASS 200 PVC.
THE BATTERY OPERATED CONTROLLER SHALL BOLT ON ON TOP OF THE CONTROL VALVE.

SPRINKLER LEGEND					
SYMBOL	DESCRIPTION	MANUFACTURER	RAD.	GPM.	PSI.
D	1/4 SPRAY HEAD	TORO # 500-10	12'	0.6	20
⌂	1/2 SPRAY HEAD	TORO # 500-10	12'	1.2	20
⊕	3/4" CONTROL VALVE	CHAMPION #100			
⊠	3/4" BACKFLOW PREVENTER	SMR 701			
	BATTERY OPERATED CONTROLLER	WATER WATCHER #2000			
——	CLASS 200 PVC				
●	PRESSURE REDUCING VALVE 1"	GRISWOLD #2800			10-50

REVISED AS REQUESTED BY STATE R.W. July 1/11/12

CITY OF RIVERSIDE
PUBLIC WORKS DEPARTMENT

TYLER-DIANA LANDSCAPING

SPRINKLER PLAN

R-1788