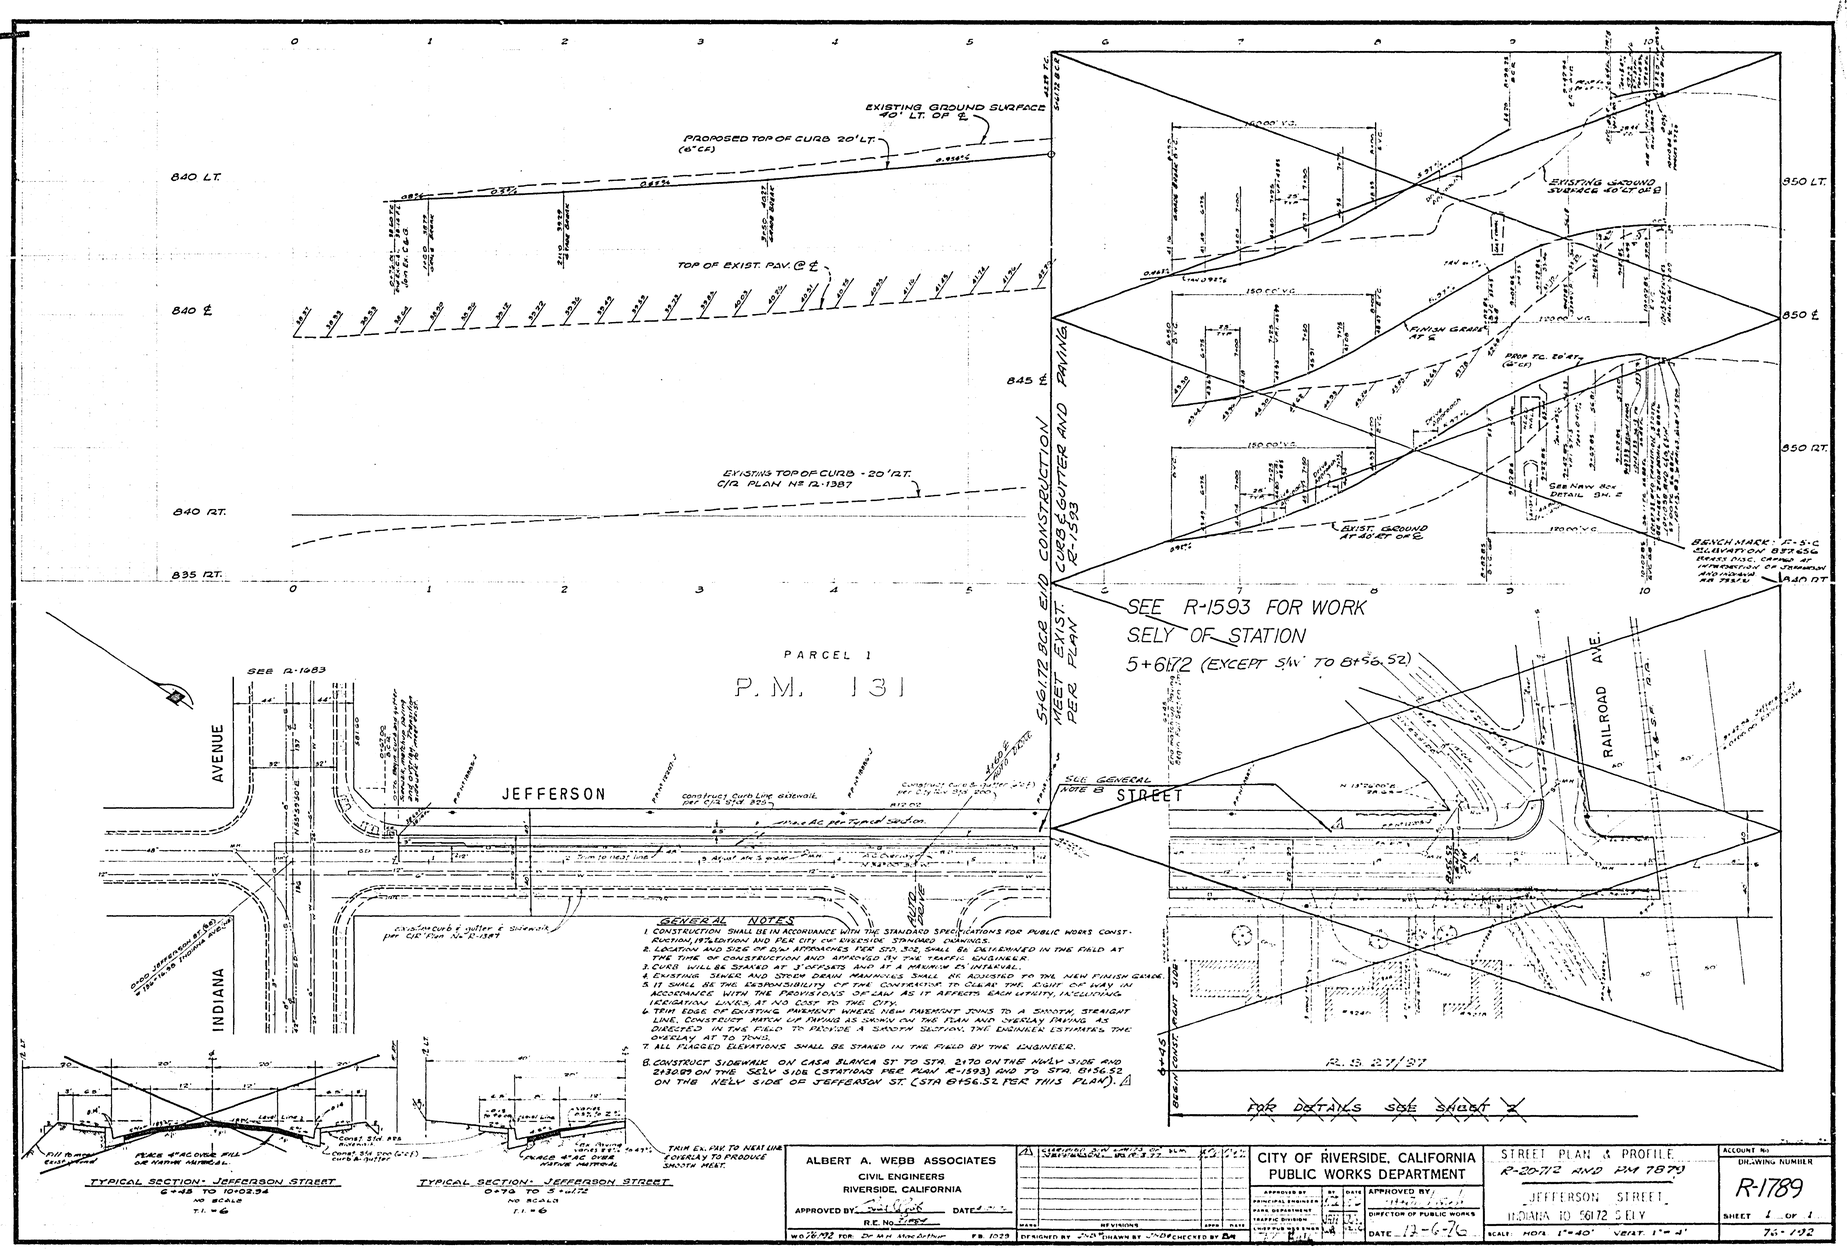

GENERAL NOTES

1. CONSTRUCTION SHALL BE IN ACCORDANCE WITH THE STANDARD SPECIFICATIONS FOR PUBLIC WORKS CONSTRUCTION, 1976 EDITION AND PER CITY OF RIVERSIDE STANDARD DRAWINGS.
2. LOCATION AND SIZE OF D/W APPROACHES PER STD. 352, SHALL BE DETERMINED IN THE FIELD AT THE TIME OF CONSTRUCTION AND APPROVED BY THE TRAFFIC ENGINEER.
3. CURB WILL BE STAKED AT 3' OFFSETS AND AT A MAXIMUM 25' INTERVAL.
4. EXISTING SEWER AND STORM DRAIN MANHOLES SHALL BE ADJUSTED TO THE NEW FINISH GRADE.
5. IT SHALL BE THE RESPONSIBILITY OF THE CONTRACTOR TO CLEAR THE RIGHT OF WAY IN ACCORDANCE WITH THE PROVISIONS OF LAW AS IT AFFECTS EACH UTILITY, INCLUDING RELOCATING LINES, AT NO COST TO THE CITY.
6. TRIM EDGE OF EXISTING PAVEMENT WHERE NEW PAVEMENT JOINS TO A SMOOTH STRAIGHT LINE. CONSTRUCT MATCH UP PAVING AS SHOWN ON THE PLAN AND OVERLAY PAVING AS DIRECTED IN THE FIELD TO PROVIDE A SMOOTH SECTION. THE ENGINEER ESTIMATES THE OVERLAY AT 70 TONS.
7. ALL FLAGGED ELEVATIONS SHALL BE STAKED IN THE FIELD BY THE ENGINEER.
8. CONSTRUCT SIDEWALK ON CASA BLANCA ST TO STA 2+70 ON THE NWLY SIDE AND 2+30.29 ON THE SELY SIDE (STATIONS PER PLAN R-1593) AND TO STA 8+56.52 ON THE NELY SIDE OF JEFFERSON ST. (STA 8+56.52 FOR THIS PLAN). Δ

ALBERT A. WEBB ASSOCIATES CIVIL ENGINEERS RIVERSIDE, CALIFORNIA APPROVED BY: [signature] DATE [illegible] R.E. No. [illegible]	Δ CLARIFYING D/W WIDTH ON NWLY SIDE OF JEFFERSON ST. PER R-1593	CITY OF RIVERSIDE, CALIFORNIA PUBLIC WORKS DEPARTMENT APPROVED BY / DIRECTOR OF PUBLIC WORKS DATE 12-6-76	STREET PLAN & PROFILE R-20-172 AND PM 7870 JEFFERSON STREET INDIANA TO 5+61.72 S ELY SCALE: HOR. 1"=40' VERT. 1"=4'
W.O. 76-192 FOR: Dr. M.H. MacArthur F.B. 1029	REVISIONS DESIGNED BY [illegible] DRAWN BY [illegible] CHECKED BY [illegible]		ACCOUNT No. DRAWING NUMBER R-1789 SHEET 1 OF 1 76-192

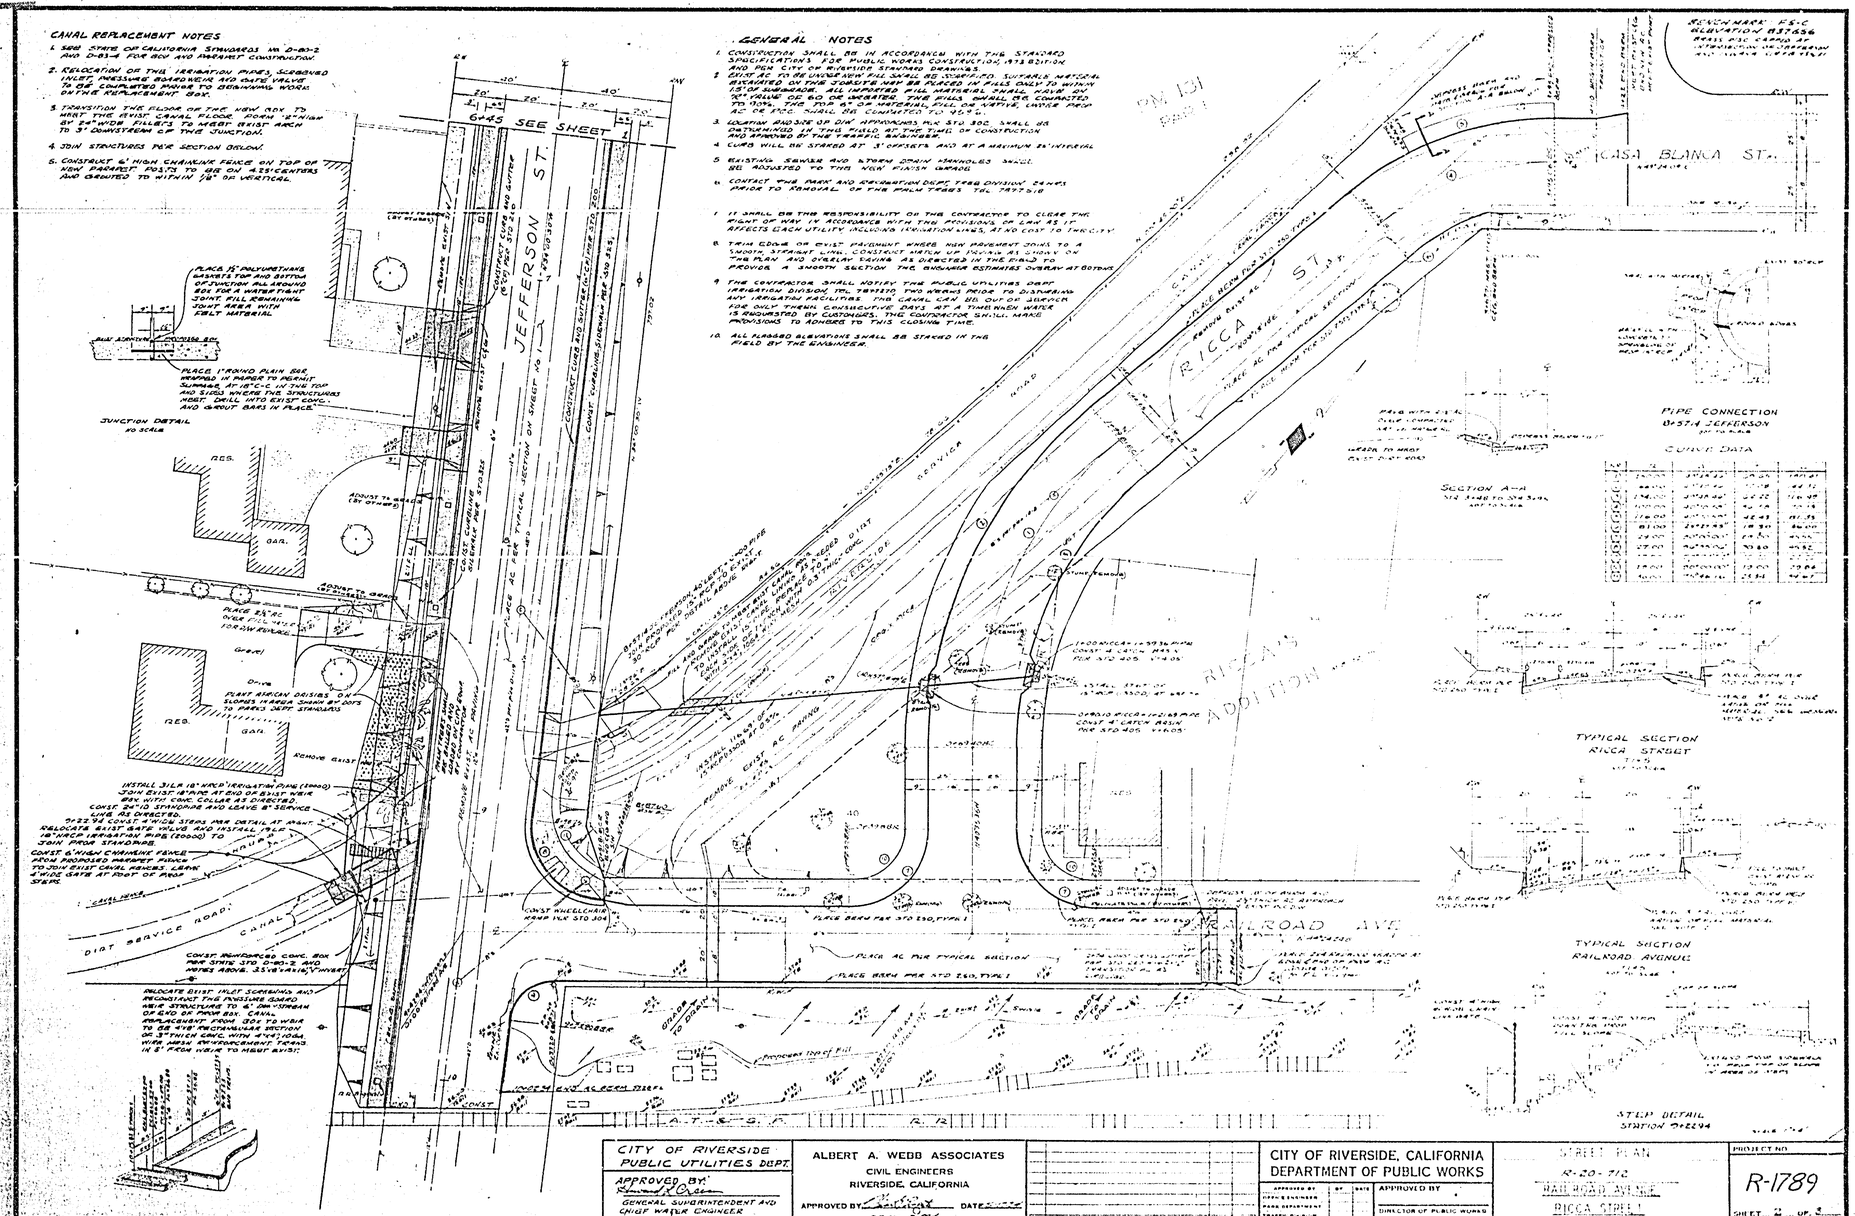
CANAL REPLACEMENT NOTES
GENERAL NOTES
JEFFERSON ST.
RICCA ST.
CASA BLANCA ST.
RAILROAD AVE
RICCA'S ADDITION
PIPE CONNECTION
CURVE DATA
TYPICAL SECTION RICCA STREET
TYPICAL SECTION RAILROAD AVENUE
STEP DETAIL
CURB TRANSITION DETAIL
JUNCTION DETAIL
CITY OF RIVERSIDE PUBLIC UTILITIES DEPT.
ALBERT A. WEBB ASSOCIATES
CIVIL ENGINEERS
RIVERSIDE, CALIFORNIA
CITY OF RIVERSIDE, CALIFORNIA
DEPARTMENT OF PUBLIC WORKS
STREET PLAN
R-20-712
RAILROAD AVENUE
RICCA STREET
PROJECT NO.
R-1789
SHEET 2 OF 3
FILE NO. 71-279