CONSTRUCTION NOTES

1. CONSTRUCTION TO BE IN ACCORDANCE WITH ESTABLISHED SPECIFICATIONS FOR PUBLIC WORKS CONSTRUCTION, 1973 EDITION, CITY OF RIVERSIDE STANDARD DRAWINGS.
2. WHERE NEW CONSTRUCTION IS INDICATED:
   a. CLEAR AND GRUB
   b. REMOVE EXISTING EARTH & PAVING AS NOTED
   c. REMOVE THE TREES IN AREA OF CONSTRUCTION AND ELSEWHERE AS NOTED ON THE PLANS.
3. THE CONTRACTOR SHALL BE RESPONSIBLE TO REPAIR OR REPLACE IN KIND AT HIS OWN EXPENSE ANY IMPROVEMENTS, IRRIGATION PIPES OR FENCES REMOVED OR DAMAGED BY HIS OPERATIONS DURING CONSTRUCTION.
4. TRAFFIC SIGNS REMOVED DURING CONSTRUCTION SHALL BE SALVAGED BY THE CONTRACTOR AND RELOCATED AS DIRECTED BY THE INSPECTOR.
5. TRANSITION NEW CONSTRUCTION TO MEET EXISTING FACILITIES AS DIRECTED BY THE INSPECTOR.
6. ALL ELEVATIONS SHOWN ON THE PLANS SHALL BE STAKED IN THE FIELD.
7. RELOCATE OR REINSTALL FENCES, IN KIND, WHERE REQUIRED ON PLAN.
8. FOG SEAL SHALL BE APPLIED OVER OLD & NEW PAVEMENT TO LIMITS SHOWN ON PLAN.
9. THE PROPOSED TELEPHONE WORK IS SCHEDULED TO BE COMPLETED BEFORE THE END OF JULY, 1975.
10. EXACT DEPTH OF UNDERGROUND UTILITIES MARKED "?" ARE UNKNOWN. THE LOCATIONS AND DEPTHS SHOWN ON THE PLAN ARE FROM UTILITY RECORDS. THE CONTRACTOR IS REQUIRED TO TAKE CARE PRECAUTIONARY MEASURES TO LOCATE AND PROTECT ALL UNDERGROUND FACILITIES.

CONSTRUCTION LEGEND

- (17) ASPHALT CONCRETE BERM PER STD. DWG. 220, TYPE I WITH DEPRESSION TO 0.00' AT DRIVEWAYS.
- (1) CONSTRUCT STRUCTURAL SECTION OF 0.80' ASPHALT CONCRETE OVER NATIVE SOIL.
- (2) OVERLAY EXIST A.C. PAVEMENT WITH A VARIABLE THICKNESS OF ASPHALT CONCRETE.
- (3) OVERLAY A.C. REPLACE OR REGRADE DRIVEWAY TO GRADES AND MATERIALS SHOWN ON THE PLAN. A.C. 2' THK.
- GRADE BANK AS SHOWN ON PLAN.

E.P. CURVE DATA
R = 35'
Δ = 90°
L = 54.98'
T = 35'

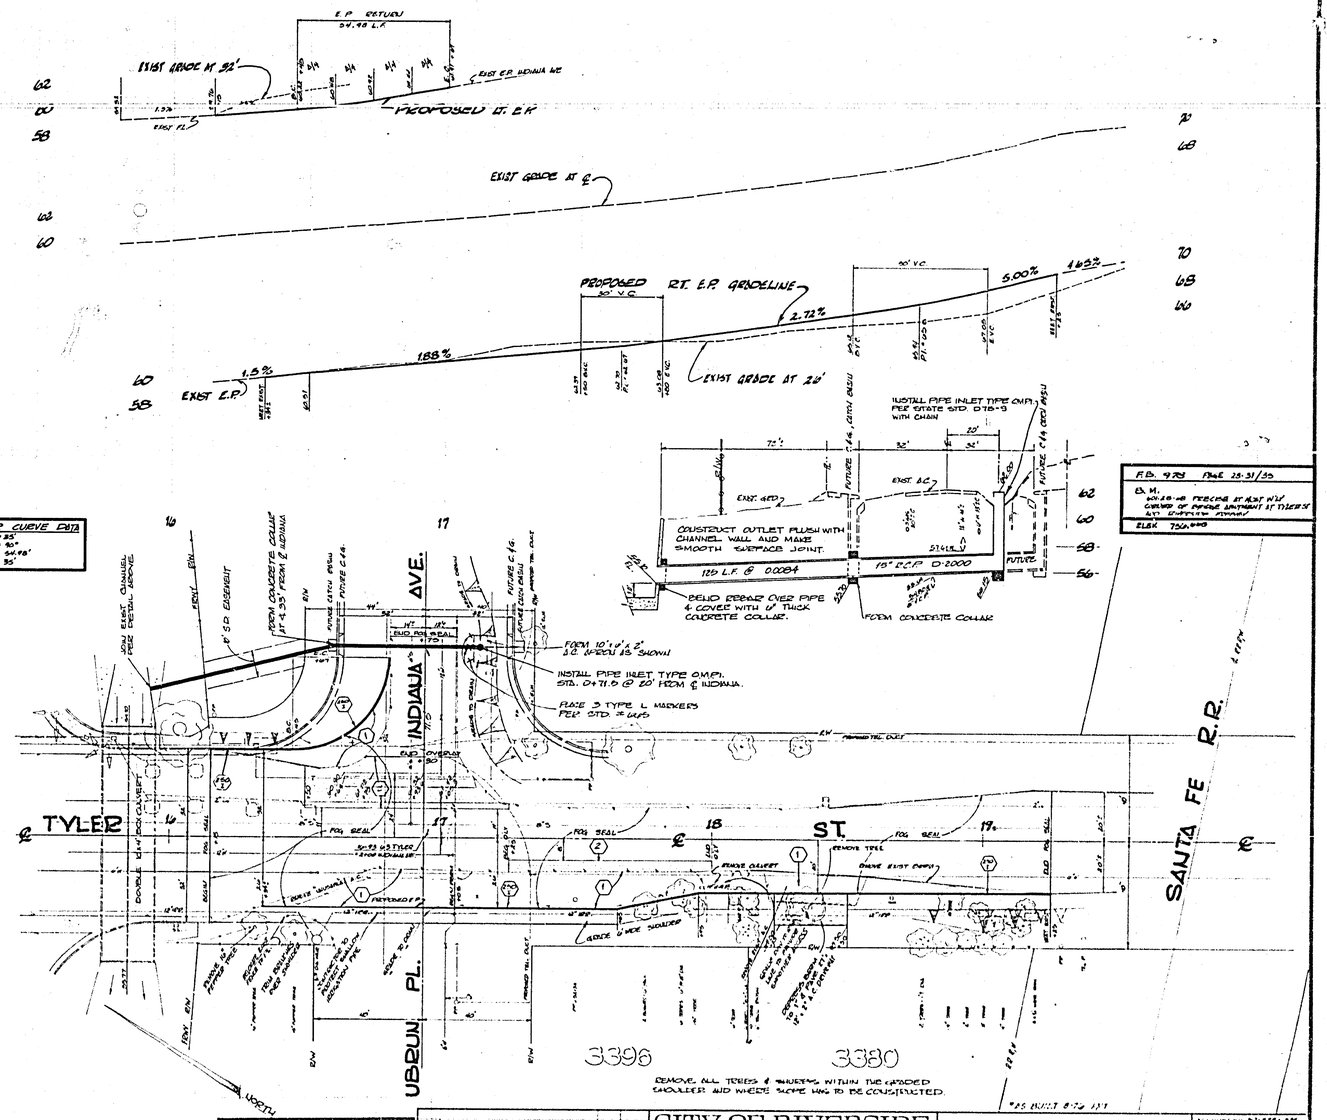

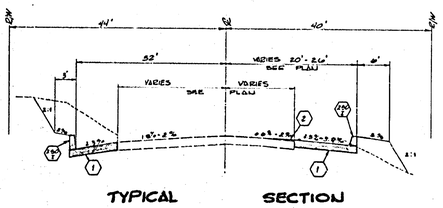

F.D. 4.79 PAGE 25-31/35
B.M.
NO. 28-48 PENCIL AT EAST W'LY CORNER OF REPAIR ABUTMENT AT TYLER ST. & ST. CROSSING STRUCTURE
ELEV. 726.449

-CAUTION-
PACIFIC TELEPHONE CABLES UNDERGROUND BEFORE EXCAVATING CALL COLLECT:
7:30 A.M. to 5 P.M. — After Hours & Holidays
Orange County 714-633-0811 — 714-547-6636
Riverside County 714-684-0071 — 714-547-6636

REVISIONS — DATE
DESIGNED BY — DRAWN BY E.K. — CHECKED BY

CITY OF RIVERSIDE
PUBLIC WORKS DEPARTMENT
APPROVALS — DATE
PRINCIPAL ENGINEER — 1/13/75
PROJECT ENGINEER — 1/12/75
DATE 1-13-75

TYLER STREET WIDENING

FREEWAY TO SANTA FE RAILROAD

HORIZ. SCALE 1" = 20' VERT. SCALE 1" = 4'

R-1793

SHEET 1 OF 1

FILE NO.