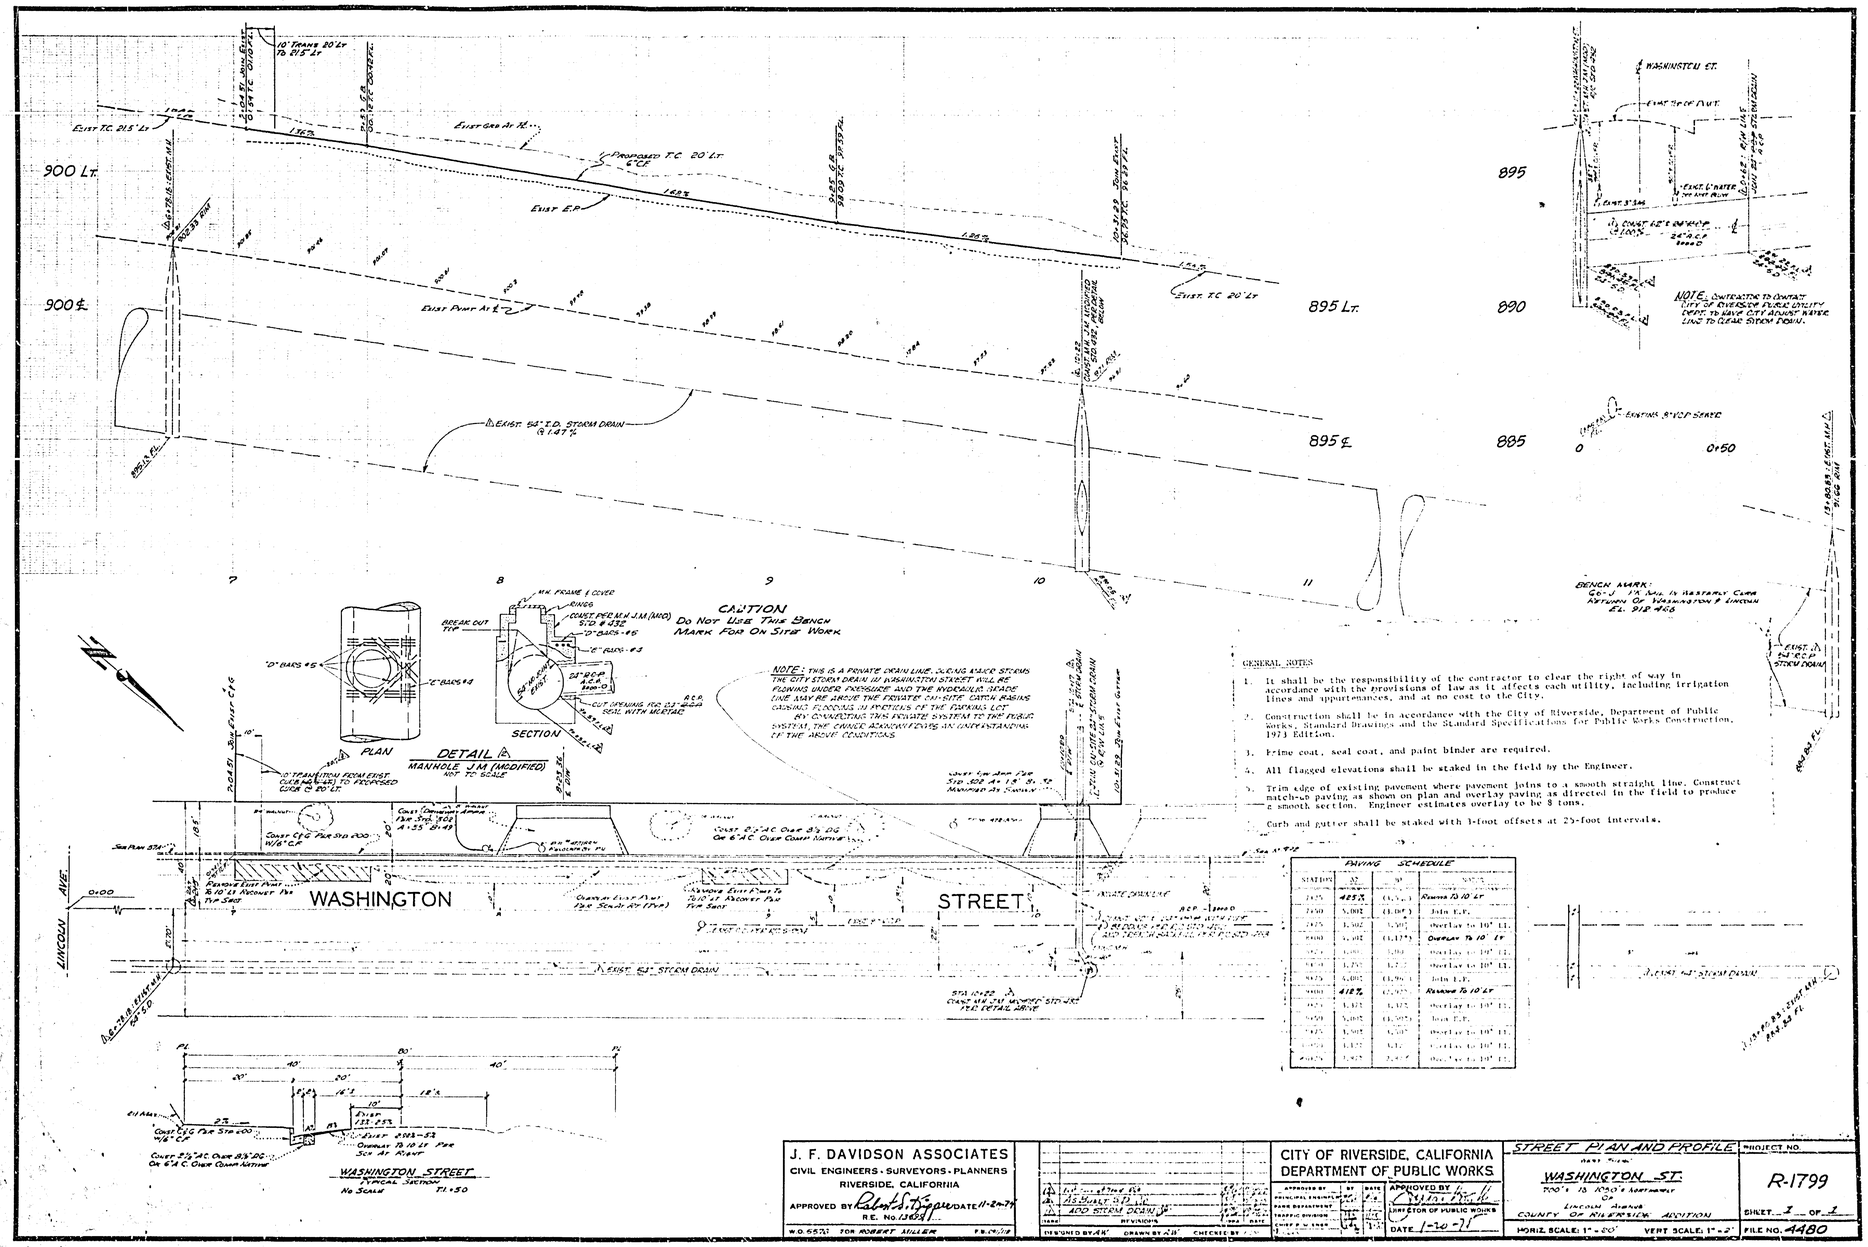
900 Lt.
900 ℄
895 Lt.
895 ℄
895
890
885
WASHINGTON
STREET
LINCOLN AVE.
PLAN
SECTION
DETAIL
MANHOLE J.M. (MODIFIED)
NOT TO SCALE
CAUTION
DO NOT USE THIS BENCH MARK FOR ON SITE WORK
BENCH MARK:
WASHINGTON ST.
GENERAL NOTES
1. It shall be the responsibility of the contractor to clear the right of way in accordance with the provisions of law as it affects each utility, including irrigation lines and appurtenances, and at no cost to the City.
2. Construction shall be in accordance with the City of Riverside, Department of Public Works, Standard Drawings and the Standard Specifications for Public Works Construction, 1971 Edition.
3. Prime coat, seal coat, and paint binder are required.
4. All flagged elevations shall be staked in the field by the Engineer.
5. Trim edge of existing pavement where pavement joins to a smooth straight line. Construct match-up paving as shown on plan and overlay paving as directed in the field to produce a smooth section. Engineer estimates overlay to be 8 tons.
6. Curb and gutter shall be staked with 3-foot offsets at 25-foot intervals.
PAVING SCHEDULE
WASHINGTON STREET
TYPICAL SECTION
NO SCALE
J. F. DAVIDSON ASSOCIATES
CIVIL ENGINEERS · SURVEYORS · PLANNERS
RIVERSIDE, CALIFORNIA
CITY OF RIVERSIDE, CALIFORNIA
DEPARTMENT OF PUBLIC WORKS
STREET PLAN AND PROFILE
WASHINGTON ST.
LINCOLN AVENUE
COUNTY OF RIVERSIDE ADDITION
PROJECT NO. R-1799
FILE NO. 4480