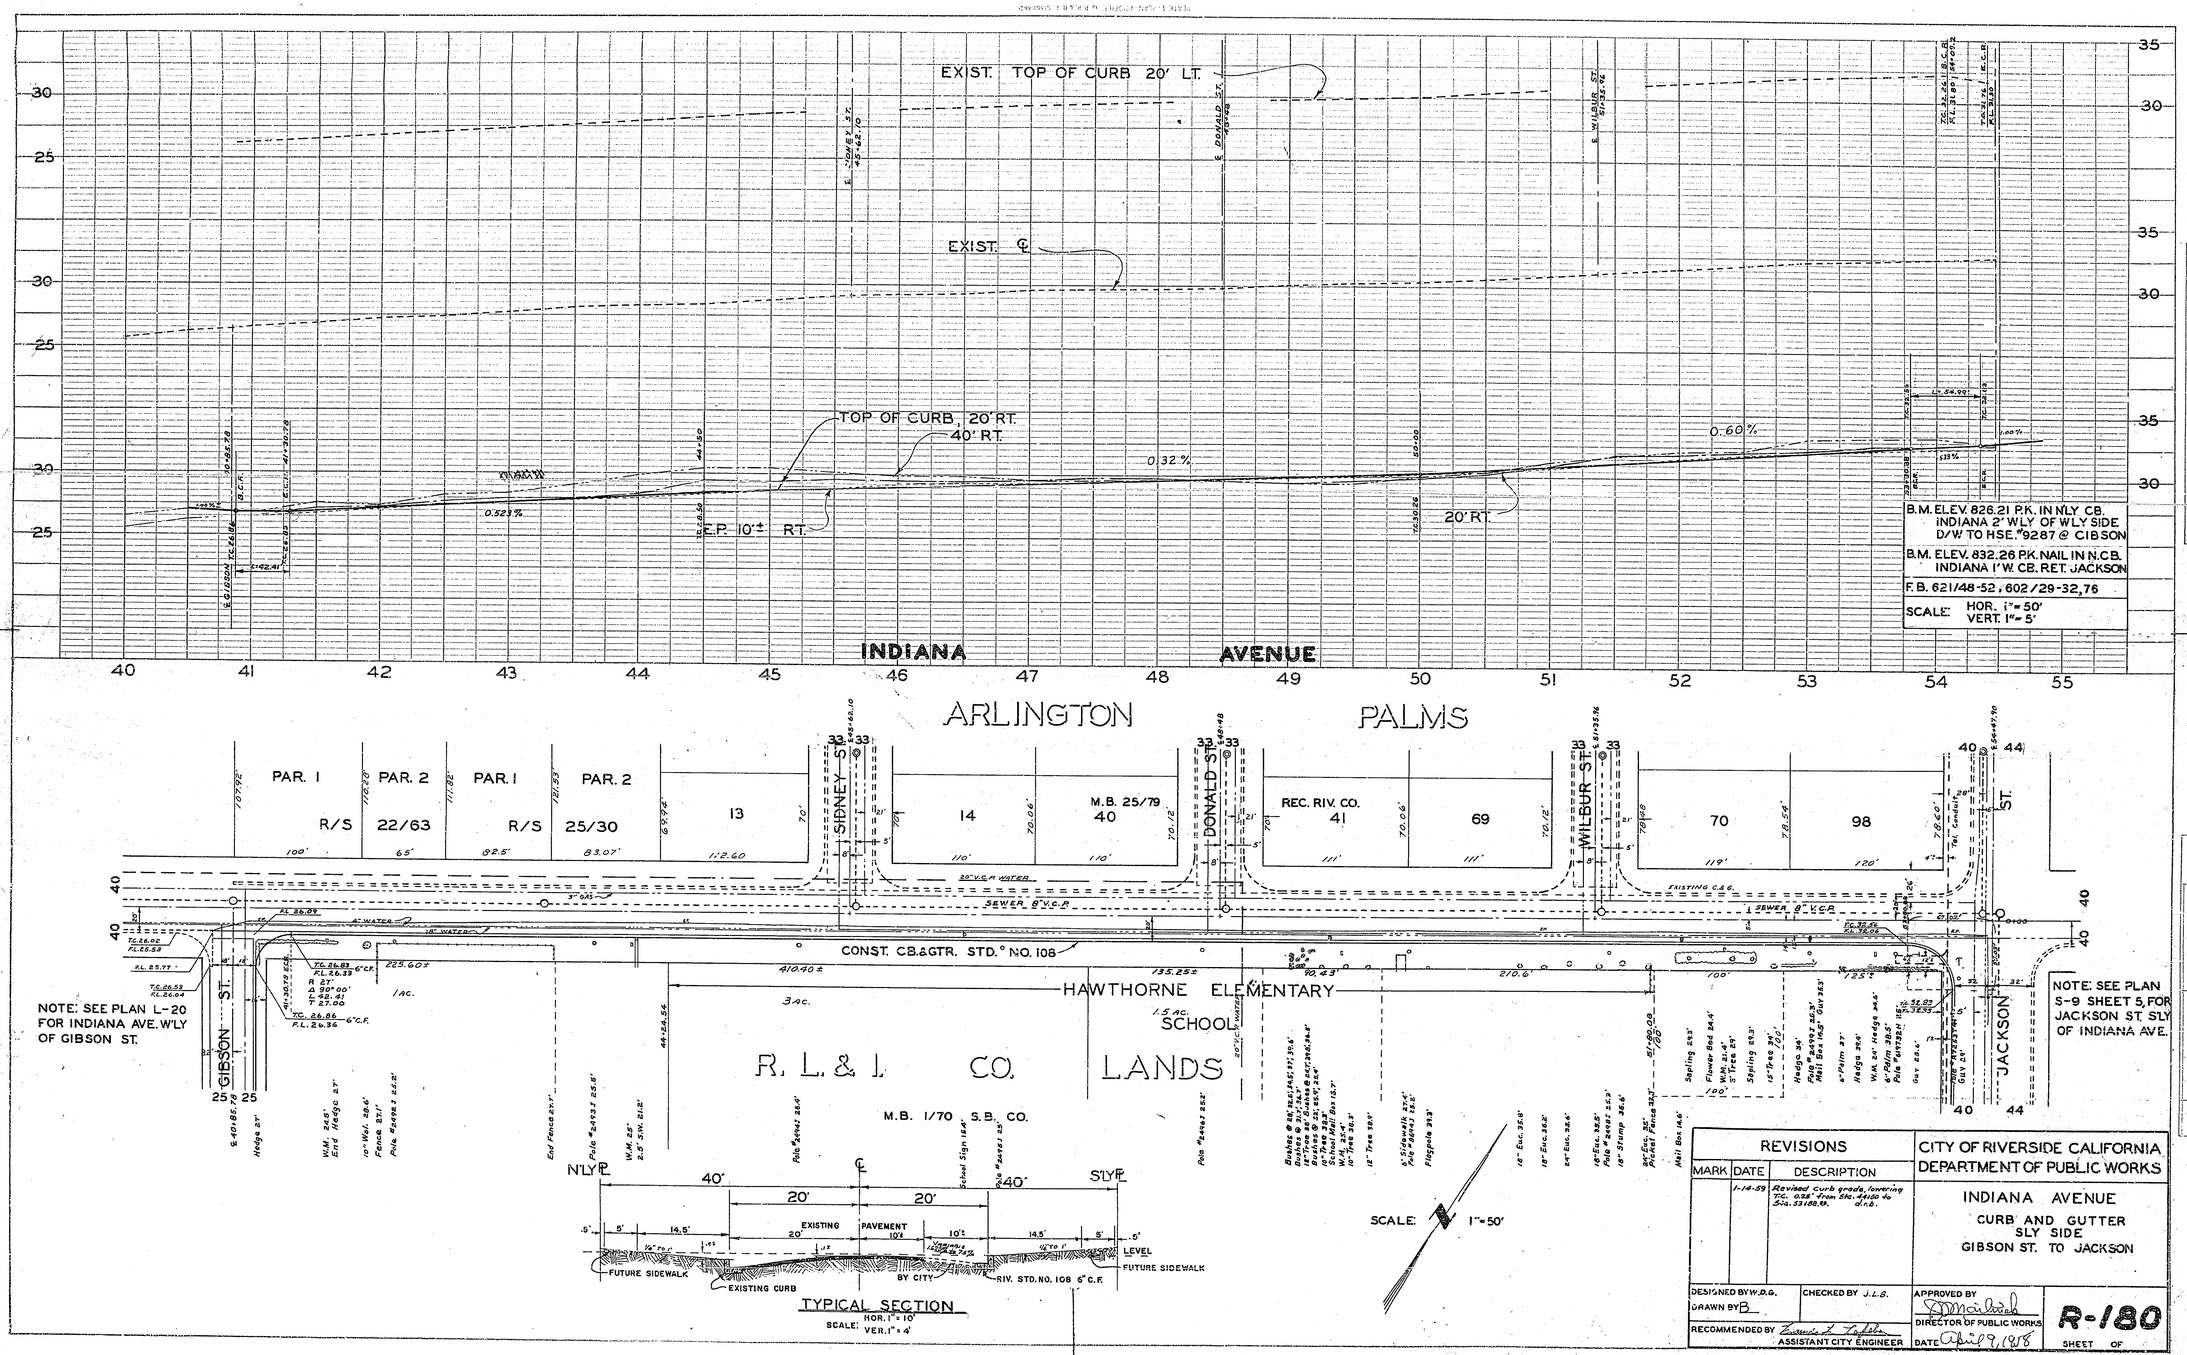

REVISIONS		
MARK	DATE	DESCRIPTION
	1-14-59	Revised curb grade, lowering T.C. 0.54' from Sta. 44+50 to 5+00. S3168.19. d.n.b.

CITY OF RIVERSIDE CALIFORNIA
DEPARTMENT OF PUBLIC WORKS

INDIANA AVENUE
CURB AND GUTTER
S'LY SIDE
GIBSON ST. TO JACKSON

DESIGNED BY W.D.G. CHECKED BY J.L.S.
DRAWN BY B
RECOMMENDED BY Francis T. Tufts ASSISTANT CITY ENGINEER
APPROVED BY DIRECTOR OF PUBLIC WORKS
DATE April 9, 1958

R-180
SHEET OF

PROFILE
SURVEYED
PLOTTED
NOTES
CROSSES CHECKED
TRACED
STRUCTURE NOTE FOR STATIONS

PLAN
SURVEYED
PLOTTED
TRACED
CROSSES CHECKED
ST. OF WAY CHECKED
NOTE BOOK
NO.