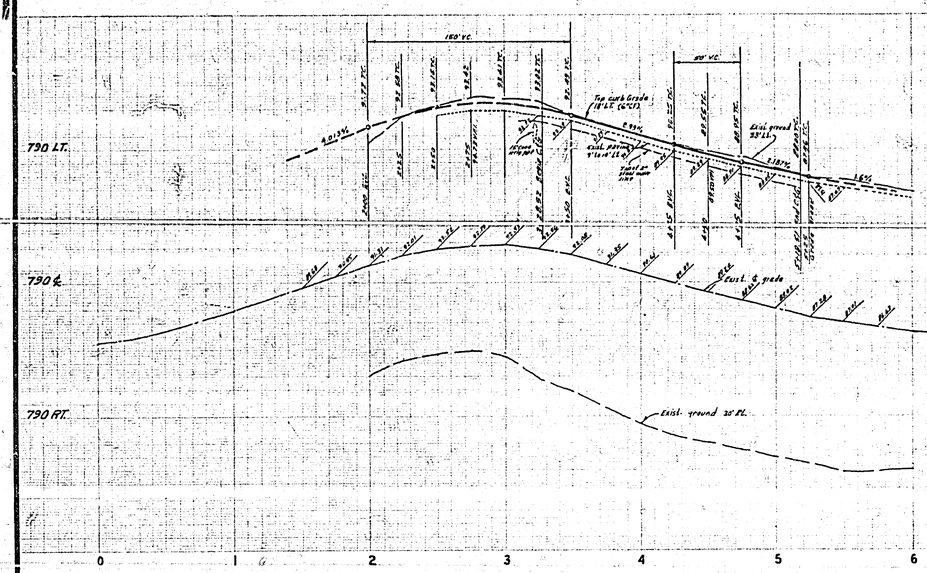

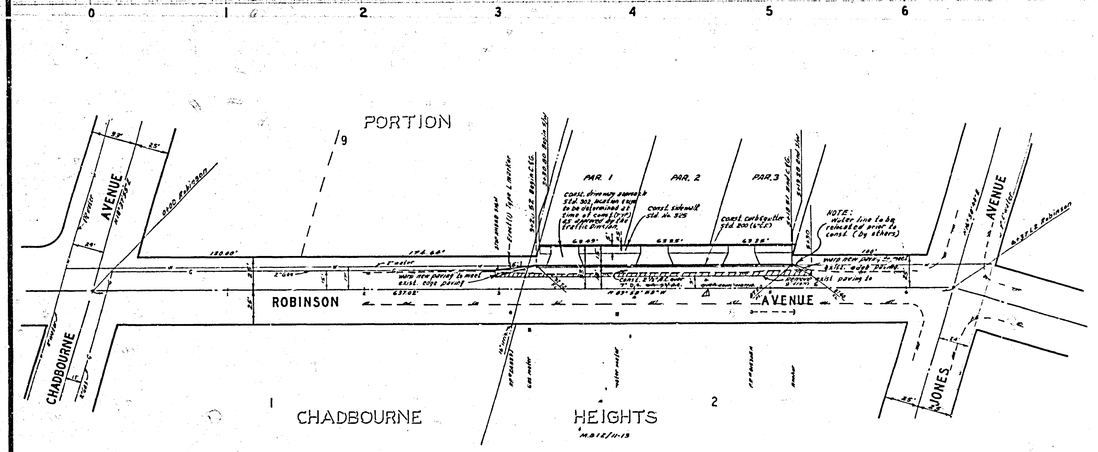

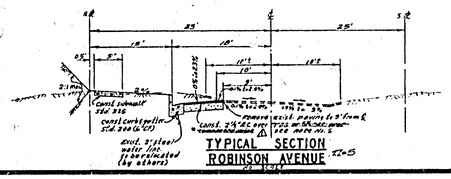

TYPICAL SECTION
ROBINSON AVENUE

BENCH MARK Elev. 776.683
R.R. Spike PP # 201683 @ the N.E. corner Jones & Chadbourne on P.B. 14/26

GENERAL NOTES

1. Construction shall be in accordance with the standard specifications for Public Works Construction 1973 edition and per City of Riverside Standard drawings.
2. All flagged elevations shall be stated in the field by the Engineer
3. It shall be the responsibility of the contractor to clean the right of way in accordance with the provisions of law as it effects each activity including irrigation lines and disportionances and at no cost to the City.
4. Curb and gutter to be stated at a 3' offset and at 25' intervals
5. Trim edge of exist. pavement where new pavement joins to a smooth straight line. Construct matching or paving as shown on plan & overlay paving as directed in the field to produce a smooth section.
6. The Subcontractor shall obtain for a soil test to be made by a soils engineer after the streets have been graded to rough grade. Depth of base material & A.C. paving shall be determined by the City of Riverside design standards & test procedures.

S.R. 867 R-31

ALBERT A. WEBB ASSOCIATES
CIVIL ENGINEERS
RIVERSIDE, CALIFORNIA
APPROVED BY [signature] DATE 4-26-75
R.E. No. 14084
W.O. 74-229 FOR: Tom W. Dixon P.B. 14-25
DESIGNED BY BEL DRAWN BY BEL CHECKED BY [illegible]

Approved by [signature] Chief Water Utility Engineer 2-7-75 Date

CITY OF RIVERSIDE, CALIFORNIA
PUBLIC WORKS DEPARTMENT

APPROVED BY	BY	DATE
PRINCIPAL ENGINEER		
PARK DEPARTMENT		
TRAFFIC DIVISION		
DIR. PUB. WKS. ENGR.		1-10

APPROVED BY [signature] DIRECTOR OF PUBLIC WORKS
DATE 1-13-75

*AS BUILT 4-16-75

STREET PLAN AND PROFILE
ROBINSON AVENUE
Between Chadbourne Ave. & Jones Ave
PARCEL MAP 205
SCALE: Horiz. 1"=40', Vert. 1"=4'

ACCOUNT No.
DRAWING NUMBER R-1801
SHEET 1 OF 1
74-229-A