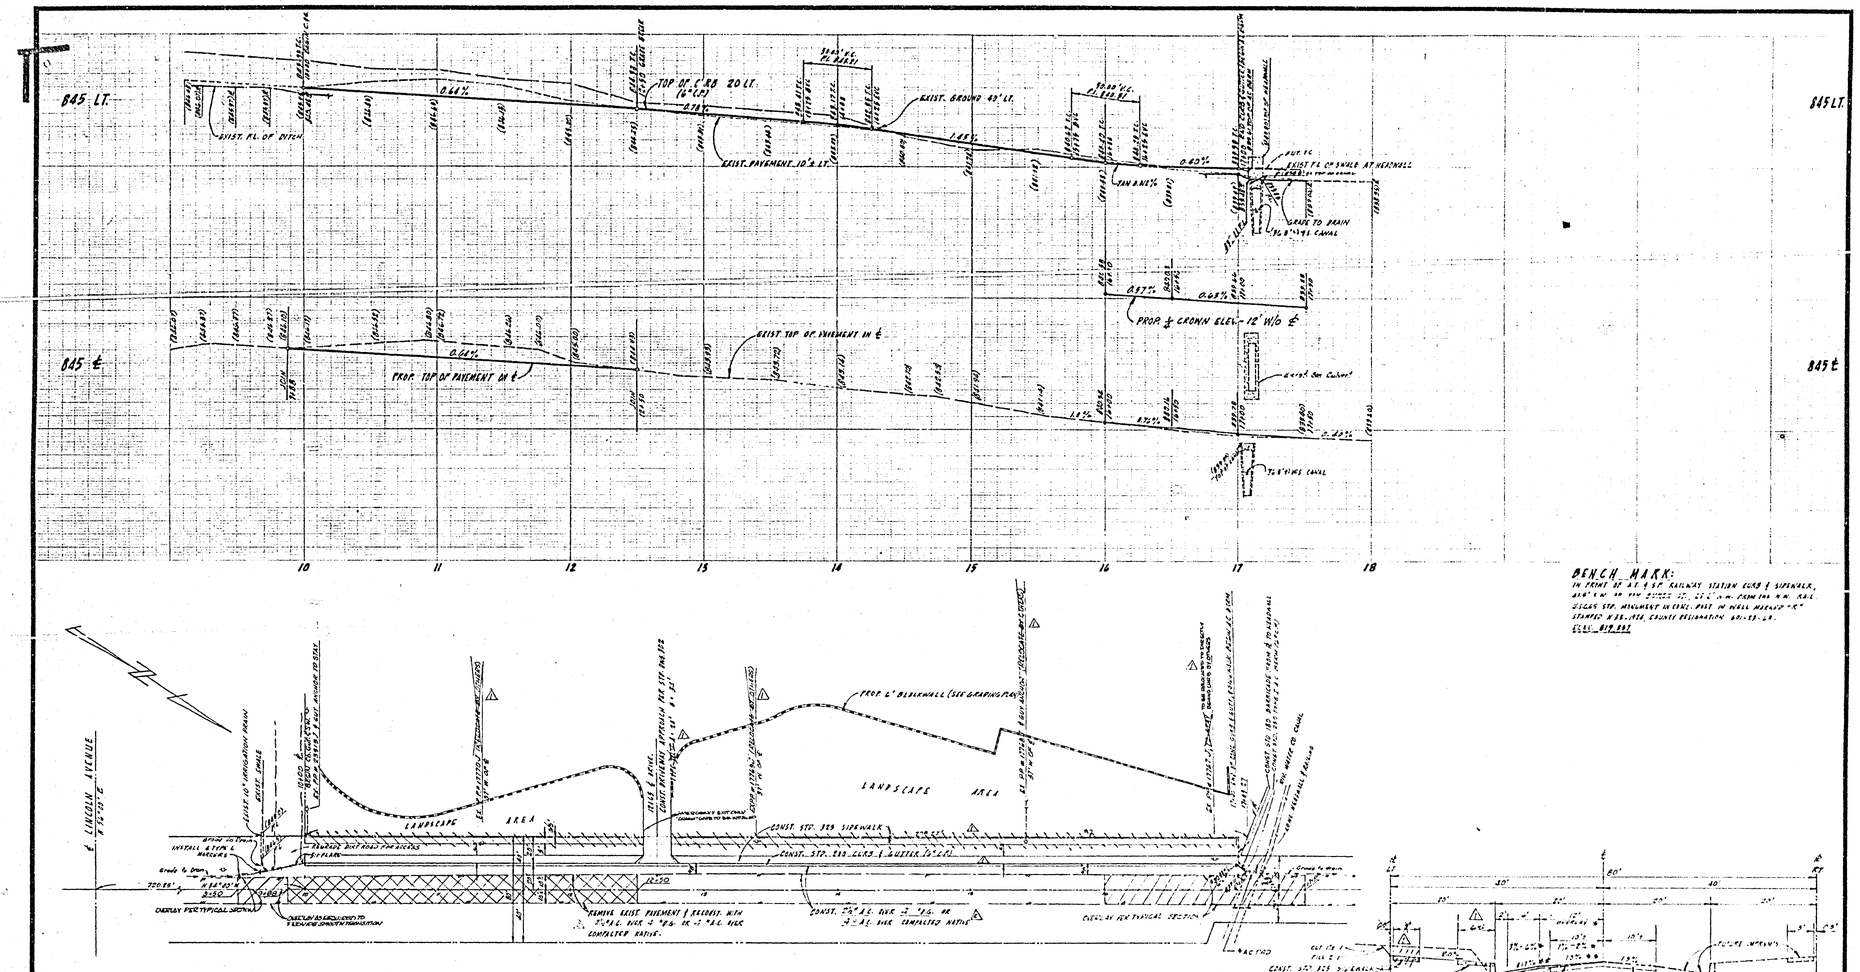

BENCH MARK:
IN FRONT OF A.T. & S.F. RAILWAY STATION CURB & SIDEWALK, 48.0' S.W. OF THE CENTER OF ... FROM THE N.W. R.R. DISCON. STP. MONUMENT IN CONC. POST IN WELL MARKED "K" STAMPED K-B-1958, CONNECT DESIGNATION 6N-13-L.B.
ELEV. 819.892

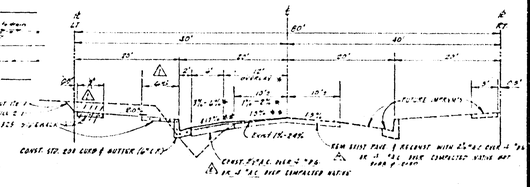

TYPICAL SECTION
NO SCALE

GENERAL NOTES:

1. CONSTRUCTION SHALL BE IN ACCORDANCE WITH THE STANDARD SPECIFICATIONS FOR PUBLIC WORKS CONSTRUCTION, 1975 EDITION AND THE CITY OF RIVERSIDE STD. DRAWINGS.
2. ALL FLOWLINE ELEVATIONS SHALL BE STAKED IN THE FIELD BY THE ENGINEER.
3. THE DEVELOPER SHALL ARRANGE FOR A SOIL TEST TO BE MADE BY A SOILS ENGINEER AFTER THE STREET HAS BEEN PREPARED TO ROUGH GRADE. DEPTH OF BASE MATERIAL AND A.C. PAVING SHALL BE DETERMINED BY THE CITY OF RIVERSIDE DESIGN STANDARDS AND TEST REQUIREMENTS.
4. CURB & GUTTER TO BE STAKED IN 5' OFFSET AND 25' INTERVALS.
5. TRIM EDGE OF EXISTING PAVEMENT WHERE NEW PAVEMENT JOINS TO A SMOOTH STRAIGHT LINE. CONVEYOR MATCH UP PAVING AS SHOWN ON THE PLANS AND OVERLAY PAVING AS DIRECTED IN THE FIELD TO PROVIDE A SMOOTH SECTION TRANSITION.
6. IT SHALL BE THE RESPONSIBILITY OF THE CONTRACTOR TO CLEAR THE RIGHT OF WAY IN ACCORDANCE WITH THE PROVISIONS OF LAW AS IT AFFECTS EACH UTILITY INCLUDING IRRIGATION LINES AND APPURTENANCES AND AT NO COST TO THE CITY.

GIBSON STREET

SR 862 Rev4

TOUPS CORPORATION
1010 North Main Street
Santa Ana, California 92701
Telephone (714) 835-4447

APPROVED: ... 4-7-75
RCE No. 24-6-68 DATE

MARK	REVISION	DATE
1	REVISED STREET TRACTION	2-7-75
2	REVISED TO REFLECT NO. CURB & GUTTER ON NORTH SIDE OF STREET	2-24-75

DESIGNED BY | DRAWN BY | CHECKED BY

CITY OF RIVERSIDE, CALIFORNIA
DEPARTMENT OF PUBLIC WORKS

APPROVED BY: OFFICE ENGINEER, MAINTENANCE DIVISION, TRAFFIC DIVISION, ASSISTANT CITY ENGINEER — BY — DATE 5-5-75

APPROVED BY: DIRECTOR OF PUBLIC WORKS — DATE 5-6-75

*AS BUILT 4-7-75 KPT

STREET PLAN AND PROFILE

GIBSON STREET
FROM TROPE ± W/O LINCOLN AVENUE TO RIVERSIDE WATER COMPANY CANAL
CONDITIONAL USE PERMIT C-16-169

HORIZ. SCALE: 1" = 40' | VERT. SCALE: 1" = 4'

PROJECT NO. R-1818
SHEET 1 OF 1
FILE NO.