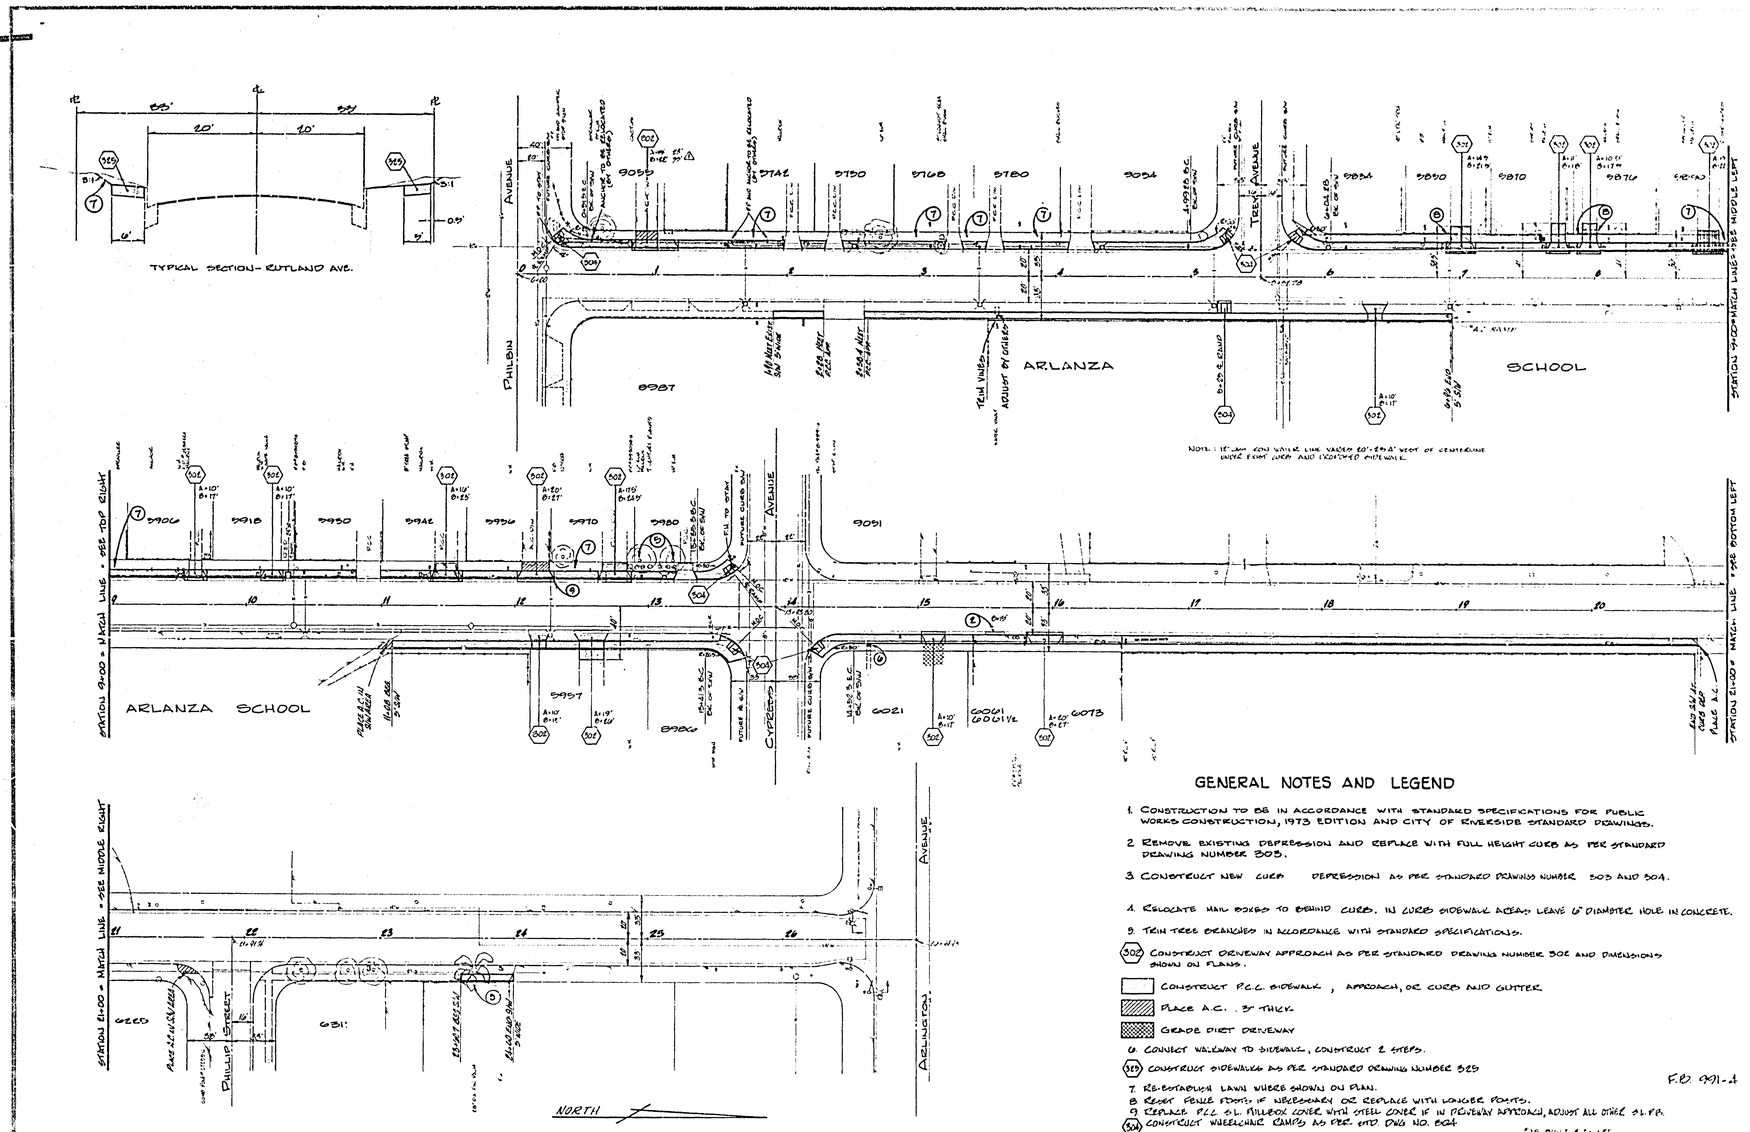

GENERAL NOTES AND LEGEND

1. CONSTRUCTION TO BE IN ACCORDANCE WITH STANDARD SPECIFICATIONS FOR PUBLIC WORKS CONSTRUCTION, 1973 EDITION AND CITY OF RIVERSIDE STANDARD DRAWINGS.
2. REMOVE EXISTING DEPRESSION AND REPLACE WITH FULL HEIGHT CURB AS PER STANDARD DRAWING NUMBER 303.
3. CONSTRUCT NEW CURB DEPRESSION AS PER STANDARD DRAWINGS NUMBER 303 AND 304.
4. RELOCATE MAIL BOXES TO BEHIND CURB. IN CURB SIDEWALK AREAS LEAVE 6" DIAMETER HOLE IN CONCRETE.
5. TRIM TREE BRANCHES IN ACCORDANCE WITH STANDARD SPECIFICATIONS.

(302) CONSTRUCT DRIVEWAY APPROACH AS PER STANDARD DRAWING NUMBER 302 AND DIMENSIONS SHOWN ON PLANS.

- CONSTRUCT P.C.C. SIDEWALK, APPROACH, OR CURB AND GUTTER
- PLACE A.C. 3" THICK
- GRADE DIRT DRIVEWAY

6. CONNECT WALKWAY TO SIDEWALK, CONSTRUCT 2 STEPS.

(325) CONSTRUCT SIDEWALKS AS PER STANDARD DRAWING NUMBER 325

7. RE-ESTABLISH LAWN WHERE SHOWN ON PLAN.
8. RESET FENCE POSTS IF NECESSARY OR REPLACE WITH LONGER POSTS.
9. REPLACE P.C.C. S.L. PULLBOX COVER WITH STEEL COVER IF IN DRIVEWAY APPROACH, ADJUST ALL OTHER S.L.P.B.

(304) CONSTRUCT WHEELCHAIR RAMPS AS PER STD. DWG NO. 304

F.B. 991-4

*AS BUILT 8 TO 1 FT

CITY OF RIVERSIDE PUBLIC WORKS DEPARTMENT 11-24-75	RUTLAND AVE. SIDEWALK PHILBIN AVE. to ARLINGTON 40	R-1826	