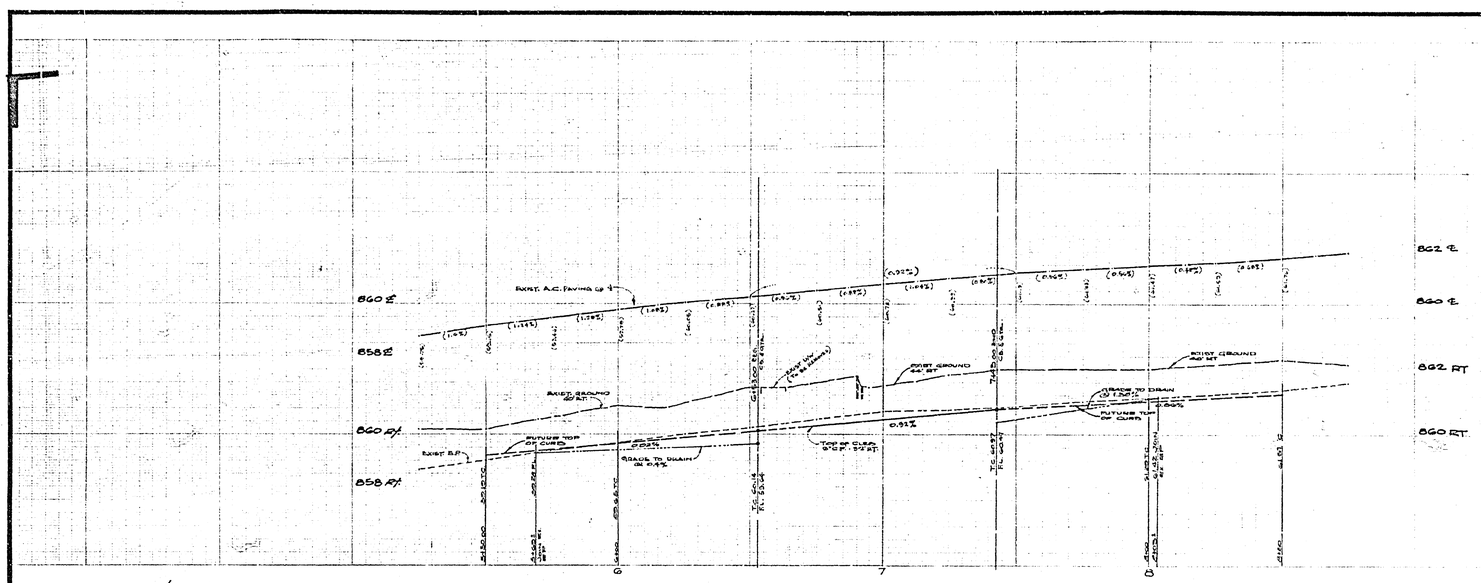

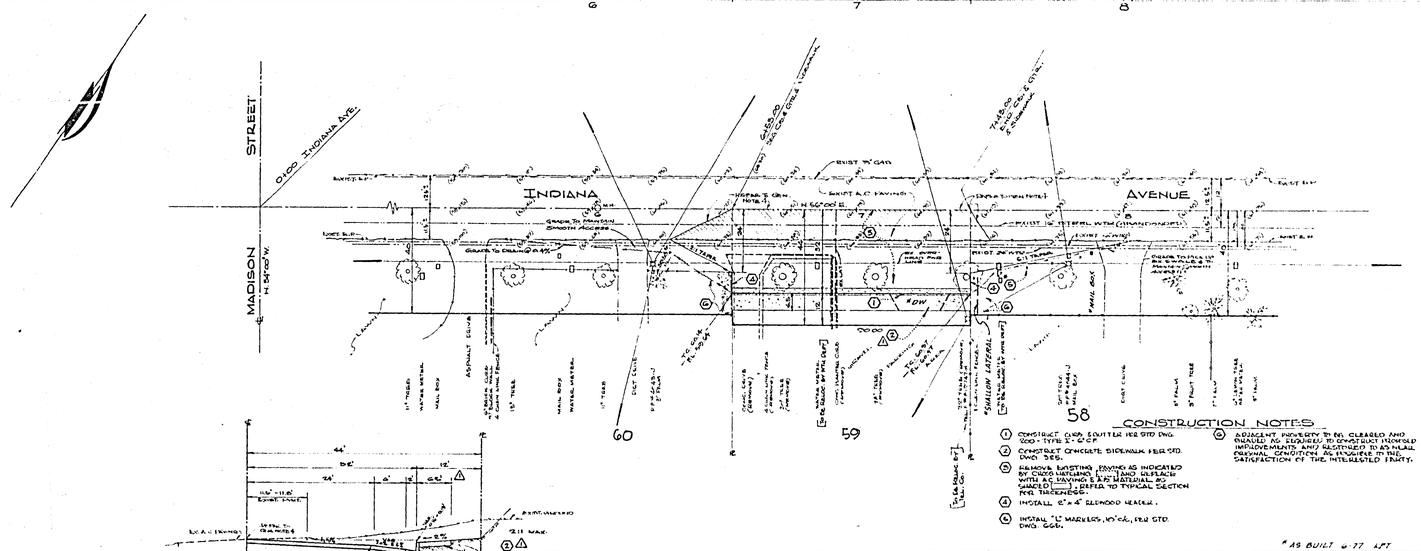

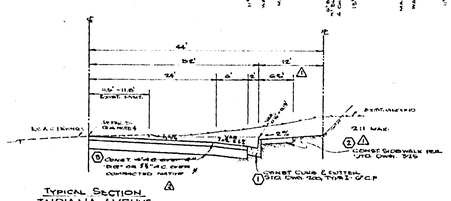

Typical Section
INDIANA AVENUE
NOT TO SCALE
T. L. 7

BENCH MARK:

B.M. 601-16-68 BRASS DISC IN CONC. FOOT SET IN CAPPED WELL, 25' S.E. OF S.E. FAIRWAY RAV AT WASHINGTON ST.
ELEV. 866.97

GENERAL NOTES

1. CONSTRUCTION SHALL BE IN ACCORDANCE WITH THE STANDARD SPECIFICATIONS FOR PUBLIC WORKS CONSTRUCTION, 1974 EDITION AND THE CITY OF RIVERSIDE STANDARD DRAWING.
2. IT SHALL BE THE RESPONSIBILITY OF THE CONTRACTOR TO CLEAR THE RIGHT OF WAY IN ACCORDANCE WITH THE PROVISIONS OF LAW AND ATTACH EACH UTILITY, INCLUDING IRRIGATION LINES AND APPURTENANCES, AND AT NO COST TO THE CITY.
3. THE DEVELOPER SHALL ARRANGE FOR A SOIL TEST TO BE MADE BY SOILS ENGINEER AFTER THE STREETS HAVE BEEN PREPARED TO ROUGH GRADE. DEPTH OF BASE MATERIAL AND A.C. PAVING SHALL BE DETERMINED BY CITY OF RIVERSIDE DESIGN STANDARDS AND TEST PROCEDURES.
4. TRIM EDGE OF EXISTING PAVEMENT WHERE NEW PAVEMENT JOINS EXISTING TO A SMOOTH STRAIGHT LINE. CONSTRUCT MATCH-UP PAVING AS SHOWN ON PLAN AND OVERLAY PAVING AS DIRECTED IN FIELD TO PRODUCE SMOOTH SECTION. PRIVATE ENGINEER ESTIMATES OVERLAY TO BE 2" THICK.
5. CURB AND GUTTER SHALL BE STAKED WITH 3" STAKES AT 25' INTERVALS, UNLESS OTHERWISE AUTHORIZED BY PUBLIC WORKS DEPT. CITY OF RIVERSIDE.
6. ALL FLAGGED ELEVATIONS SHALL BE STAKED IN THE FIELD BY THE ENGINEER.
7. LOCATION OF DRIVEWAY APPROACHES PER STD. DWG. 207, TO BE DETERMINED AT TIME OF CONSTRUCTION AND APPROVED BY THE TRAFFIC ENGINEER.
8. EXISTING ELEVATIONS ARE INDICATED THUSLY (4104).

CONSTRUCTION NOTES

1. CONSTRUCT CURB, GUTTER PER STD DWG. 200 - TYPE 2-6" C.O.P.
2. CONSTRUCT CONCRETE SIDEWALK PER STD. DWG. 520.
3. REMOVE EXISTING PAVING AS INDICATED BY CROSS HATCHING [ ] AND REPLACE WITH AC PAVING & B.P. MATERIAL AS SHOWN [ ]. REFER TO TYPICAL SECTION FOR THICKNESS.
4. INSTALL 6" x 4" REDWOOD HEADER.
5. INSTALL "L" MARKERS, 10' O.C., PER STD. DWG. 506.
6. ADJACENT PROPERTY TO BE CLEARED AND RUBBLE AS ENDANGERED BY CONSTRUCTION IMPROVEMENTS MAY BE DISPOSED TO AS NEAR DESIRABLE SITE AS PRACTICABLE TO THE SATISFACTION OF THE INTERESTED PARTY.

"AS BUILT" 77 LFT

ALBERT A. WEBB ASSOCIATES CIVIL ENGINEERS RIVERSIDE, CALIFORNIA APPROVED BY [signature] DATE 5/17/74 R.E. No. 0476		CITY OF RIVERSIDE, CALIFORNIA PUBLIC WORKS DEPARTMENT APPROVED BY / BY / DATE PRINCIPAL ENGINEER / PARK DEPARTMENT / TRAFFIC DIVISION / CHIEF PUB. WKS. ENGR.	STREET IMPROVEMENT PLAN INDIANA AVENUE SE'LY SIDE FROM 655' TO 745' NE'LY OF MADISON STREET ZONING CASE R-24-134 APPROVED BY [signature] DIRECTOR OF PUBLIC WORKS DATE 11-26-75	ACCOUNT No. DRAWING NUMBER R-1833 SHEET 1 OF 1
	MARK / REVISIONS / APPR. / DATE		SCALE: 1" = 20' HORIZ. 1" = 2' VERT.	74-126 A
W.O. 74-126 FOR: C.L. SMITH COMPANY F.B. 434/94	DESIGNED BY D.S.R. DRAWN BY E.P.R. CHECKED BY ZDM.			