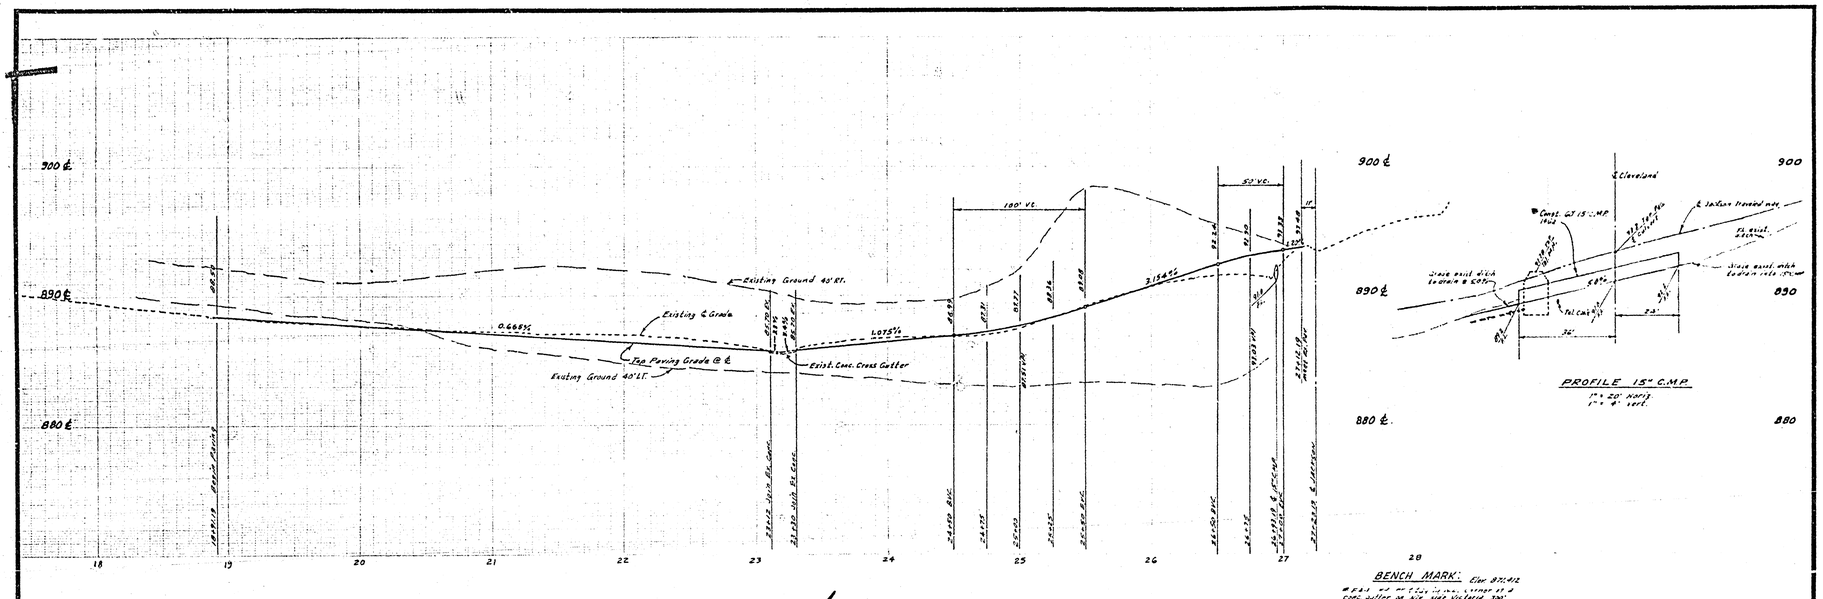

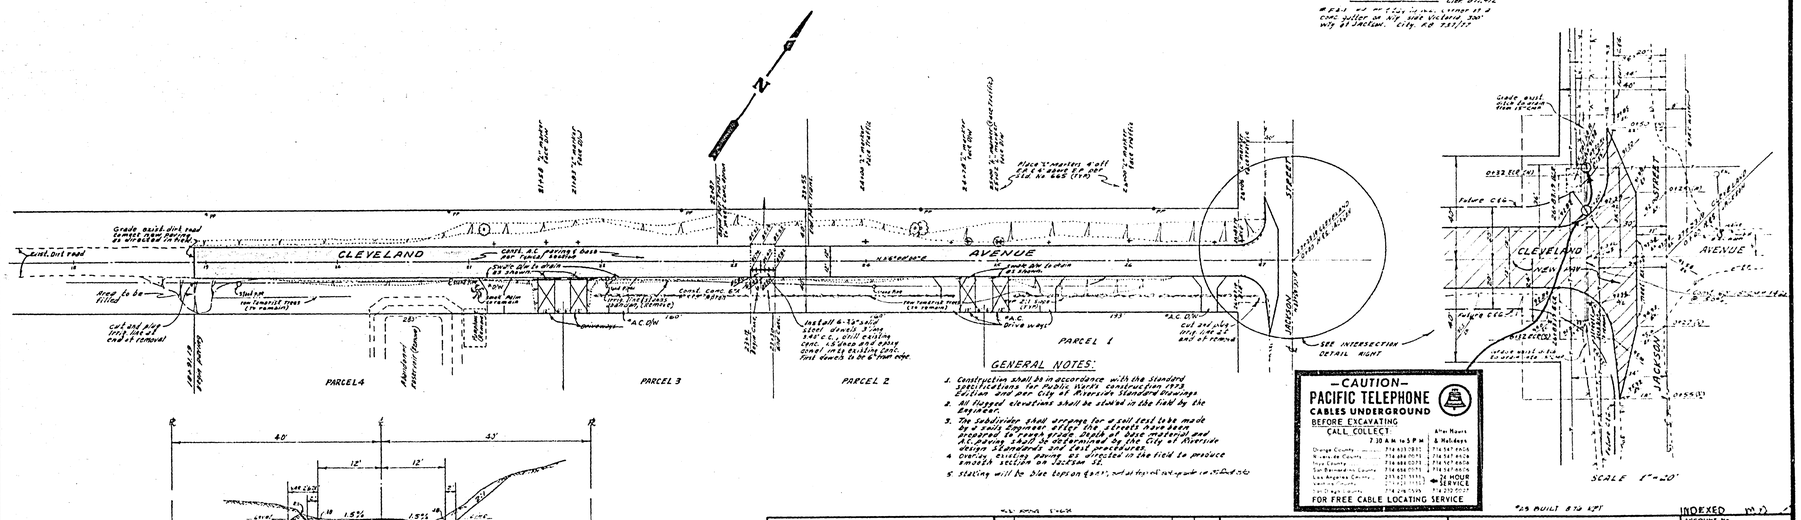

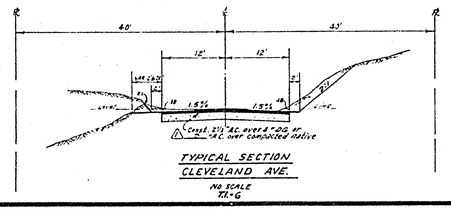

TYPICAL SECTION
CLEVELAND AVE.
NO SCALE
TX-6

GENERAL NOTES:

1. Construction shall be in accordance with the standard specifications for public works construction 1973 edition and per City of Riverside standard drawings
2. All flagged elevations shall be staked in the field by the Engineer.
3. The subdivider shall arrange for a soil test take made by a soils engineer after the streets have been graded to expose actual grade of base material and to obtain a report to be determined by the City of Riverside design standards and soil engineers.
4. Overlay existing paving as directed in the field to produce smooth section on centerline.
5. Striping will be blue lapidary paint; and all traffic markings to be installed to

—CAUTION—
PACIFIC TELEPHONE
CABLES UNDERGROUND
BEFORE EXCAVATING
CALL COLLECT
7:30 A.M. to 5 P.M.

		After Hours & Holidays
Orange County	714 635-7810	714 547-6606
Riverside County	714 684-0575	714 547-6606
Ventura County	714 484-2171	714 547-6606
San Bernardino County	714 884-0575	714 547-6606
Los Angeles County	213 625-7575	213 547-6606
Santa Barbara County	714 963-7575	714 547-6606
Imperial County	714 344-7404	714 232-7117

24 HOUR SERVICE
FOR FREE CABLE LOCATING SERVICE

"AS BUILT" STD. 127

INDEXED

ALBERT A. WEBB ASSOCIATES CIVIL ENGINEERS RIVERSIDE, CALIFORNIA APPROVED BY [signature] DATE 9/10/75 R.E. No. 9876	CITY OF RIVERSIDE, CALIFORNIA PUBLIC WORKS DEPARTMENT APPROVED BY [signature] DIRECTOR OF PUBLIC WORKS DATE 11/12/75
STREET PLAN AND PROFILE CLEVELAND AVENUE P.M. 203	ACCOUNT No. DRAWING NUMBER R-1845 SHEET 1 OF 1
SCALE 1" = 20' HORIZ. 1" = 4' VERT.	74-198-A

IRRIGATION LINE REMOVAL APPROVED BY GAGE CANAL CO.
11/10/75 DATE [signature]

W.O. 74-198 FOR: Birch Const. Co. P.M. 1437

DESIGNED BY RC DRAWN BY RC CHECKED BY