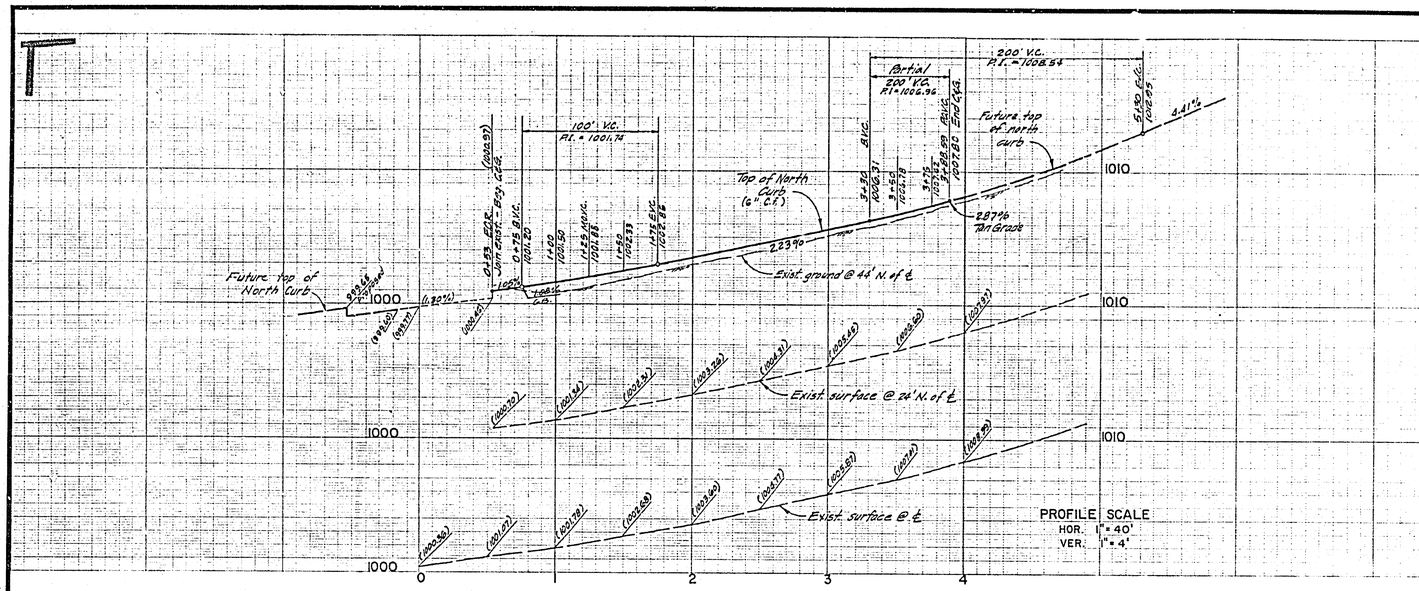


PROFILE SCALE
HOR. 1" = 40'
VER. 1" = 4'

BENCH MARK Elev. 977.27
Top of N.W. bolt at base of pedestrian signal control button stand on N.W. corner of Blaine St. & Iowa Ave.
C.R.F.B. 96/19

## CONSTRUCTION NOTES & QUANTITY ESTIMATES

| | | | |
|---|---|---|---|
| 1 | Remove exist. pavement | 2710 | S.F. |
| 2 | Const. 4" A.C. over 10" D.G. | 2030 | S.F. |
| 3 | Const. P.C.C. Curb & Gutter, type I, 3" C.F., per Std. Dwg. No. 200 | 338 | L.F. |
| 4 | Const. P.C.C. Sidewalk per Std. Dwg. No. 325 | 1540 | S.F. |
| 5 | Const. P.C.C. Driveway Approach per Std. Dwg. No. 302 | 338 | S.F. |
| 6 | Saw cut exist. pavement | | |

## GENERAL NOTES

1. All work done shall be in accordance with "Standard Specifications for Public Works Construction, 1973 Edition, and City of Riverside Standard Drawings.
2. The Contractor shall be responsible for protecting all utility lines and existing improvements; and shall repair or replace in kind at his own expense any lines or improvements damaged by his operations during construction.
3. The Contractor shall remove or crush in place the existing 8" irrigation line shown 35'± from ℄ Blaine St. Plug exposed end with mortar.
4. It shall be the responsibility of the contractor to clear the Right of Way in accordance with the provisions of law as it affects each utility including irrigation lines and appurtenances and at no cost to the City.
5. Trim edge of exist. pavement after new pavement joins to a straight, straight line. Construct starter cut curbs as shown on plan and overlay paving as directed in the field to produce a smooth section.
6. Curb and gutter shall be staked with 3' offsets at 25' intervals.
7. Contractor is to verify existing sewer elevation prior to construction.
8. Quantities shown are for information only and the City of Riverside is not responsible for their accuracy.

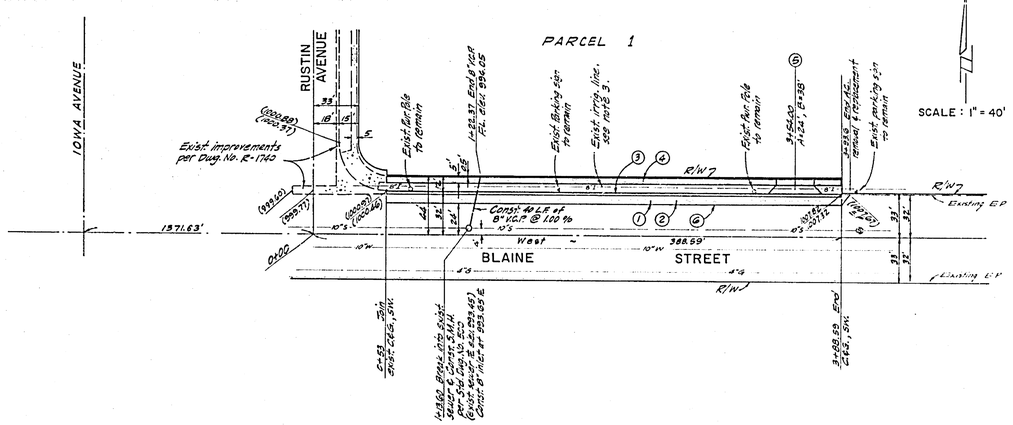


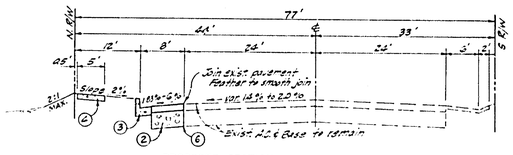


PROPOSED SECTION - BLAINE STREET
T.I. = 7

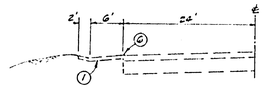


EXISTING SECTION

TYPICAL SECTION - BLAINE ST.

"AS BUILT 3-77 H.T.

THE GAGE CANAL COMPANY
APPROVED BY C.C. Hare DATE 12/5/75

PREPARED BY...
L.D. KING ENGINEERING CO., INC.
187 W. ORANGETHORPE AVE. SUITE E
PLACENTIA, CA. (714) 993-6060
Ernest Tofanoff RCE 23056 DATE 4 Dec 75

MARK REVISIONS APP. DATE
DESIGNED BY DRAWN BY CHECKED BY

CITY OF RIVERSIDE, CALIFORNIA
DEPARTMENT OF PUBLIC WORKS

| APPROVED BY | BY | DATE |
|---|---|---|
| OFFICE ENGINEER | | |
| PARK DEPARTMENT | | |
| TRAFFIC DIVISION | | |
| ASSISTANT CITY ENGR. | | 12-16 |

APPROVED BY
DIRECTOR OF PUBLIC WORKS
DATE 12-16-75

PLAN AND PROFILE
BLAINE STREET
RUSTIN AVE. TO 388' EASTERLY
P.M. 256

HORIZ. SCALE: 1" - 40' VERT. SCALE: 1" - 4'

PROJECT NO. R-1847
SHEET 1 OF 1
FILE NO.