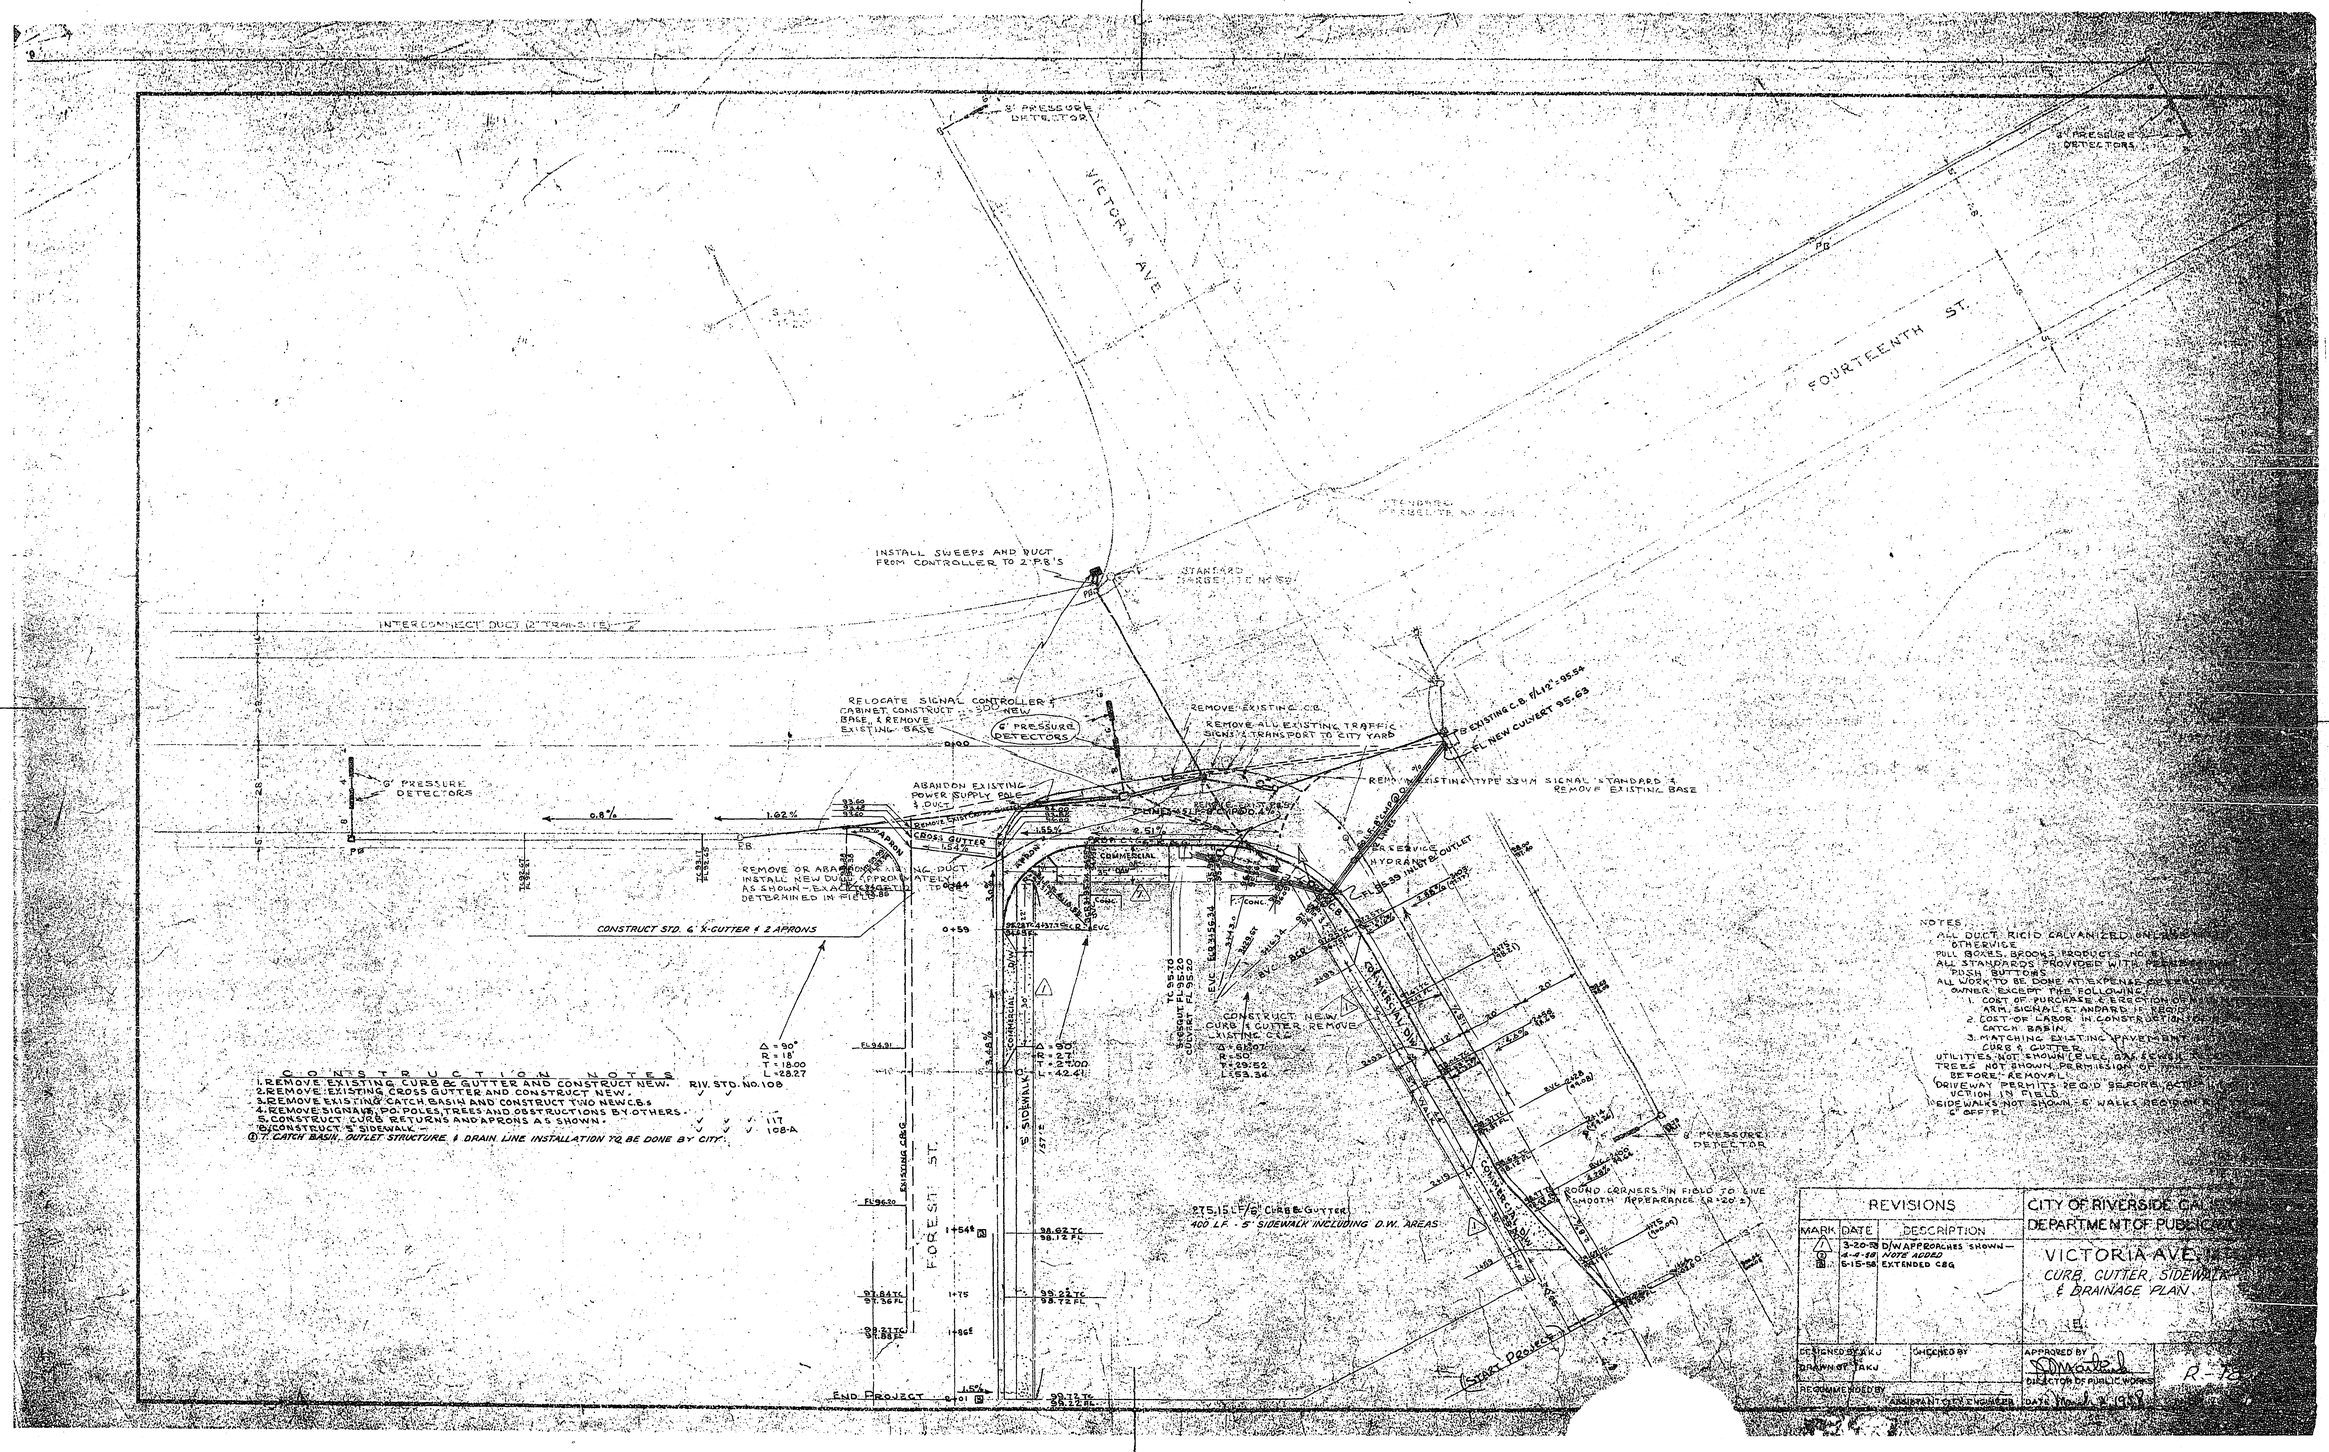

VICTORIA AVE
FOURTEENTH ST.
FOREST ST.
8" PRESSURE DETECTOR
6" PRESSURE DETECTORS
INSTALL SWEEPS AND DUCT FROM CONTROLLER TO 2 P.B.'S
INTERCONNECT DUCT (2" TRANSITE)
RELOCATE SIGNAL CONTROLLER & CABINET, CONSTRUCT NEW BASE, & REMOVE EXISTING BASE
REMOVE EXISTING C.B.
REMOVE ALL EXISTING TRAFFIC SIGNS & TRANSPORT TO CITY YARD
ABANDON EXISTING POWER SUPPLY POLE & DUCT
CROSS GUTTER
REMOVE OR ABANDON EXISTING DUCT. INSTALL NEW DUCT APPROXIMATELY AS SHOWN - EXACT DETERMINED IN FIELD
CONSTRUCT STD. 6' X-GUTTER & 2 APRONS
CONSTRUCT NEW CURB & GUTTER. REMOVE EXISTING C.B.
275.15 LF/6" CURB & GUTTER
400 LF - 5' SIDEWALK INCLUDING D.W. AREAS
ROUND CORNERS IN FIELD TO GIVE SMOOTH APPEARANCE (R=20'±)
START PROJECT
END PROJECT
NOTES
ALL DUCT RIGID GALVANIZED UNLESS OTHERWISE
PULL BOXES, BROOKS PRODUCTS NO. 8
ALL STANDARDS PROVIDED WITH PEDESTRIAN PUSH BUTTONS
ALL WORK TO BE DONE AT EXPENSE OF OWNER EXCEPT THE FOLLOWING:
1. COST OF PURCHASE & ERECTION OF ARM, SIGNAL STANDARD IF REQ'D
2. COST OF LABOR IN CONSTRUCTION OF CATCH BASIN
3. MATCHING EXISTING PAVEMENT CURB & GUTTER
UTILITIES NOT SHOWN (ELEC. GAS SEWER)
TREES NOT SHOWN, PERMISSION OF OWNER BEFORE REMOVAL
DRIVEWAY PERMITS REQ'D BEFORE ACTION IN FIELD
SIDEWALKS NOT SHOWN. 5' WALKS REQ'D ON 6" OFF PL.
CONSTRUCTION NOTES
1. REMOVE EXISTING CURB & GUTTER AND CONSTRUCT NEW. RIV. STD. NO. 108
2. REMOVE EXISTING CROSS GUTTER AND CONSTRUCT NEW.
3. REMOVE EXISTING CATCH BASIN AND CONSTRUCT TWO NEW C.B.s
4. REMOVE SIGNALS, PO. POLES, TREES AND OBSTRUCTIONS BY OTHERS.
5. CONSTRUCT CURB RETURNS AND APRONS AS SHOWN. 117
6. CONSTRUCT 5' SIDEWALK 108-A
7. CATCH BASIN, OUTLET STRUCTURE & DRAIN LINE INSTALLATION TO BE DONE BY CITY.
REVISIONS
MARK DATE DESCRIPTION
3-20-58 D/W APPROACHES SHOWN
4-4-58 NOTE ADDED
5-15-58 EXTENDED C&G
CITY OF RIVERSIDE CAL
DEPARTMENT OF PUBLIC
VICTORIA AVE.
CURB, GUTTER, SIDEWALK & DRAINAGE PLAN
DESIGNED BY AKJ
DRAWN BY AKJ
CHECKED BY
APPROVED BY
DIRECTOR OF PUBLIC WORKS
RECOMMENDED BY
ASSISTANT CITY ENGINEER
DATE March 2, 1958
R-18