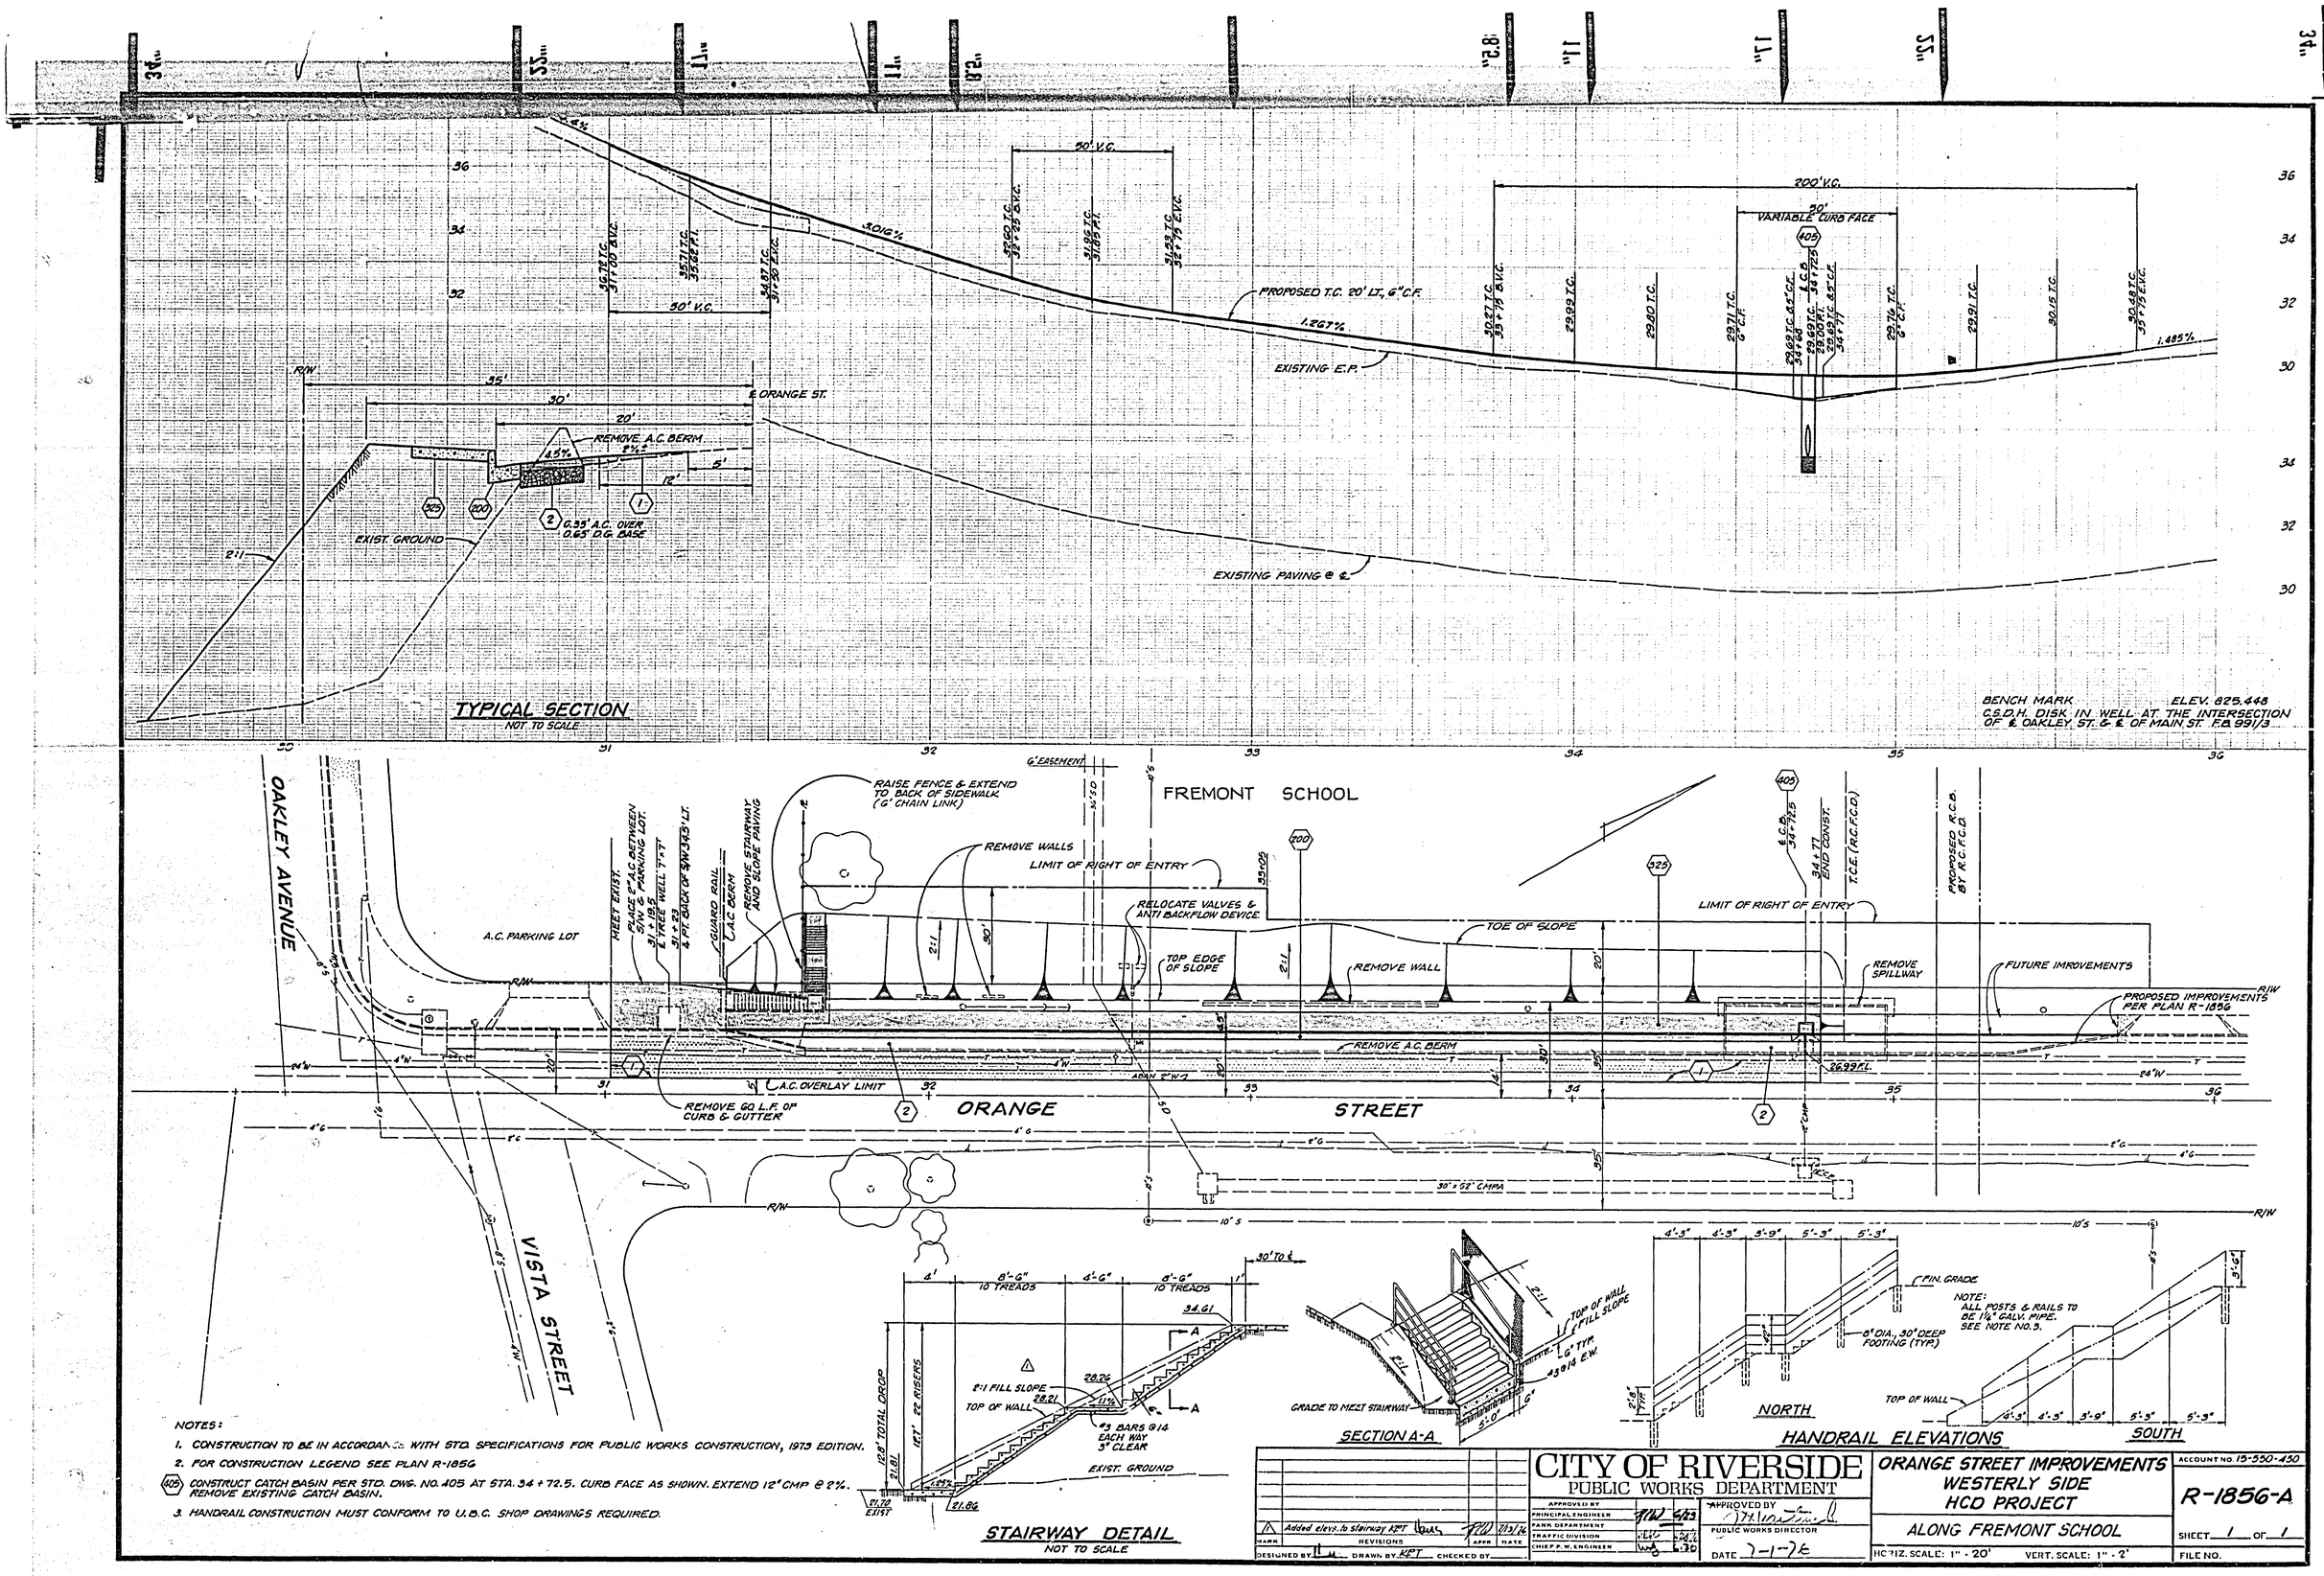

NOTES:

1. CONSTRUCTION TO BE IN ACCORDANCE WITH STD. SPECIFICATIONS FOR PUBLIC WORKS CONSTRUCTION, 1973 EDITION.
2. FOR CONSTRUCTION LEGEND SEE PLAN R-1856
(405) CONSTRUCT CATCH BASIN PER STD. DWG. NO. 405 AT STA. 34 + 72.5. CURB FACE AS SHOWN. EXTEND 12" CMP @ 2%. REMOVE EXISTING CATCH BASIN.
3. HANDRAIL CONSTRUCTION MUST CONFORM TO U.B.C. SHOP DRAWINGS REQUIRED.

MARK	REVISIONS	APPR.	DATE
1	Added elevs. to stairway KPT		7/13/76

DESIGNED BY [illegible] DRAWN BY KPT CHECKED BY

CITY OF RIVERSIDE
PUBLIC WORKS DEPARTMENT

APPROVED BY
PRINCIPAL ENGINEER
PARK DEPARTMENT
TRAFFIC DIVISION
CHIEF P.W. ENGINEER

APPROVED BY
PUBLIC WORKS DIRECTOR
DATE 7-1-76

ORANGE STREET IMPROVEMENTS
WESTERLY SIDE
HCD PROJECT
ALONG FREMONT SCHOOL

HORIZ. SCALE: 1" - 20' VERT. SCALE: 1" - 2'

ACCOUNT NO. 15-550-450
R-1856-A
SHEET 1 OF 1
FILE NO.