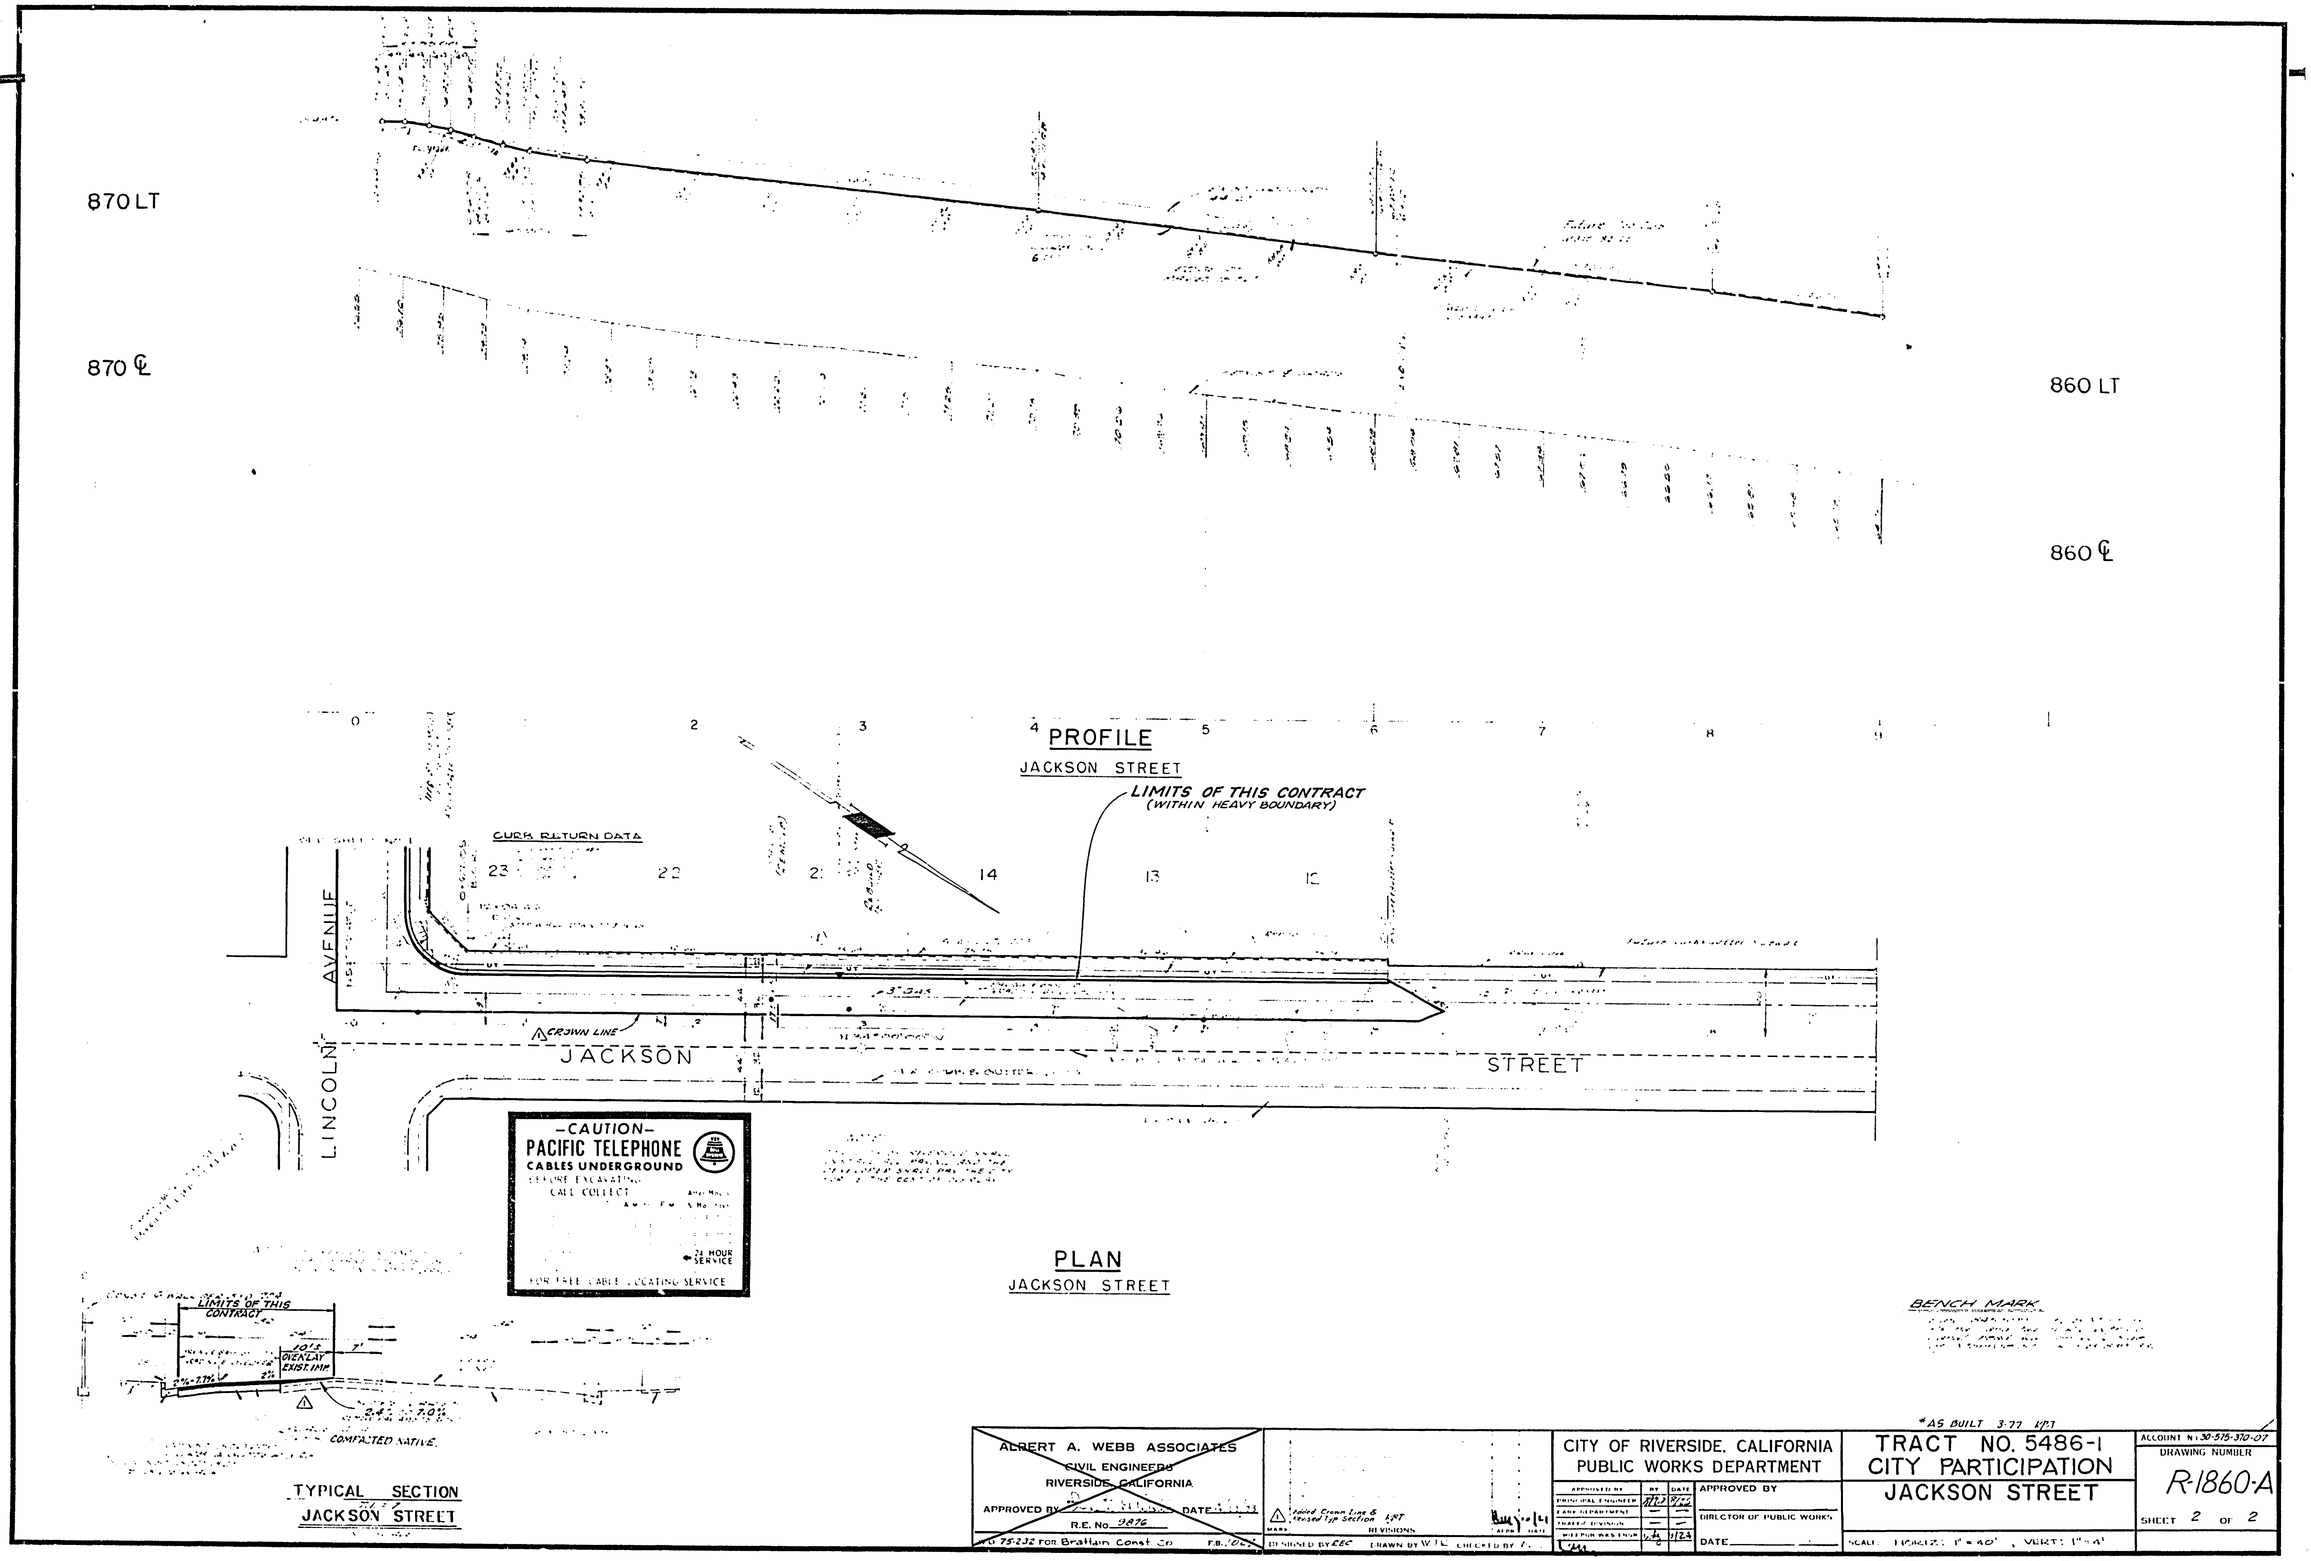

*AS BUILT 3-77 KPT

ALBERT A. WEBB ASSOCIATES CIVIL ENGINEERS RIVERSIDE, CALIFORNIA APPROVED BY ____ DATE ____ R.E. No. 9876 W.O. 75-232 FOR Brattain Const. Co. F.B. 1064	Added Crown Line & Revised Typ Section KPT MARK REVISIONS APPR DATE DESIGNED BY EEC DRAWN BY W.I.C. CHECKED BY	CITY OF RIVERSIDE, CALIFORNIA PUBLIC WORKS DEPARTMENT APPROVED BY / BY / DATE PRINCIPAL ENGINEER / 8/12/2 / 8/12/2 CARE DEPARTMENT / — / — TRAFFIC DIVISION / — / — MIT FOR WKS ENGR / 1/24 / 1/24 APPROVED BY DIRECTOR OF PUBLIC WORKS DATE ____	TRACT NO. 5486-1 CITY PARTICIPATION JACKSON STREET SCALE: HORIZ: 1" = 40', VERT: 1" = 4'

ACCOUNT No. 30-575-370-07
DRAWING NUMBER
R-1860-A
SHEET 2 OF 2

ADAPTED FROM PLAN R-1860

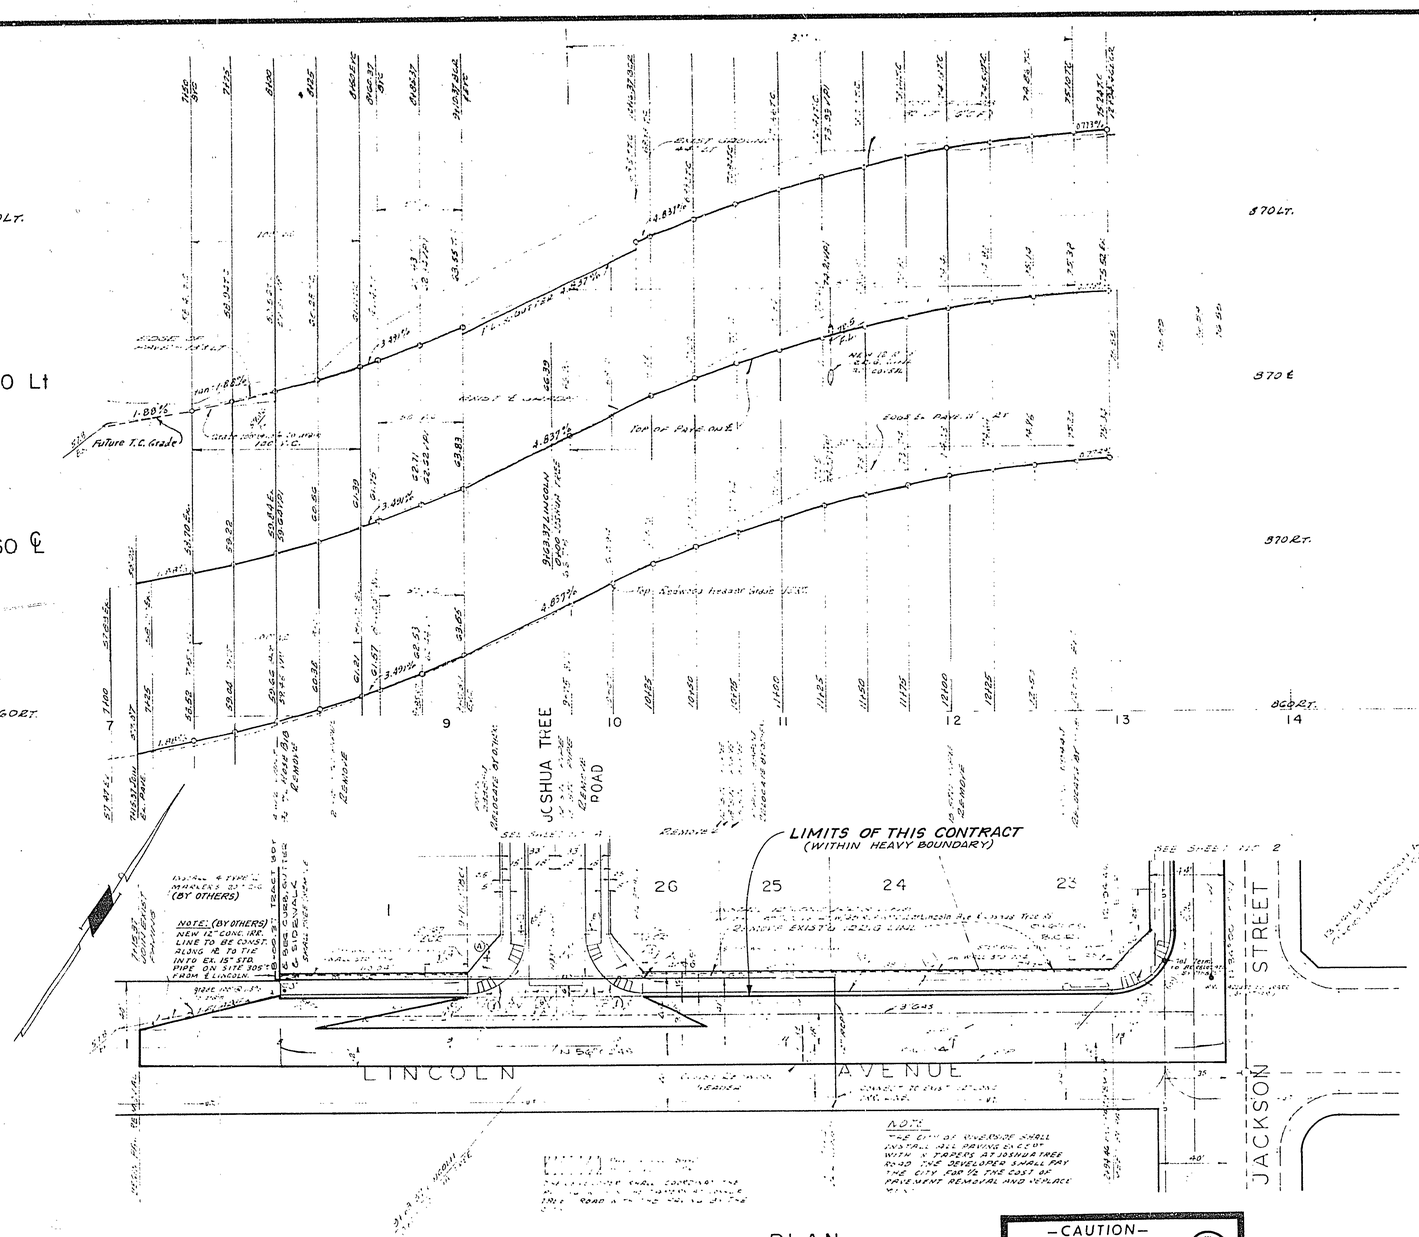

PLAN

LINCOLN AVENUE

CURB RETURN DATA

	A			
	30.00'	35'	35.00'	53.05'
	30.00'	35'	35.00'	53.05'

BENCH MARK

CONSTRUCTION TO BE IN ACCORDANCE WITH STANDARD SPECIFICATIONS FOR PUBLIC WORKS CONSTRUCTION, 1976 EDITION.

NOTE:

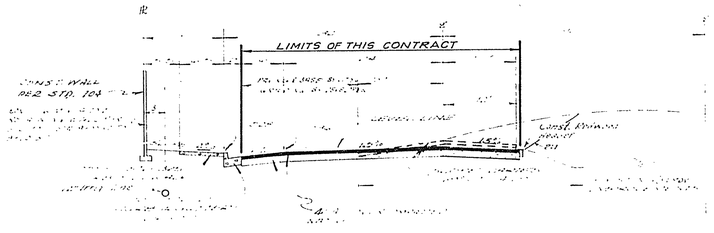

TYPICAL SECTION

LINCOLN AVENUE

NO SCALE

—CAUTION—
PACIFIC TELEPHONE
CABLES UNDERGROUND
BEFORE EXCAVATING
CALL COLLECT
7:30 A.M. to 5 P.M.
After Hours & Holidays
24 HOUR SERVICE
FOR FREE CABLE LOCATING SERVICE

~~NOTE:~~
~~Contractor to contact Ellsworth Chattlee, 9215 Lincoln Ave. 689-1547 or Stanley Chattlee, 5572 Jurupa Ave. 689-9534, 72 hours prior to const. of irrigation line.~~

IRRIG. LINE CONST. APPROVAL BY:
Stanley P. Chattlee 12-22-75 DATE
Ellsworth R. Chattlee 12-22-75 DATE

ALBERT A. WEBB ASSOCIATES
CIVIL ENGINEERS
RIVERSIDE, CALIFORNIA
APPROVED BY [illegible] DATE [illegible]
R.E. No. 9076
W.O. 75-231 FOR: Brattain Const. Co F.B. 1067

MARK	REVISIONS	APPR	DATE

DESIGNED BY EEC DRAWN BY [illegible] CHECKED BY [illegible]

CITY OF RIVERSIDE, CALIFORNIA
PUBLIC WORKS DEPARTMENT

APPROVED BY	BY	DATE
PRINCIPAL ENGINEER	[illegible]	[illegible]
PARK DEPARTMENT	—	—
TRAFFIC DIVISION	—	—
CHIEF PUB WKS ENGR	[illegible]	9/24

APPROVED BY [illegible]
DIRECTOR OF PUBLIC WORKS
DATE

TRACT NO. 5486-1
CITY PARTICIPATION
LINCOLN AVENUE

SCALE: HORIZ: 1"=40' ; VERT: 1"=4'

INDEXED W.M.
ACCOUNT No 30-575-310-07
DRAWING NUMBER
R-1860-A
SHEET 1 OF 2

ADAPTED FROM PLAN R-1860