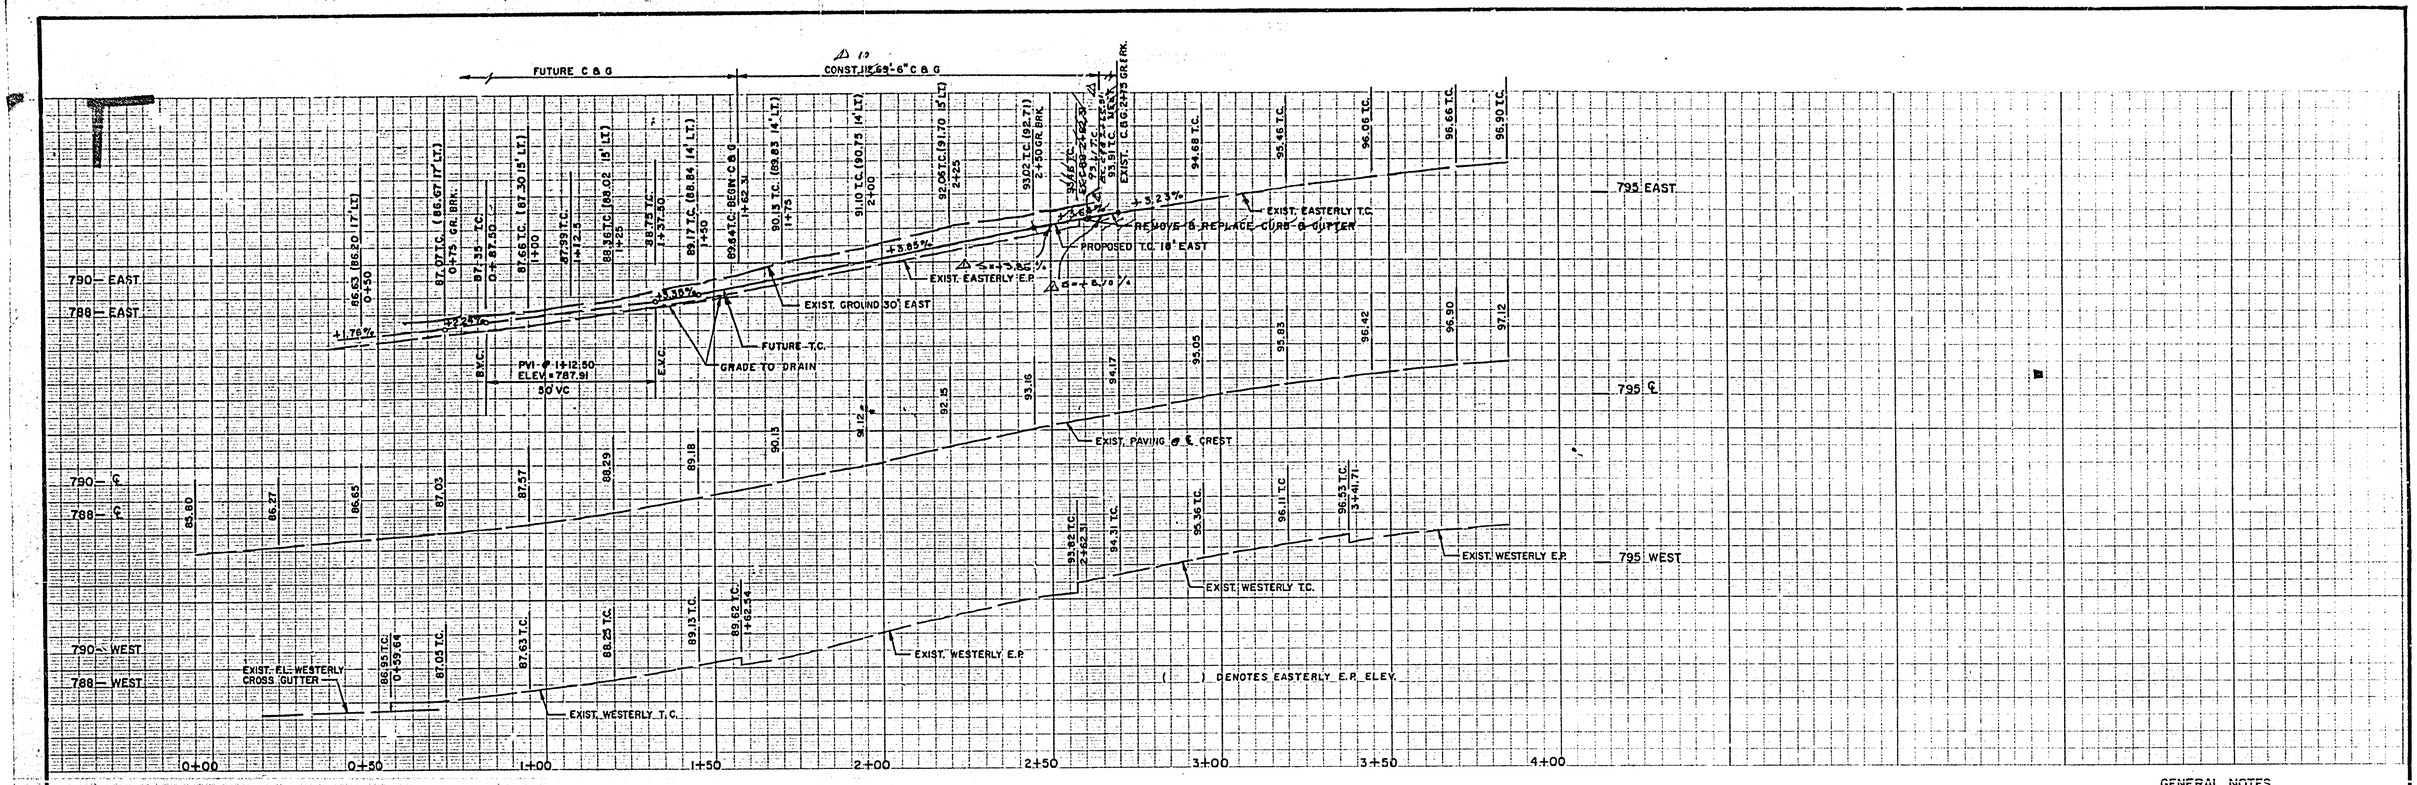

NOTE: P.K. NAIL AND TAG IN CENTER ON N.W. CURB RETURN AT TYLER AND CAMPBELL, F.B. 739/60. ELEV. = 780.14

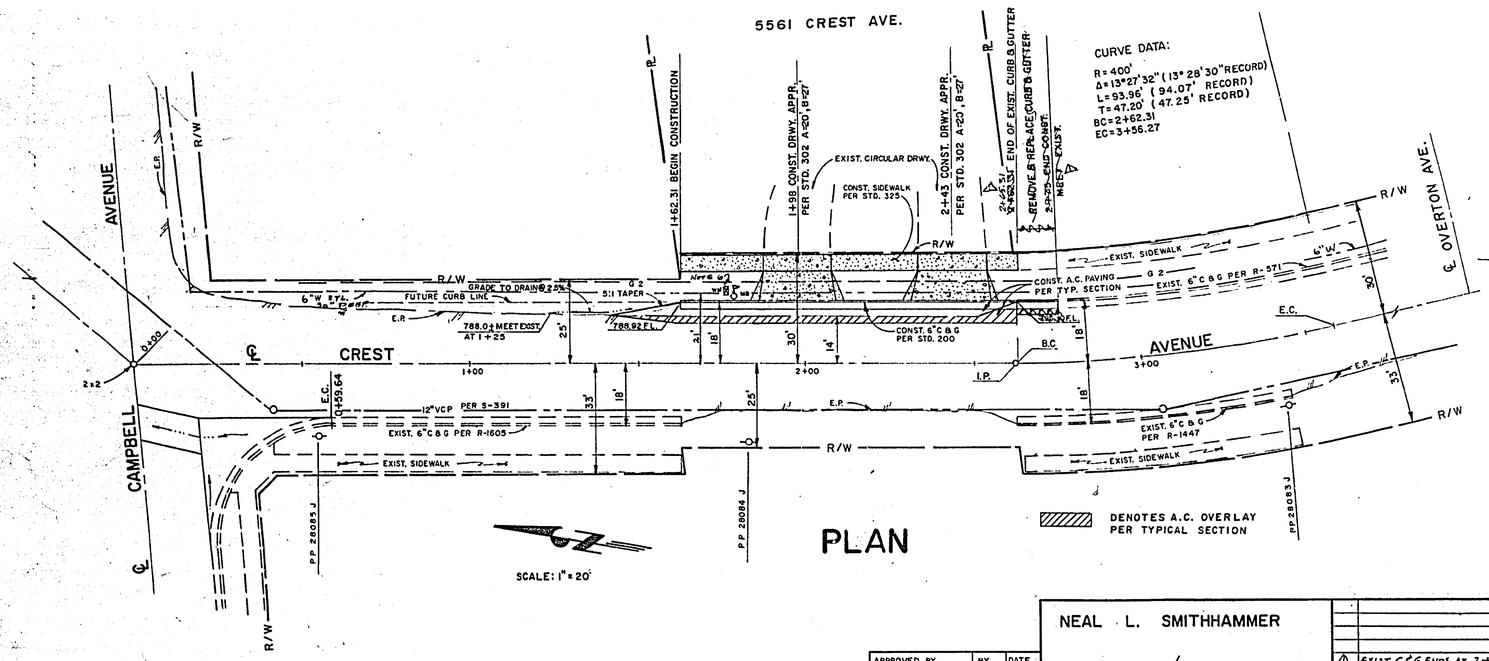

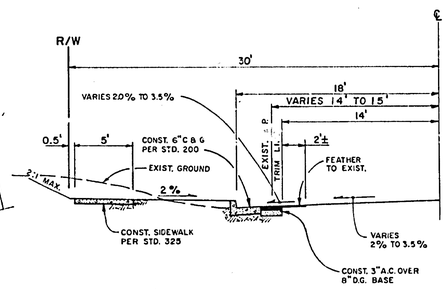

TYPICAL SECTION
CREST AVENUE
NO SCALE
TI = 5

GENERAL NOTES

1. IT SHALL BE THE RESPONSIBILITY OF THE CONTRACTOR TO CLEAR THE RIGHT OF WAY IN ACCORDANCE WITH THE PROVISIONS OF LAW AS IT AFFECTS EACH UTILITY INCLUDING IRRIGATION LINES AND APPURTENANCES AND AT NO COST TO THE CITY.
2. CONSTRUCTION SHALL BE IN ACCORDANCE WITH THE CITY OF RIVERSIDE, DEPT. OF PUBLIC WORKS, STANDARD DRAWINGS, AND THE STANDARD SPECIFICATIONS FOR PUBLIC WORKS CONSTRUCTION, 1973 EDITION.
3. TRIM EDGE OF EXISTING PAVEMENT WHERE NEW PAVEMENT JOINS TO A SMOOTH, STRAIGHT LINE. CONSTRUCT MATCH-UP PAVING AS SHOWN ON PLAN AND OVERLAY PAVING AS DIRECTED IN THE FIELD TO PRODUCE A SMOOTH SECTION. ENGINEER ESTIMATES OVERLAY TO BE 1.5 TONS.
4. CURB AND GUTTER SHALL BE STAKED WITH 3' OFFSETS AT 25' INTERVALS.
5. ALL FLAGGED ELEVATIONS SHALL BE STAKED IN THE FIELD BY THE PRIVATE ENGINEER.
6. PUBLIC UTILITIES WILL ADJUST WATER FACILITIES TO NEW GRADE.

APPROVED BY	BY	DATE
PUBLIC UTILITIES		
WATER DIVISION		
ELECTRICAL DIVISION		

NEAL L. SMITHHAMMER
APPROVED BY Neal L. Smithhammer DATE 14 JUN 76
R.E. No. 16757
W.O. FOR: PAUL DEGENEFFE F.B.

MARK	REVISIONS	APPR.	DATE
1	EXIST. C & G ENDS AT 2+62.31, NOT 2+62.31, ∴ SLOPE IS ADEQUATE. C & G NOT REQD TO BE REMOVED TO 2+75'		

DESIGNED BY ____ DRAWN BY R.A.A. CHECKED BY

CITY OF RIVERSIDE, CALIFORNIA
PUBLIC WORKS DEPARTMENT

APPROVED BY	BY	DATE
PRINCIPAL ENGINEER		
PARK DEPARTMENT		
TRAFFIC DIVISION		
CHIEF PUB. WKS. ENGR.		

APPROVED BY
DIRECTOR OF PUBLIC WORKS
DATE 8-23-76

STREET PLAN & PROFILE
5561 CREST AVE.
162' SO. OF CAMPBELL AVE.
SCALE: HORIZ. 1" = 20' VERT. 1" = 4'

INDEXED
ACCOUNT No.
DRAWING NUMBER R-1895
SHEET 1 OF 1