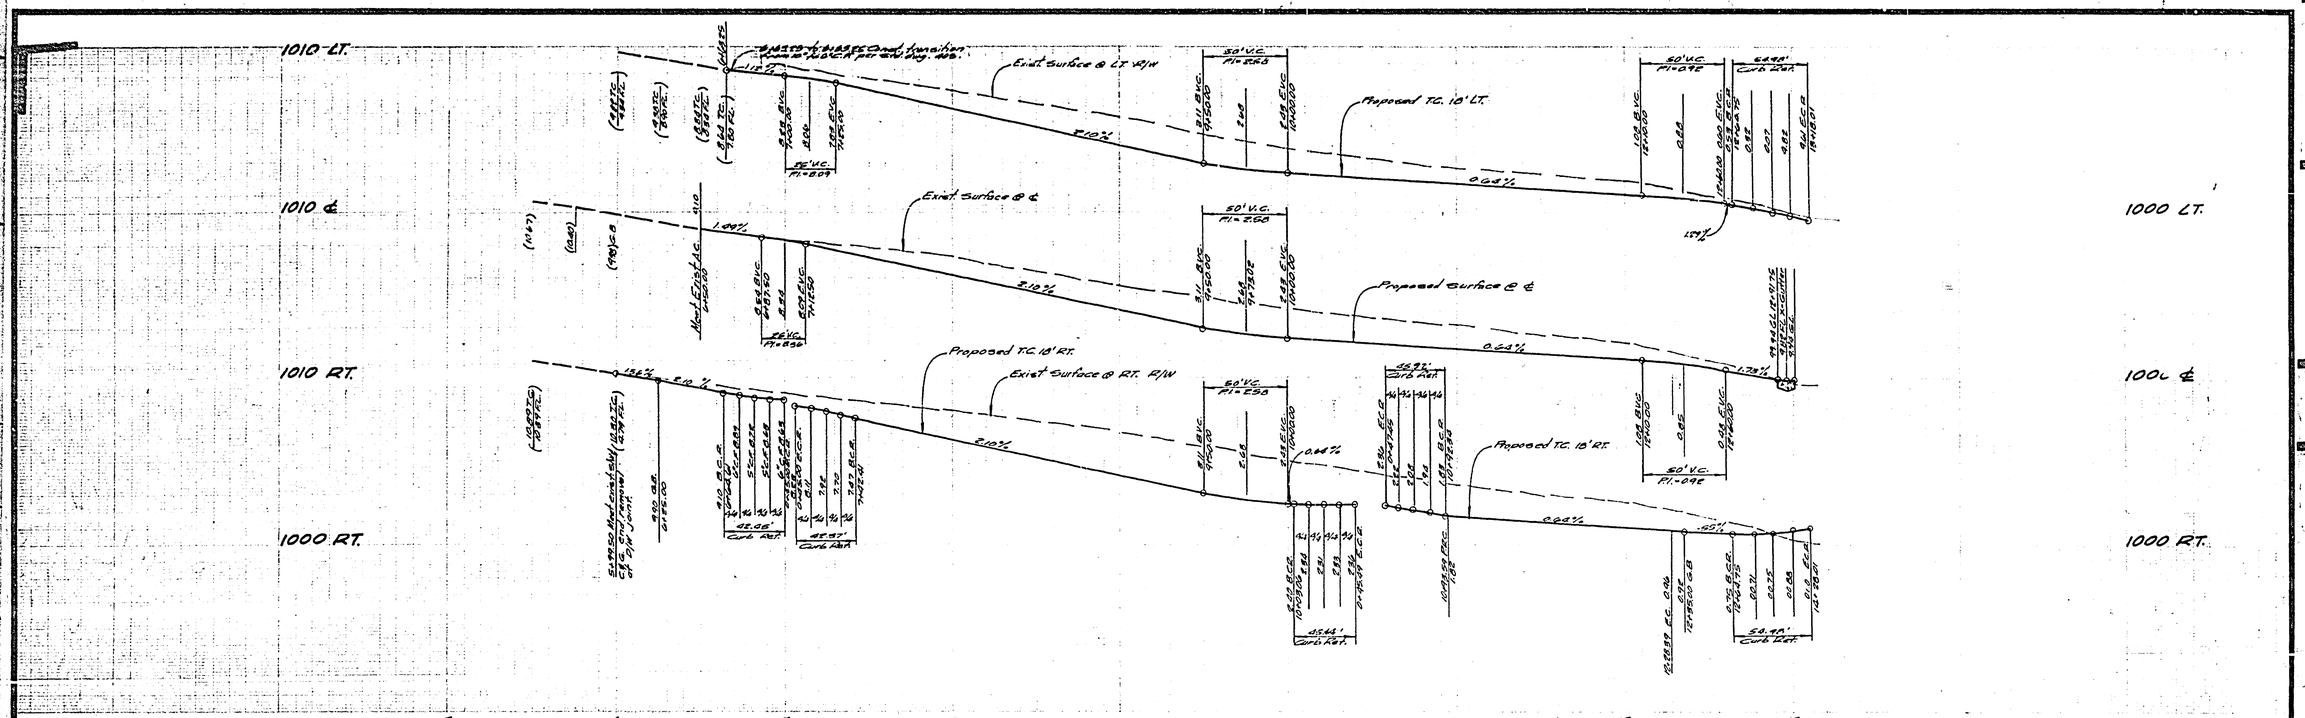

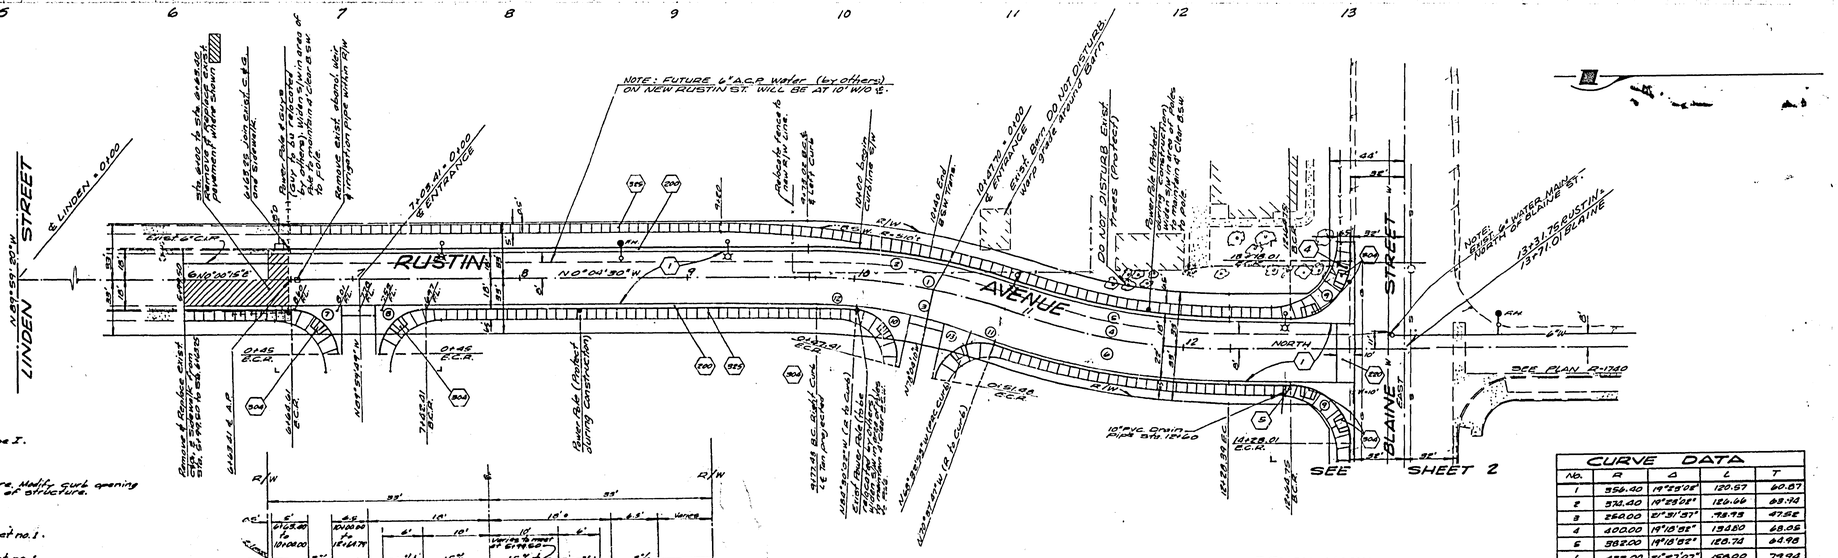

GENERAL NOTES:

1. Construction shall be in accordance with the standard specifications for Public works construction, 1975 edition and City of Riverside standard drawings.
2. It shall be the responsibility of the contractor to clear the Right of Way in accordance with the provisions of law as it affects each utility including irrigation lines and appurtenances and at no cost to the University.
3. All traffic control signs be installed prior to opening the street to traffic.
4. Curb and gutter shall be staked with 3' offsets at 25' intervals.
5. Trim edge of existing pavement where new pavement joins to a smooth straight line. Construct match-up paving as shown and overlay paving as directed in the field, to produce a smooth section. Engineer estimates overlay to be 40 tons.

CONSTRUCTION NOTES:

(200) Construct City of Riverside standard no. 200, Curb and Gutter type I.

(304) Construct City of Riverside standard no. 304, Access Ramp.

(410) Construct City of Riverside standard no. 410, Flat outlet structure. Modify curb opening to 6" (6" C.F.) use plate per std. dwg. 402. Use #3 bars @ 3" O.C. in front 2' of structure.

(325) Construct City of Riverside standard no. 325, Sidewalk.

(1) Place 2 1/2" A.C. over 6 1/2" DG Base, per Typical section on Sheet no. 1.

(2) Place 4" A.C. over 10" DG Base, per Typical section on Sheet no. 1.

(3) Overlay exist pavement per General Note no. 5. Limits shown by ———

(220) Construct City of Riverside standard no. 220 cross gutter and Aprons. Width shown at each location.

(4) "No stopping signs" Relocate in 8" Blockout

(5) R1 (Stop Sign) 30" Octagon in 12" Blockout

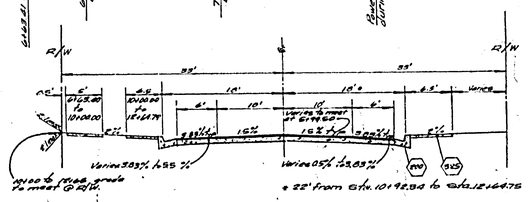

TYPICAL SECTION
RUSTIN AVENUE
T1-5

BENCH MARK:
"RK." Nail & Riverside City Engineer Tag in N.E. C/R Blaine & Canyon Crest
Elev. 1037.96 C.R.F.B. 978/44

CURVE DATA				
No.	R	Δ	L	T
1	356.40	19°25'02"	120.57	60.87
2	374.40	19°25'02"	126.66	63.94
3	250.00	21°31'37"	93.93	47.52
4	400.00	19°18'32"	134.80	68.05
5	382.00	19°18'32"	128.74	64.98
6	422.00	21°27'07"	158.00	79.94
7	27.00	90°04'41"	42.46	27.04
8	27.00	89°55'19"	42.37	27.96
9	35.00	90°00'00"	54.97	40.00
10	27.00	96°25'52"	45.44	30.21
11	422.00	02°01'34"	14.96	7.48
12	250.00	05°34'28"	24.32	12.17
13	27.00	97°26'23"	45.92	30.75

ALBERT A. WEBB ASSOCIATES
CIVIL ENGINEERS
RIVERSIDE, CALIFORNIA
APPROVED BY [signature] DATE 4-2-76
R.E. No. 21884
W.O. 76-14 FOR: UCR/CITY OF RIVERSIDE F.B. 1017

MARK	REVISIONS	APPR.	DATE

DESIGNED BY BS DRAWN BY BS/RP CHECKED BY

CITY OF RIVERSIDE, CALIFORNIA
PUBLIC WORKS DEPARTMENT

APPROVED BY	BY	DATE
PRINCIPAL ENGINEER	[signature]	9/2/76
PARK DEPARTMENT	[signature]	
TRAFFIC DIVISION	[signature]	8/25
CHIEF PUB. WKS. ENGR.		

APPROVED BY [signature]
DIRECTOR OF PUBLIC WORKS
DATE 9/1/76

STREET PLAN AND PROFILE
UCR/CITY ATHLETIC COMPLEX, PHASE I
PROJECT No. 958800-A
RUSTIN AVENUE
663' N'LY OF LINDEN TO BLAINE
SCALE: HORZ. 1" = 40' VERT 1" = 4'

INDEXED
ACCOUNT No. 31-532-471
DRAWING NUMBER
R-1897
SHEET 1 OF 2
76-14A

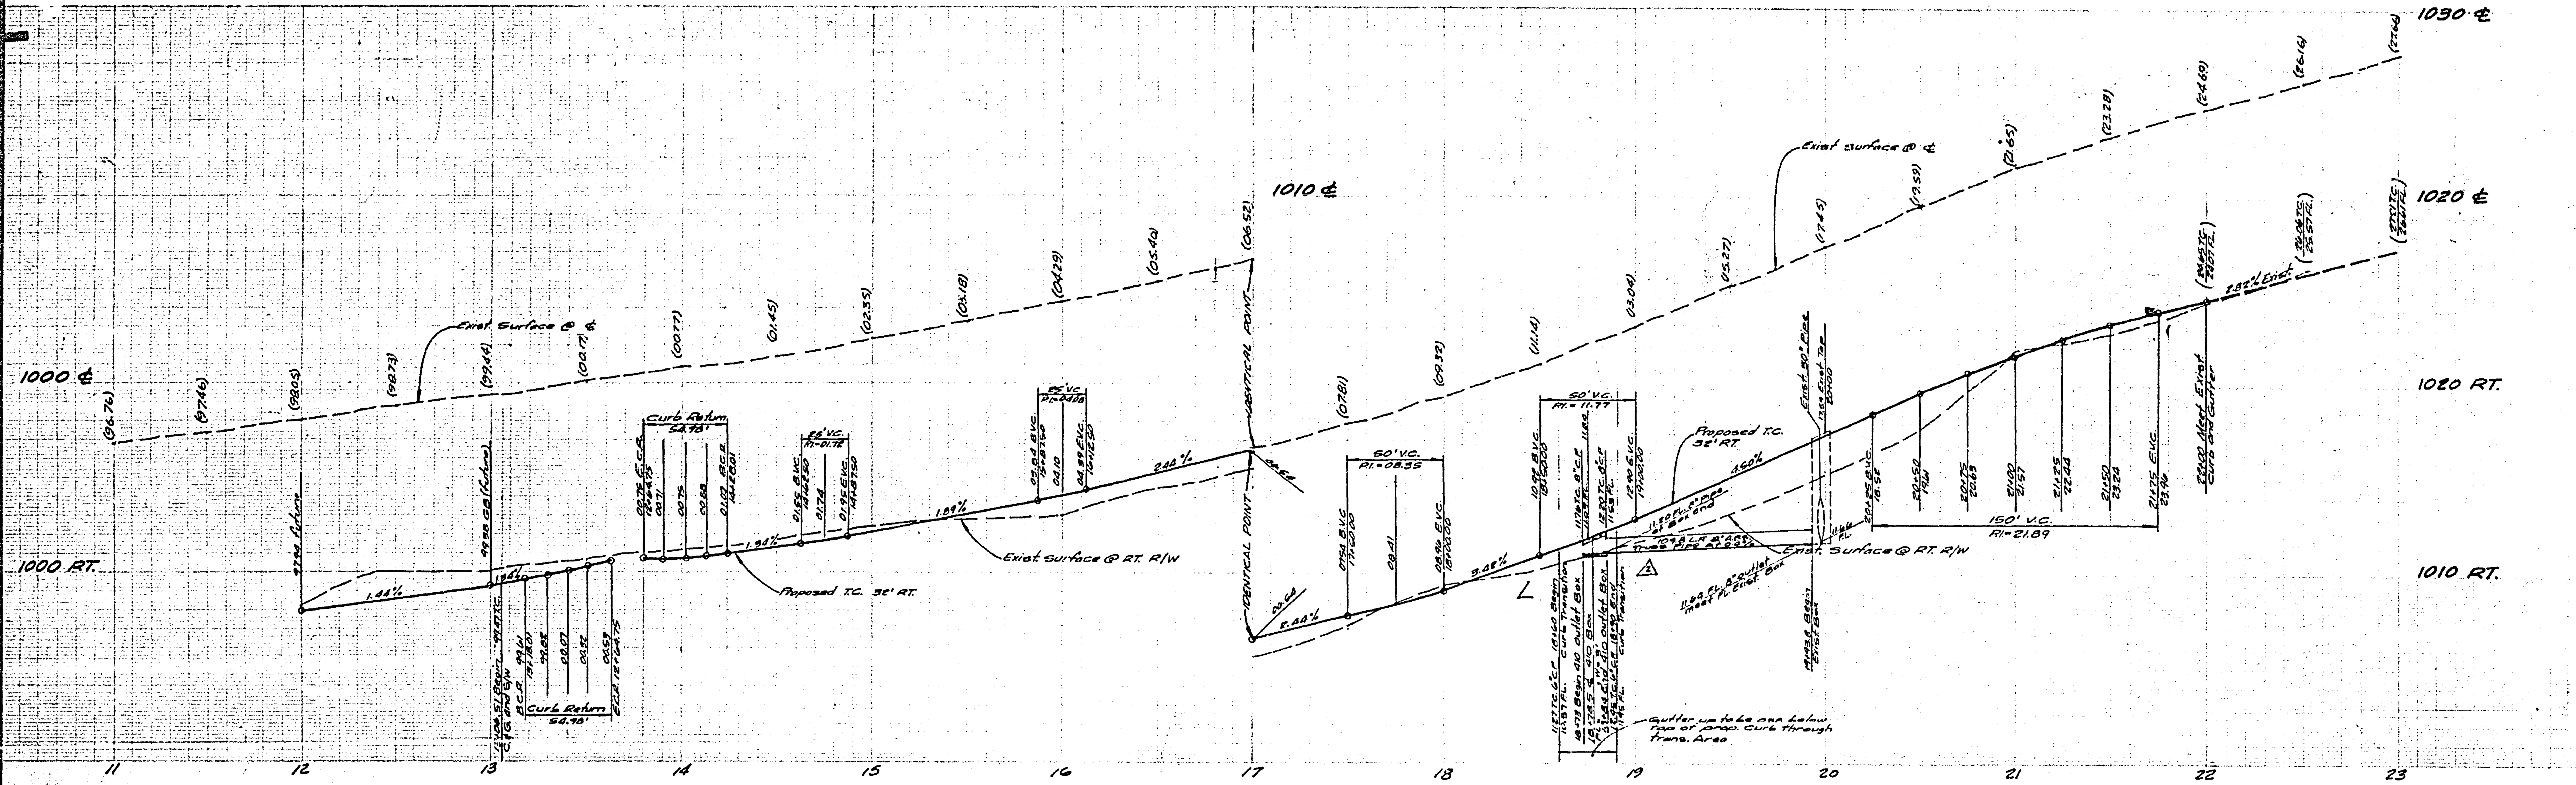

BENCH MARK:

"PK" Nail & Riverside City Engineer Tag in N.E. C/R Blaine & Canyon Crest
Elev. 1037.96 C.R.F.B. 973/44

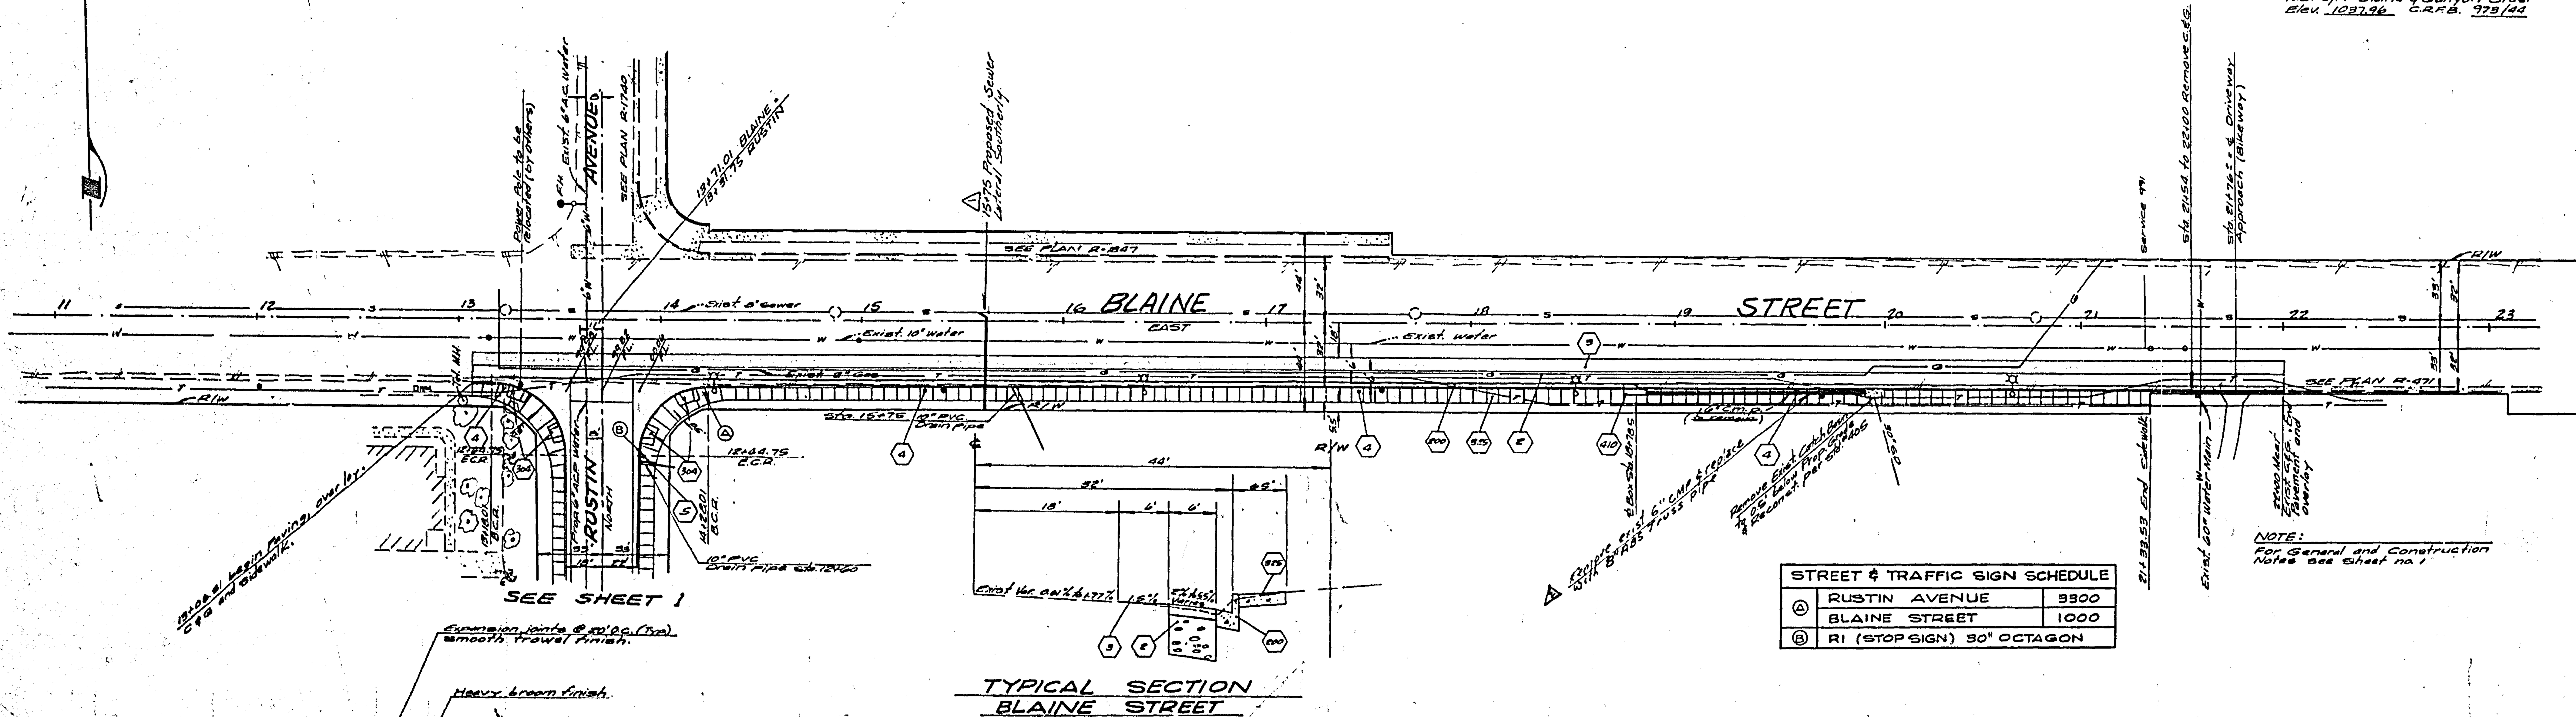

TYPICAL SECTION
BLAINE STREET

NOTE:
For General and Construction Notes see Sheet no. 1

STREET & TRAFFIC SIGN SCHEDULE		
Ⓐ	RUSTIN AVENUE	3300
	BLAINE STREET	1000
Ⓑ	R1 (STOP SIGN) 30" OCTAGON	

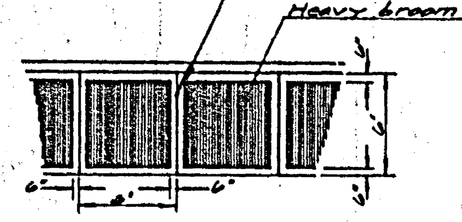

PLAN VIEW
CONCRETE WALK
NO SCALE

ALBERT A. WEBB ASSOCIATES
CIVIL ENGINEERS
RIVERSIDE, CALIFORNIA
APPROVED BY [signature] DATE 4-7-76
R.E. No. 21884
W.O. 76-14 FOR: UCR / CITY OF RIVERSIDE F.B. 1017

MARK	REVISIONS	APPR.	DATE
1	Added prop. sewer lateral BE 11-22-76		11/22/76
2	Added 8" bleeder pipe BE 1-5-77		1/7/77

DESIGNED BY BE DRAWN BY BE/RP CHECKED BY

CITY OF RIVERSIDE, CALIFORNIA
PUBLIC WORKS DEPARTMENT

APPROVED BY	BY	DATE
PRINCIPAL ENGINEER		8/25
PARK DEPARTMENT	—	—
TRAFFIC DIVISION		8/26
CHIEF PUB. WKS. ENGR.		

APPROVED BY [signature]
DIRECTOR OF PUBLIC WORKS
DATE 9/1/76

STREET PLAN AND PROFILE
UCR/CITY ATHLETIC COMPLEX, PHASE I
PROJECT No. 958800-A
BLAINE STREET
RUSTIN AVE. TO 786' EAST
SCALE: HORZ 1" = 40' VERT 1" = 4'

INDEXED
ACCOUNT No. 51-532-471
DRAWING NUMBER
R-1897
SHEET 2 OF 2
76-14A